


27

618-0-14



27

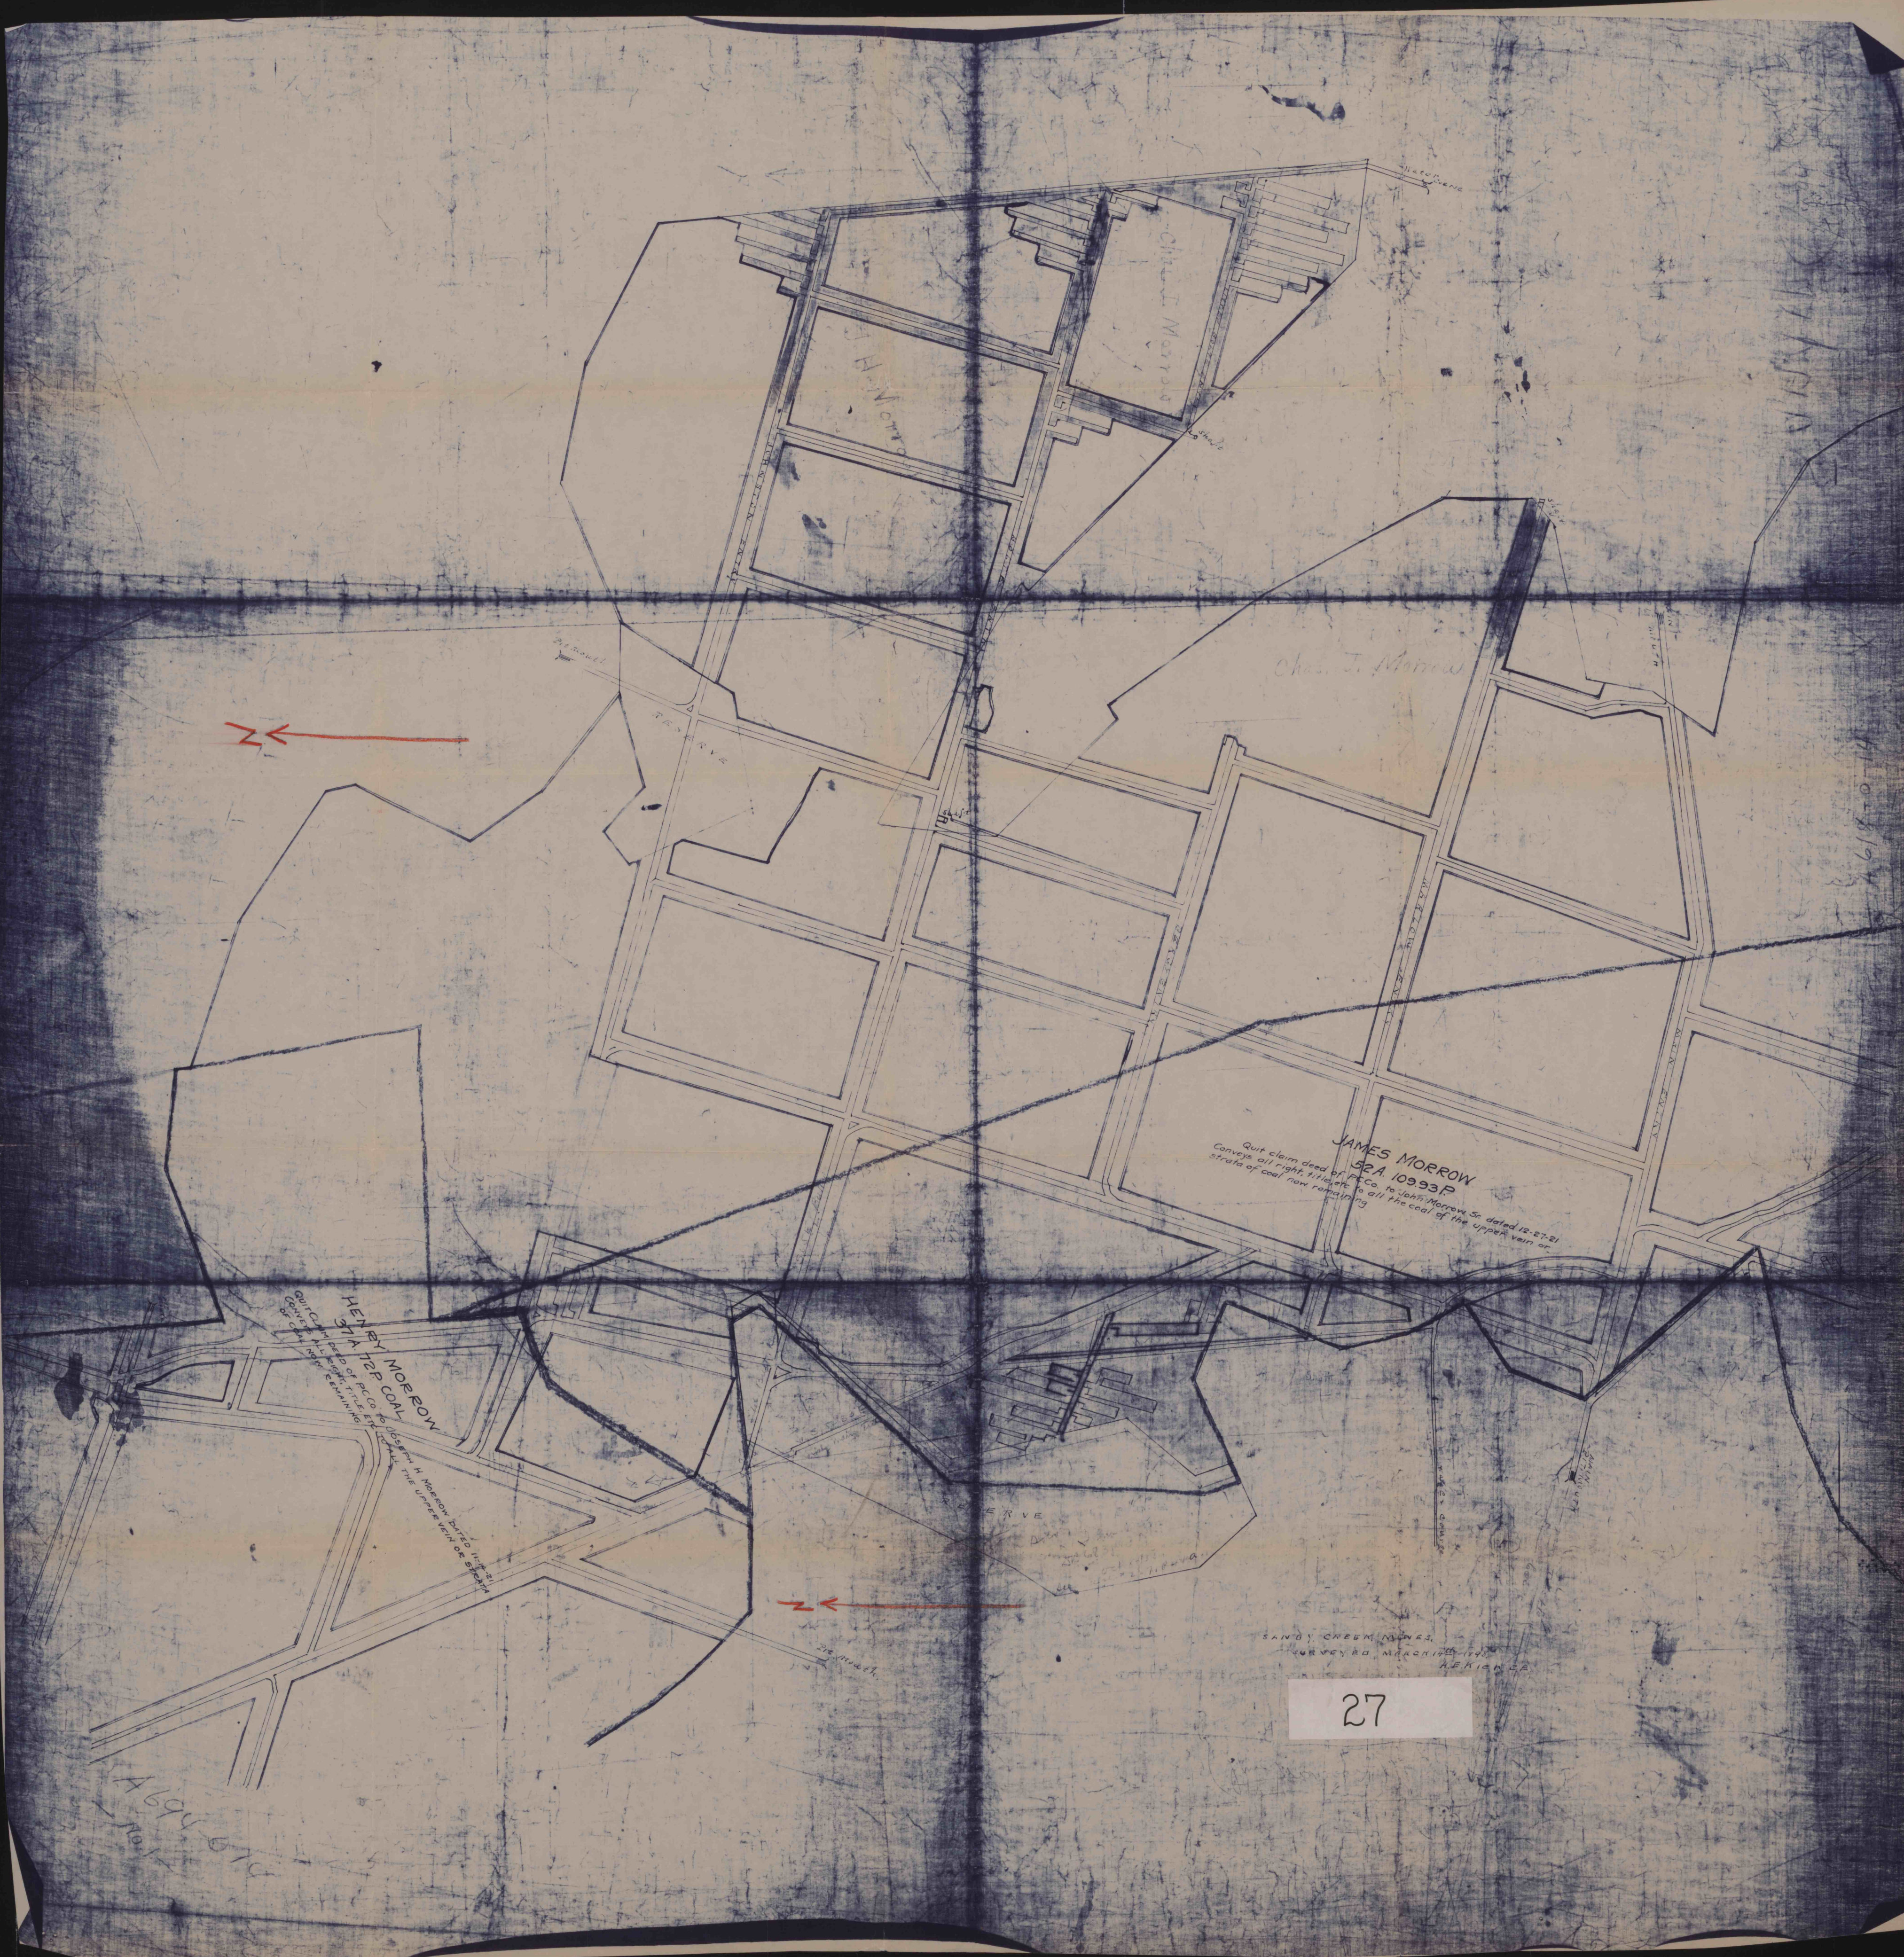

HENRY MORROW
37A 12P COAL

JAMES MORROW
52A 10993P
Quit claim deed of J.C. Co. to John Morrow Sr. dated 12-27-21
Conveys all right, title and interest to all the coal of the upper vein or strata of coal now remaining

SURVEYED MARCH 1890
REMARKS