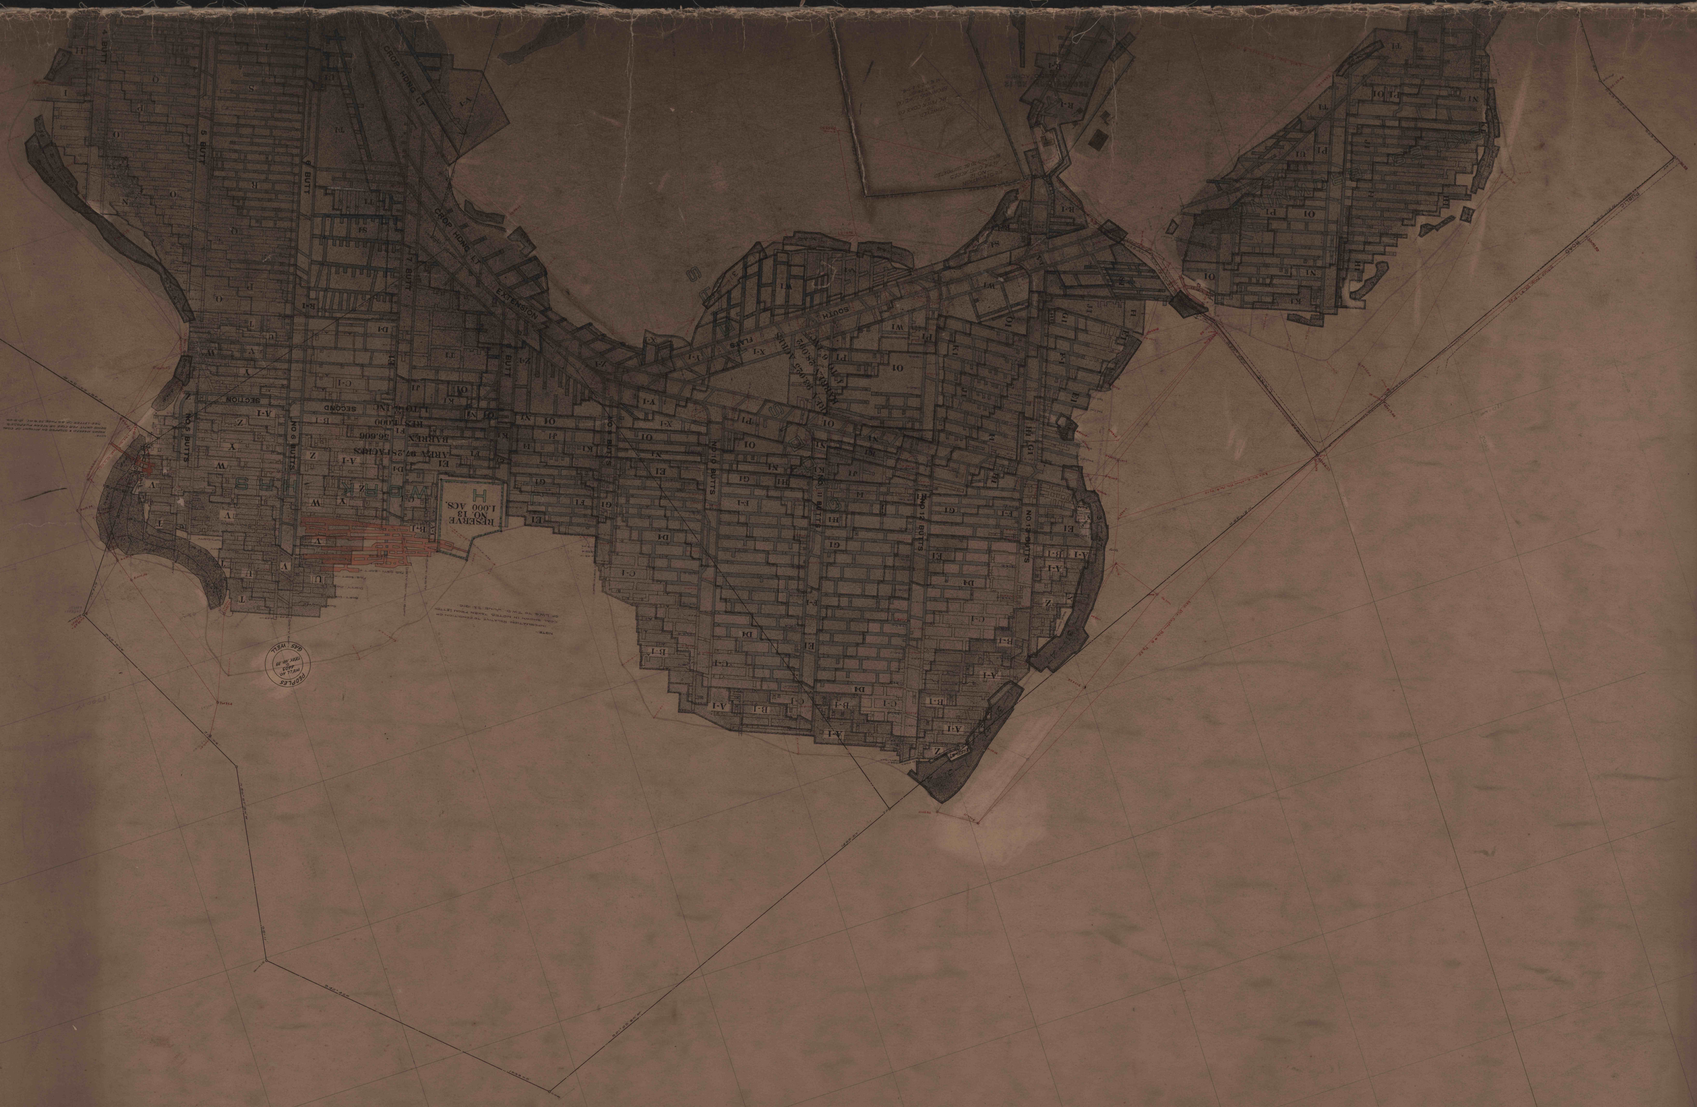
RESERVE
No. 13
1,000 ACRES
H
WATER
FRONT 27.5 FEET
BACK 36.600
HEIGHT 120 FEET
SECOND
SECTION
A-1
SOUTH
