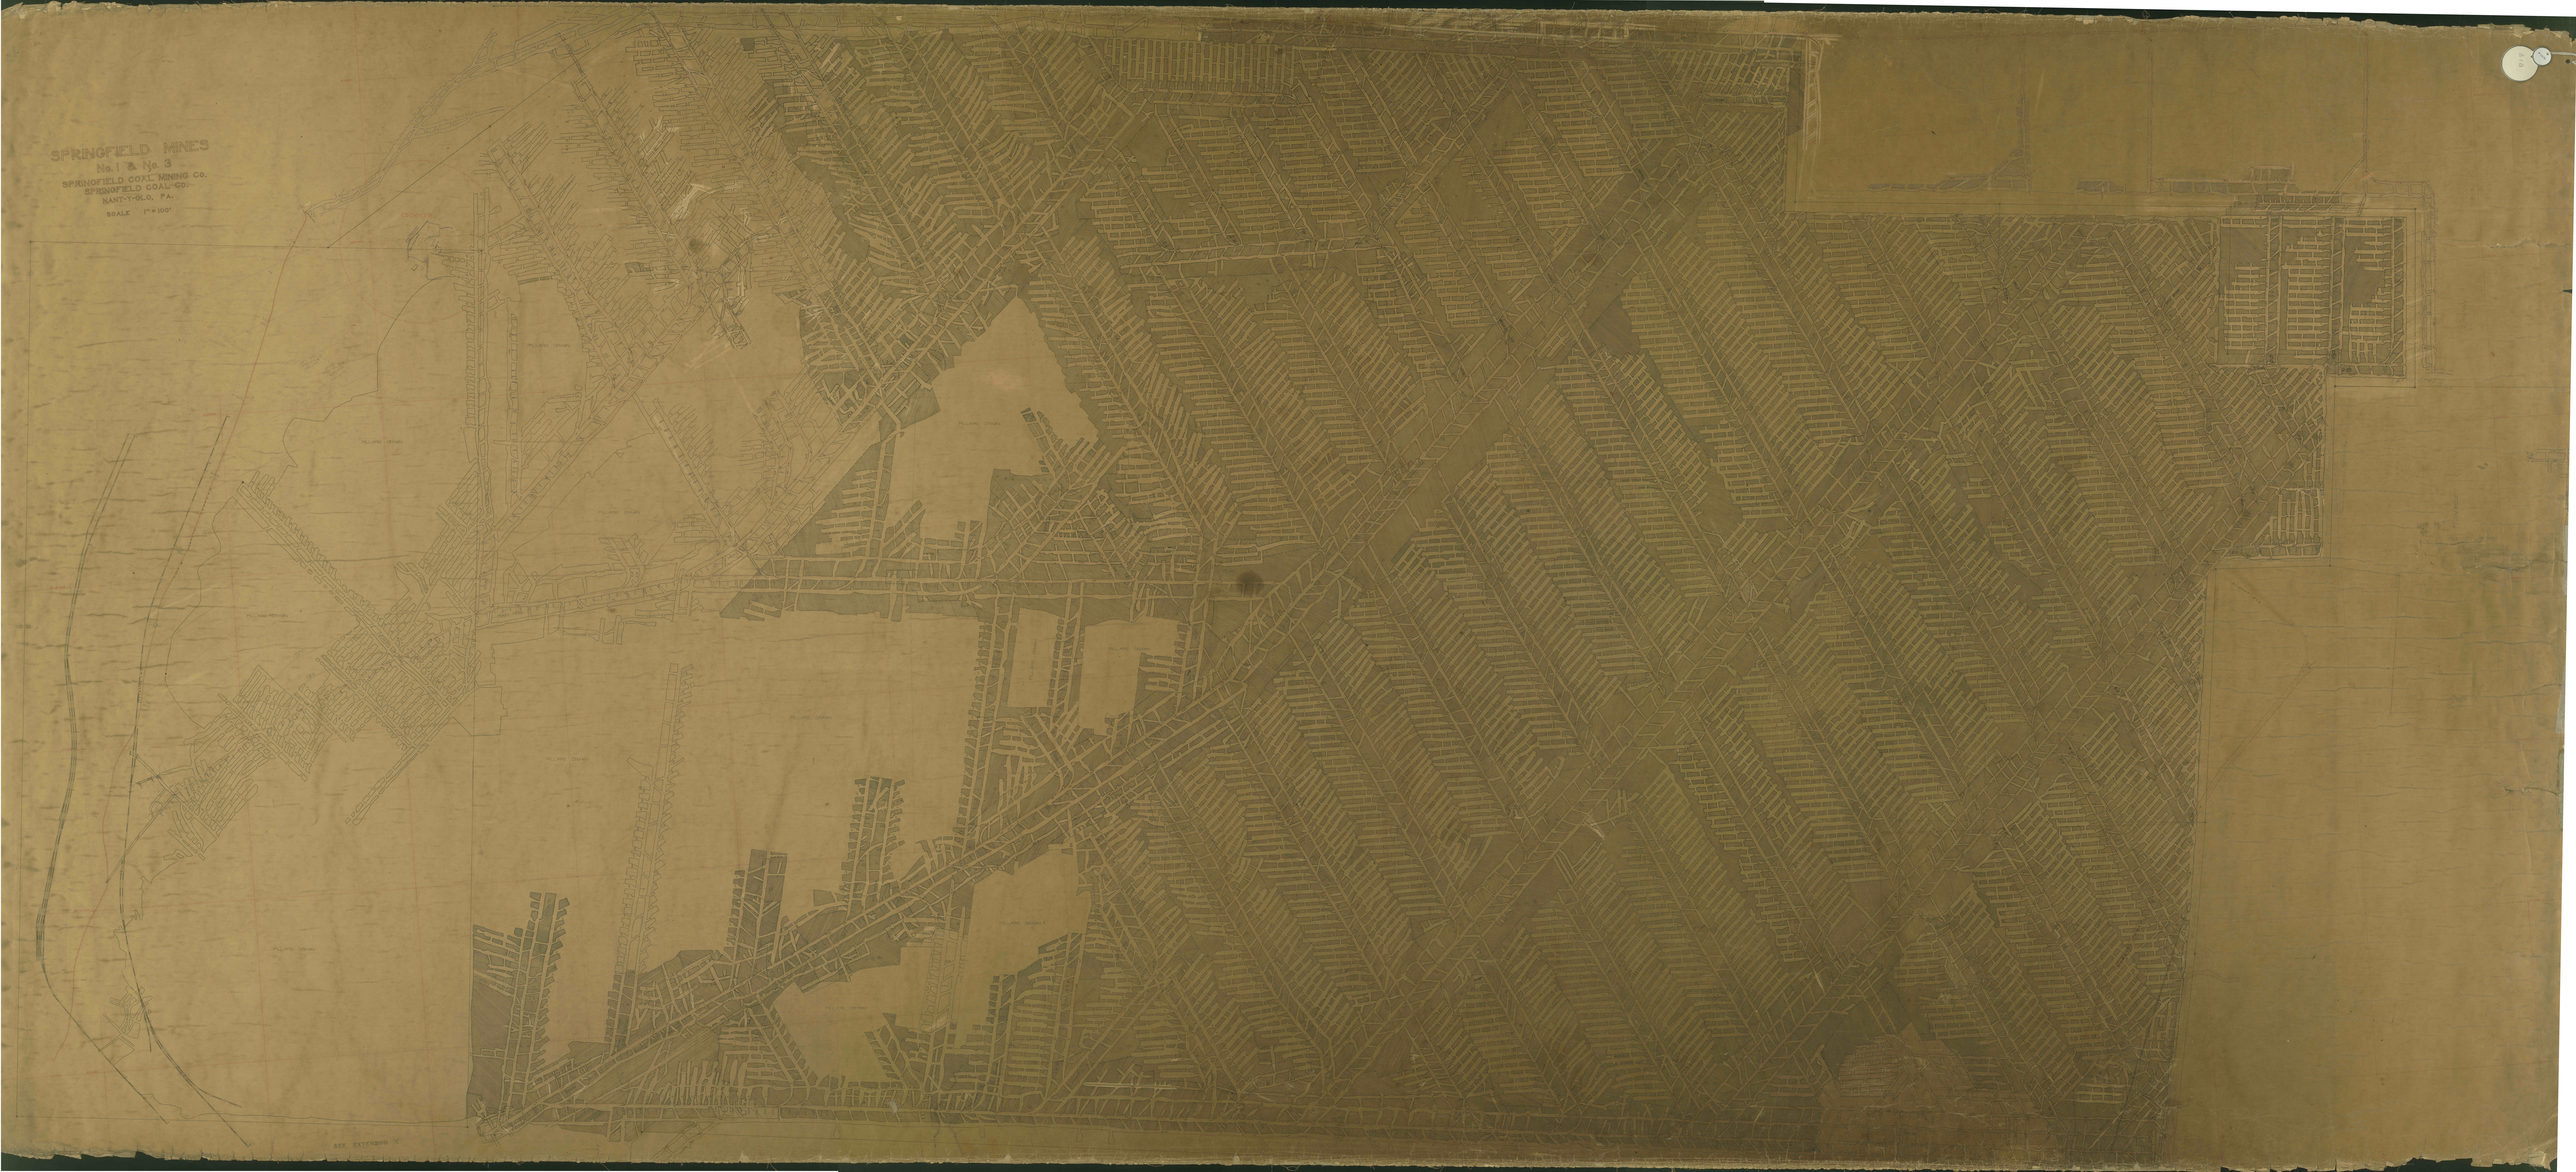
SPRINGFIELD MINES
No. 1 & No. 3
SPRINGFIELD COAL MINING Co.
SPRINGFIELD COAL CO.
NANTY-GLO, PA.
SCALE 1" = 100'
SEE EXTENSION