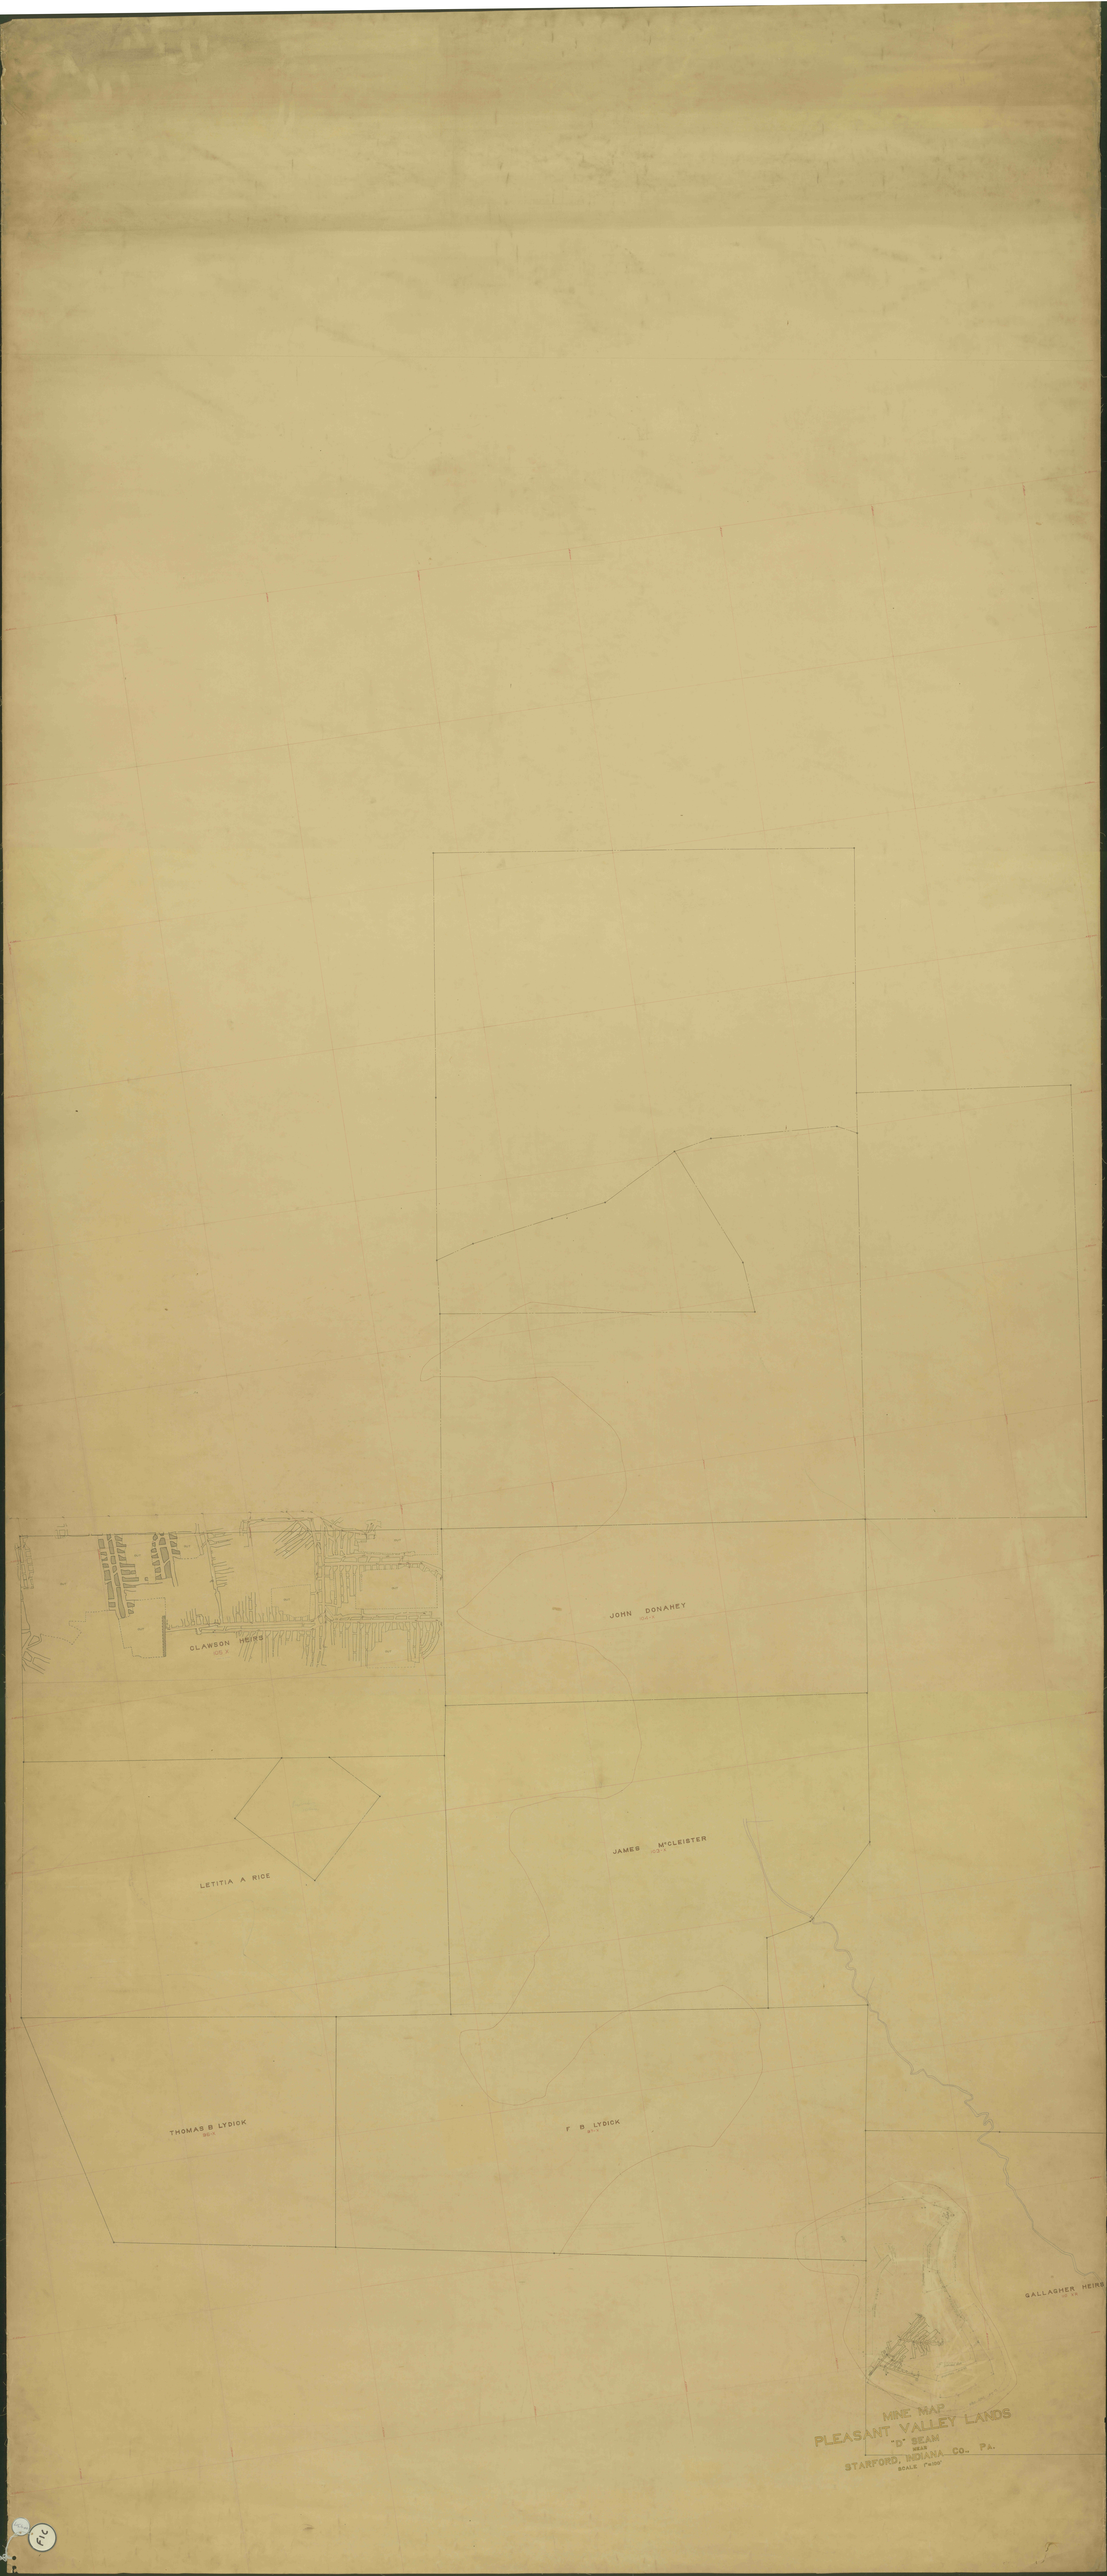
JOHN DONAHEY
CLAWSON HEIRS
JAMES McCLEISTER
LETITIA A RICE
THOMAS B LYDICK
F B LYDICK
GALLAGHER HEIRS
MINE MAP
PLEASANT VALLEY LANDS
"D" SEAM
STARFORD, INDIANA Co., Pa.
SCALE 1"=100'