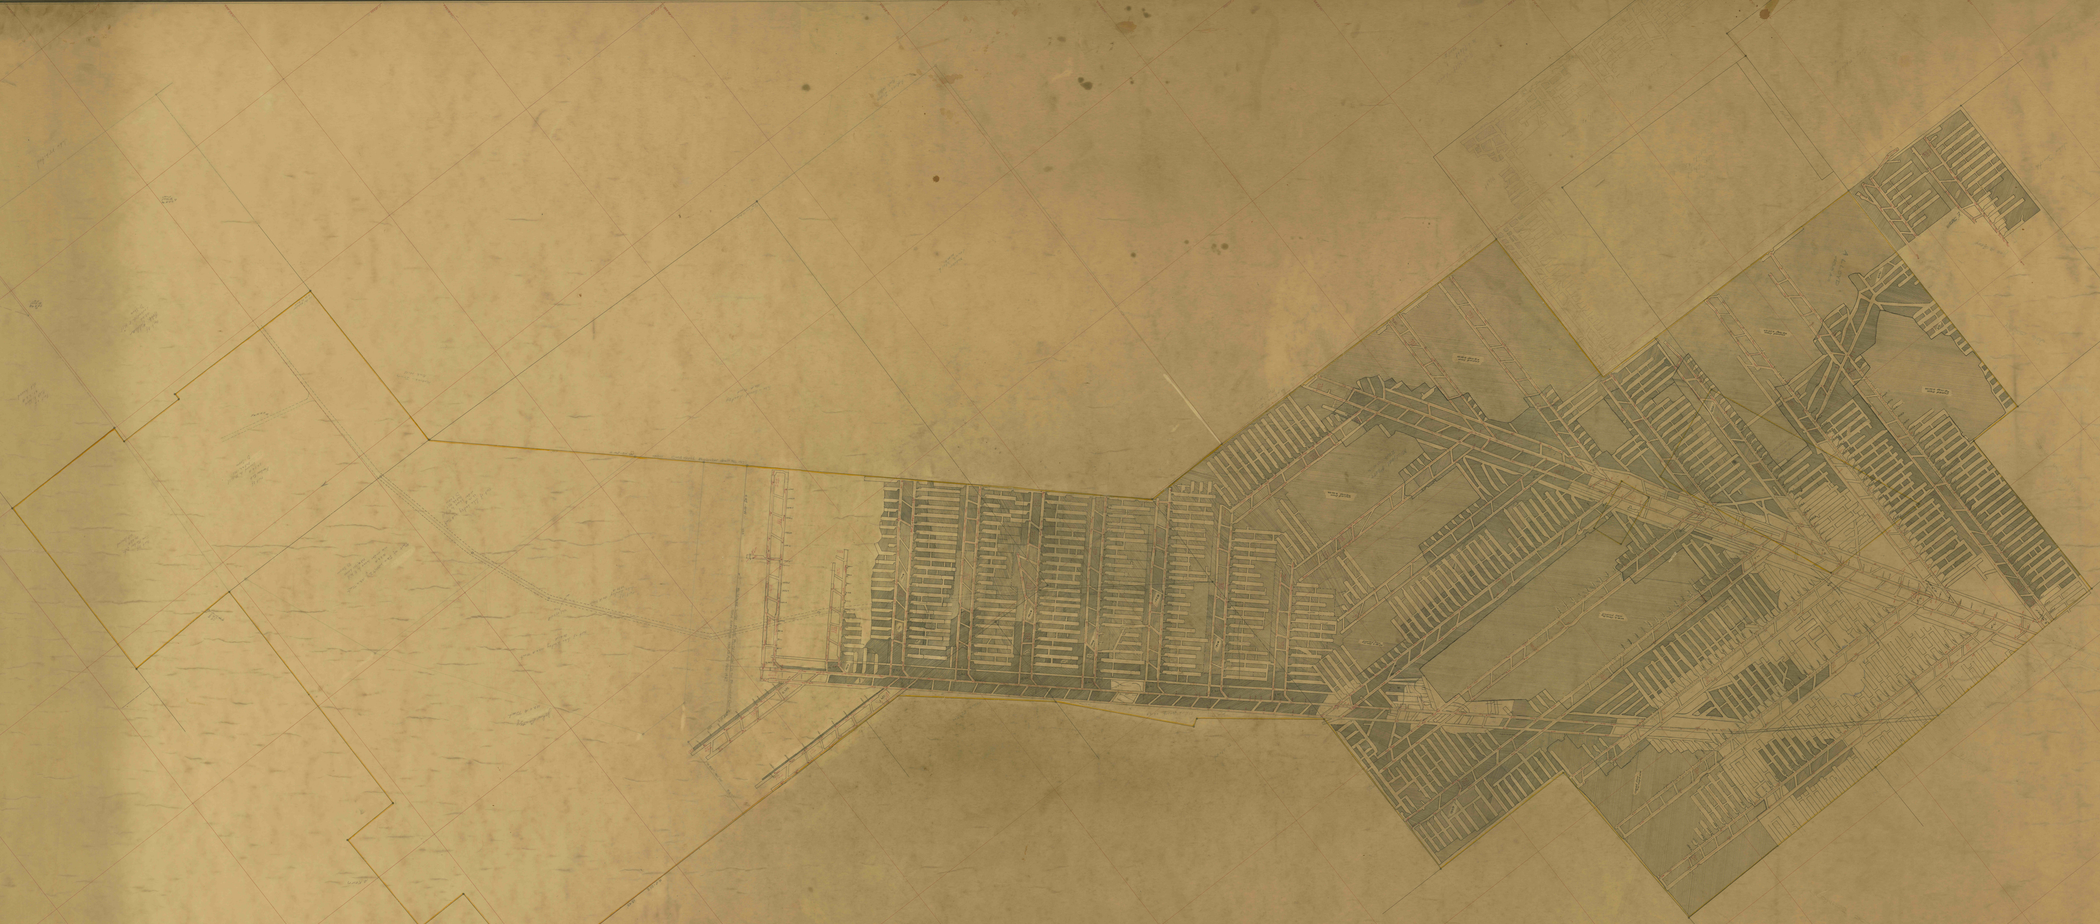

PORTER COAL COMPANY
D SEAM BLUBAKER LEASE
B & T CO. NO. 12 MINE
BARNESBORO, CAMBRIA CO. PA.

SCALE 1"=50 FT.
B & T CO. ENGR. DEPT.