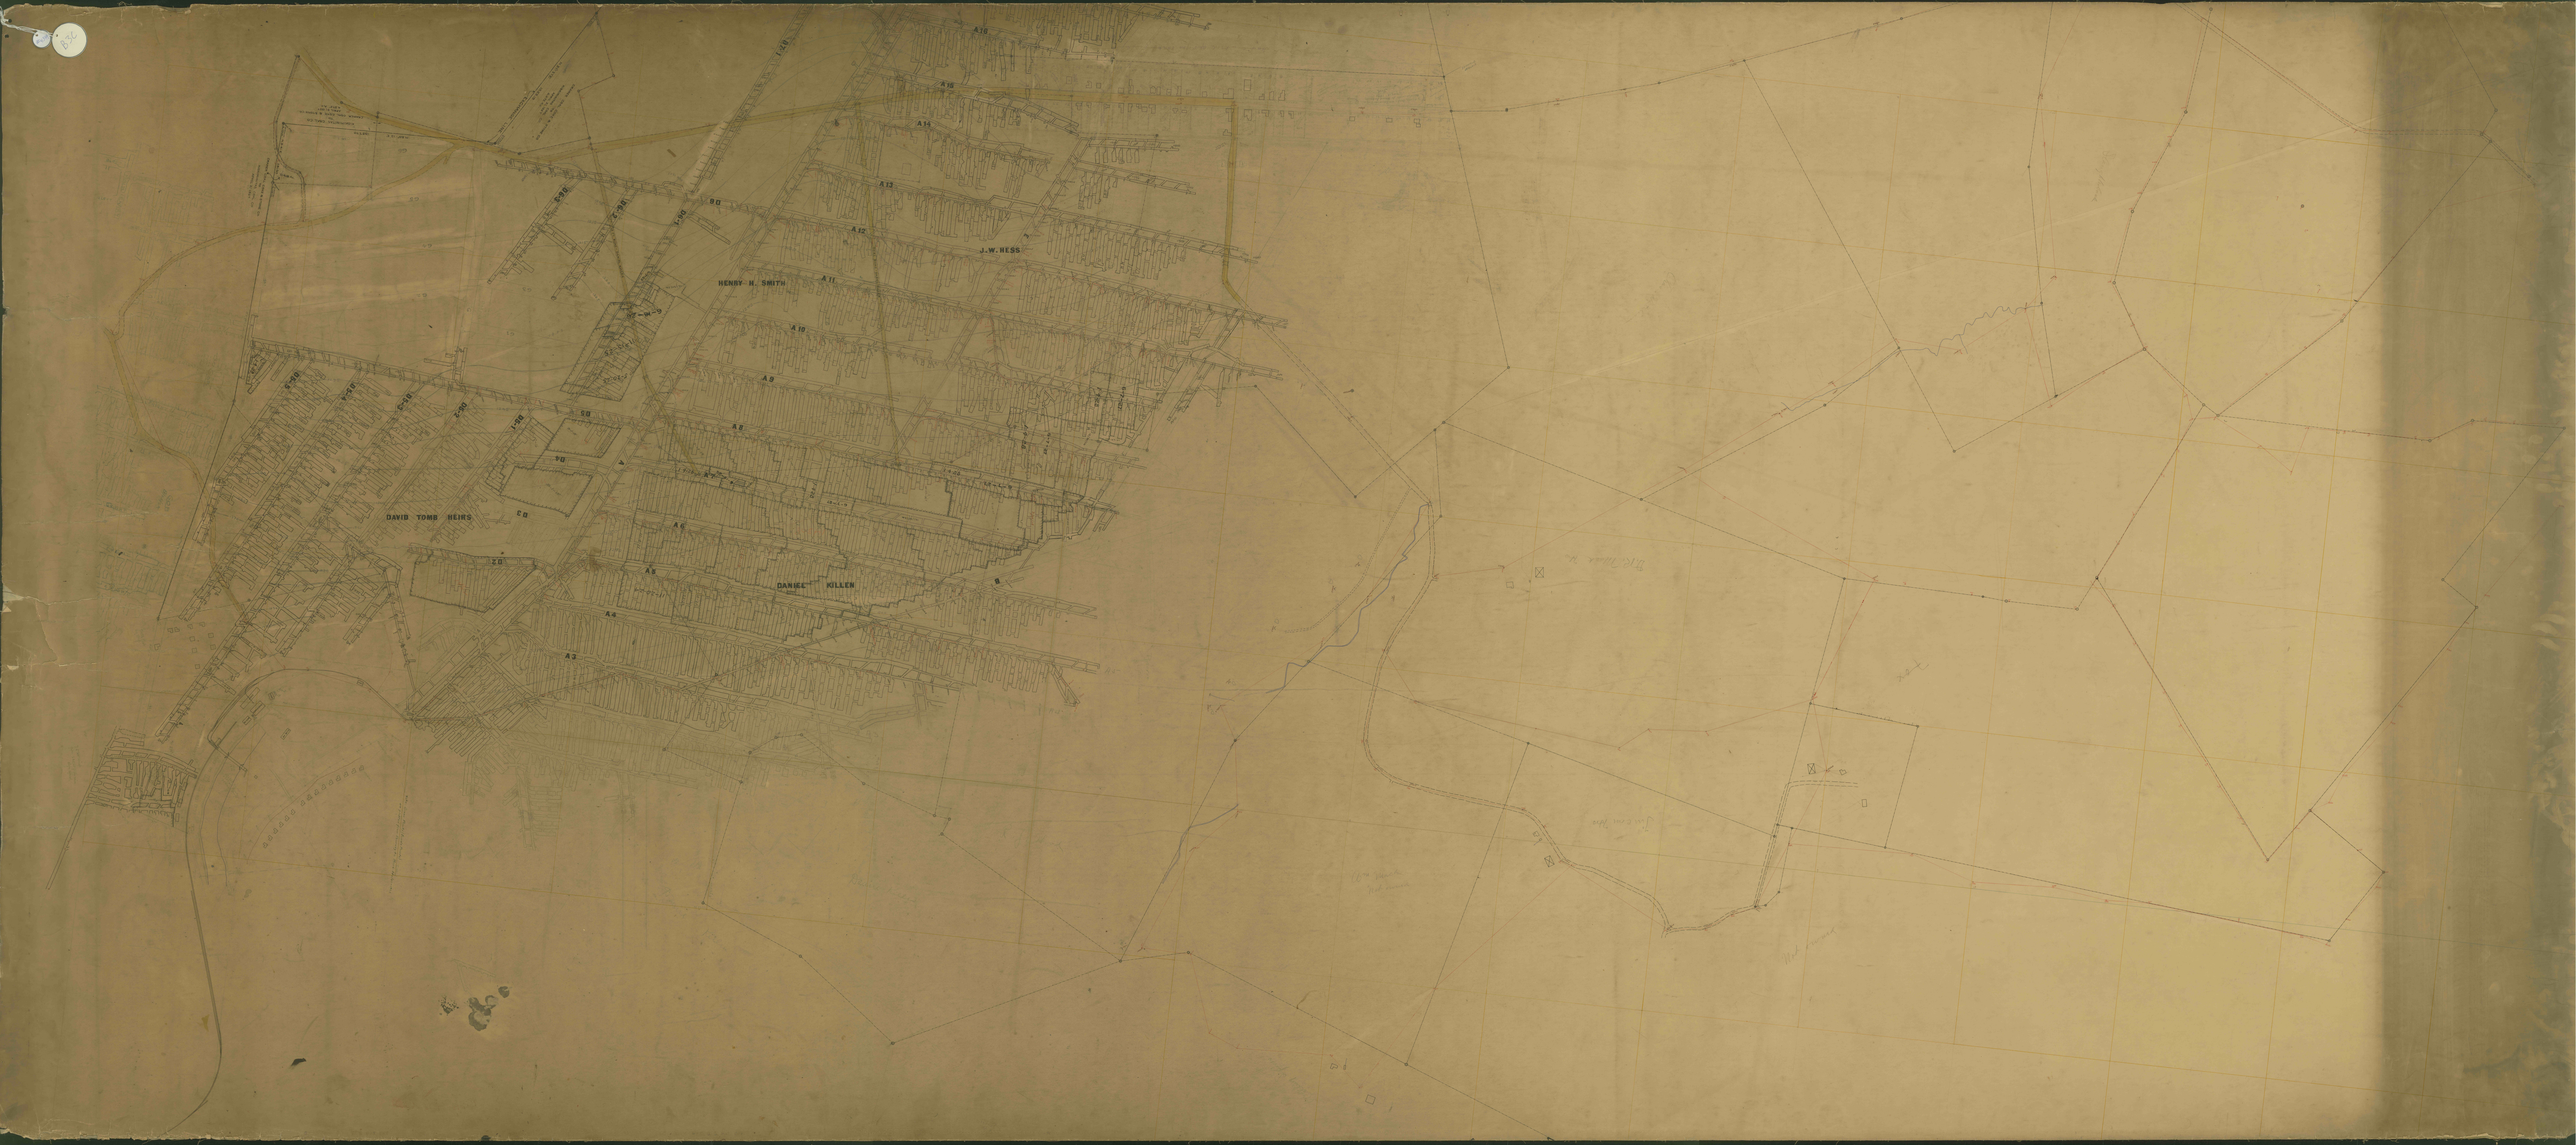

KISKIMINITAS COAL CO TO CRAMER COAL COKE & STONE CO. APRIL 21, 1927 4.375 Ac.
CRAMER COAL COKE & STONE CO TO KISKIMINITAS COAL CO. APRIL 21, 1927 6.472 Ac.
CRAMER COAL COKE & STONE CO. TO KISKIMINITAS COAL CO APRIL 21, 1927
0.418 Ac.
EXCHANGE LINE
N 31°-37' E 1053.19
N 89°-12' E 1357.70
N 3°-41' E 381.09
G4
G5
G6
D6-1
D6-2
D6-3
D5
D4
D3
D2
12 FT. ROAD - DANIEL
DAVID TOMB HEIRS
DANIEL KILLEN
HENRY H. SMITH
J. W. HESS
A
B
A3
A4
A5
A6
A8
A9
A10
A11
A12
A13
A14
A15
A16