


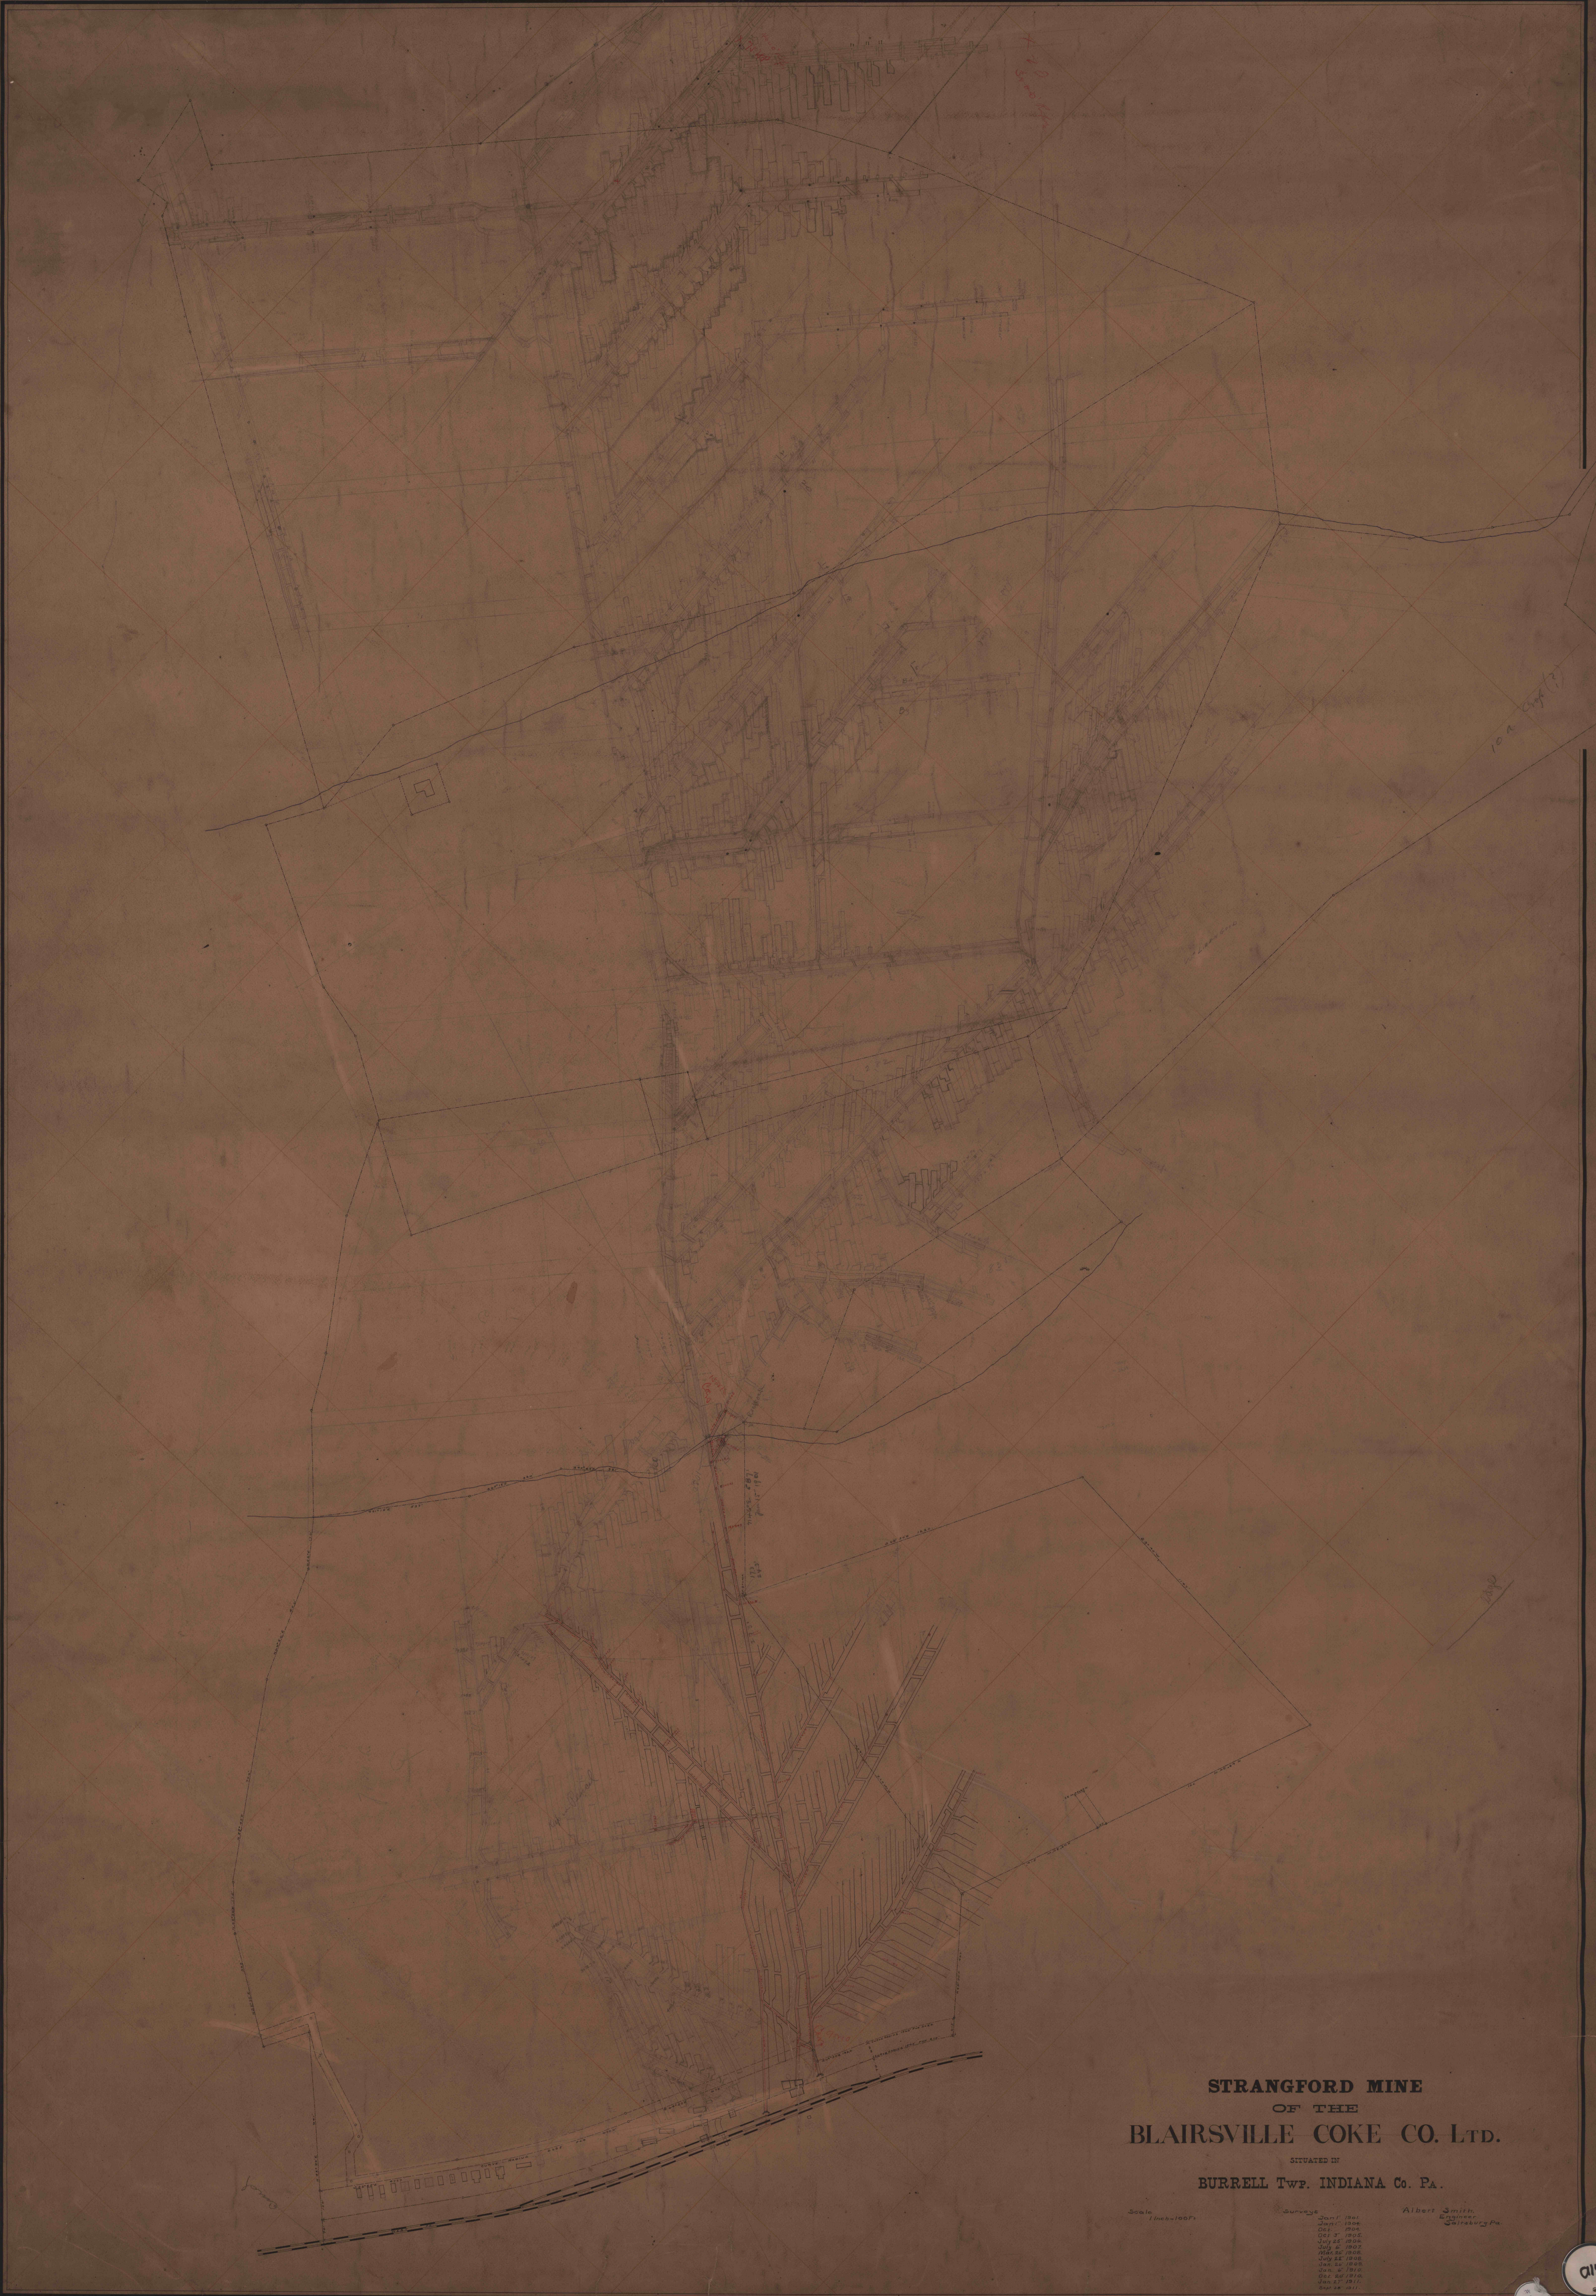

STRANGFORD MINE
OF THE
BLAIRSVILLE COKE CO. LTD.
SITUATED IN
BURRELL TWP. INDIANA Co. PA.

Scale
1 inch = 100 ft.


Albert Smith
Surveyor
Blairsville, Pa.