


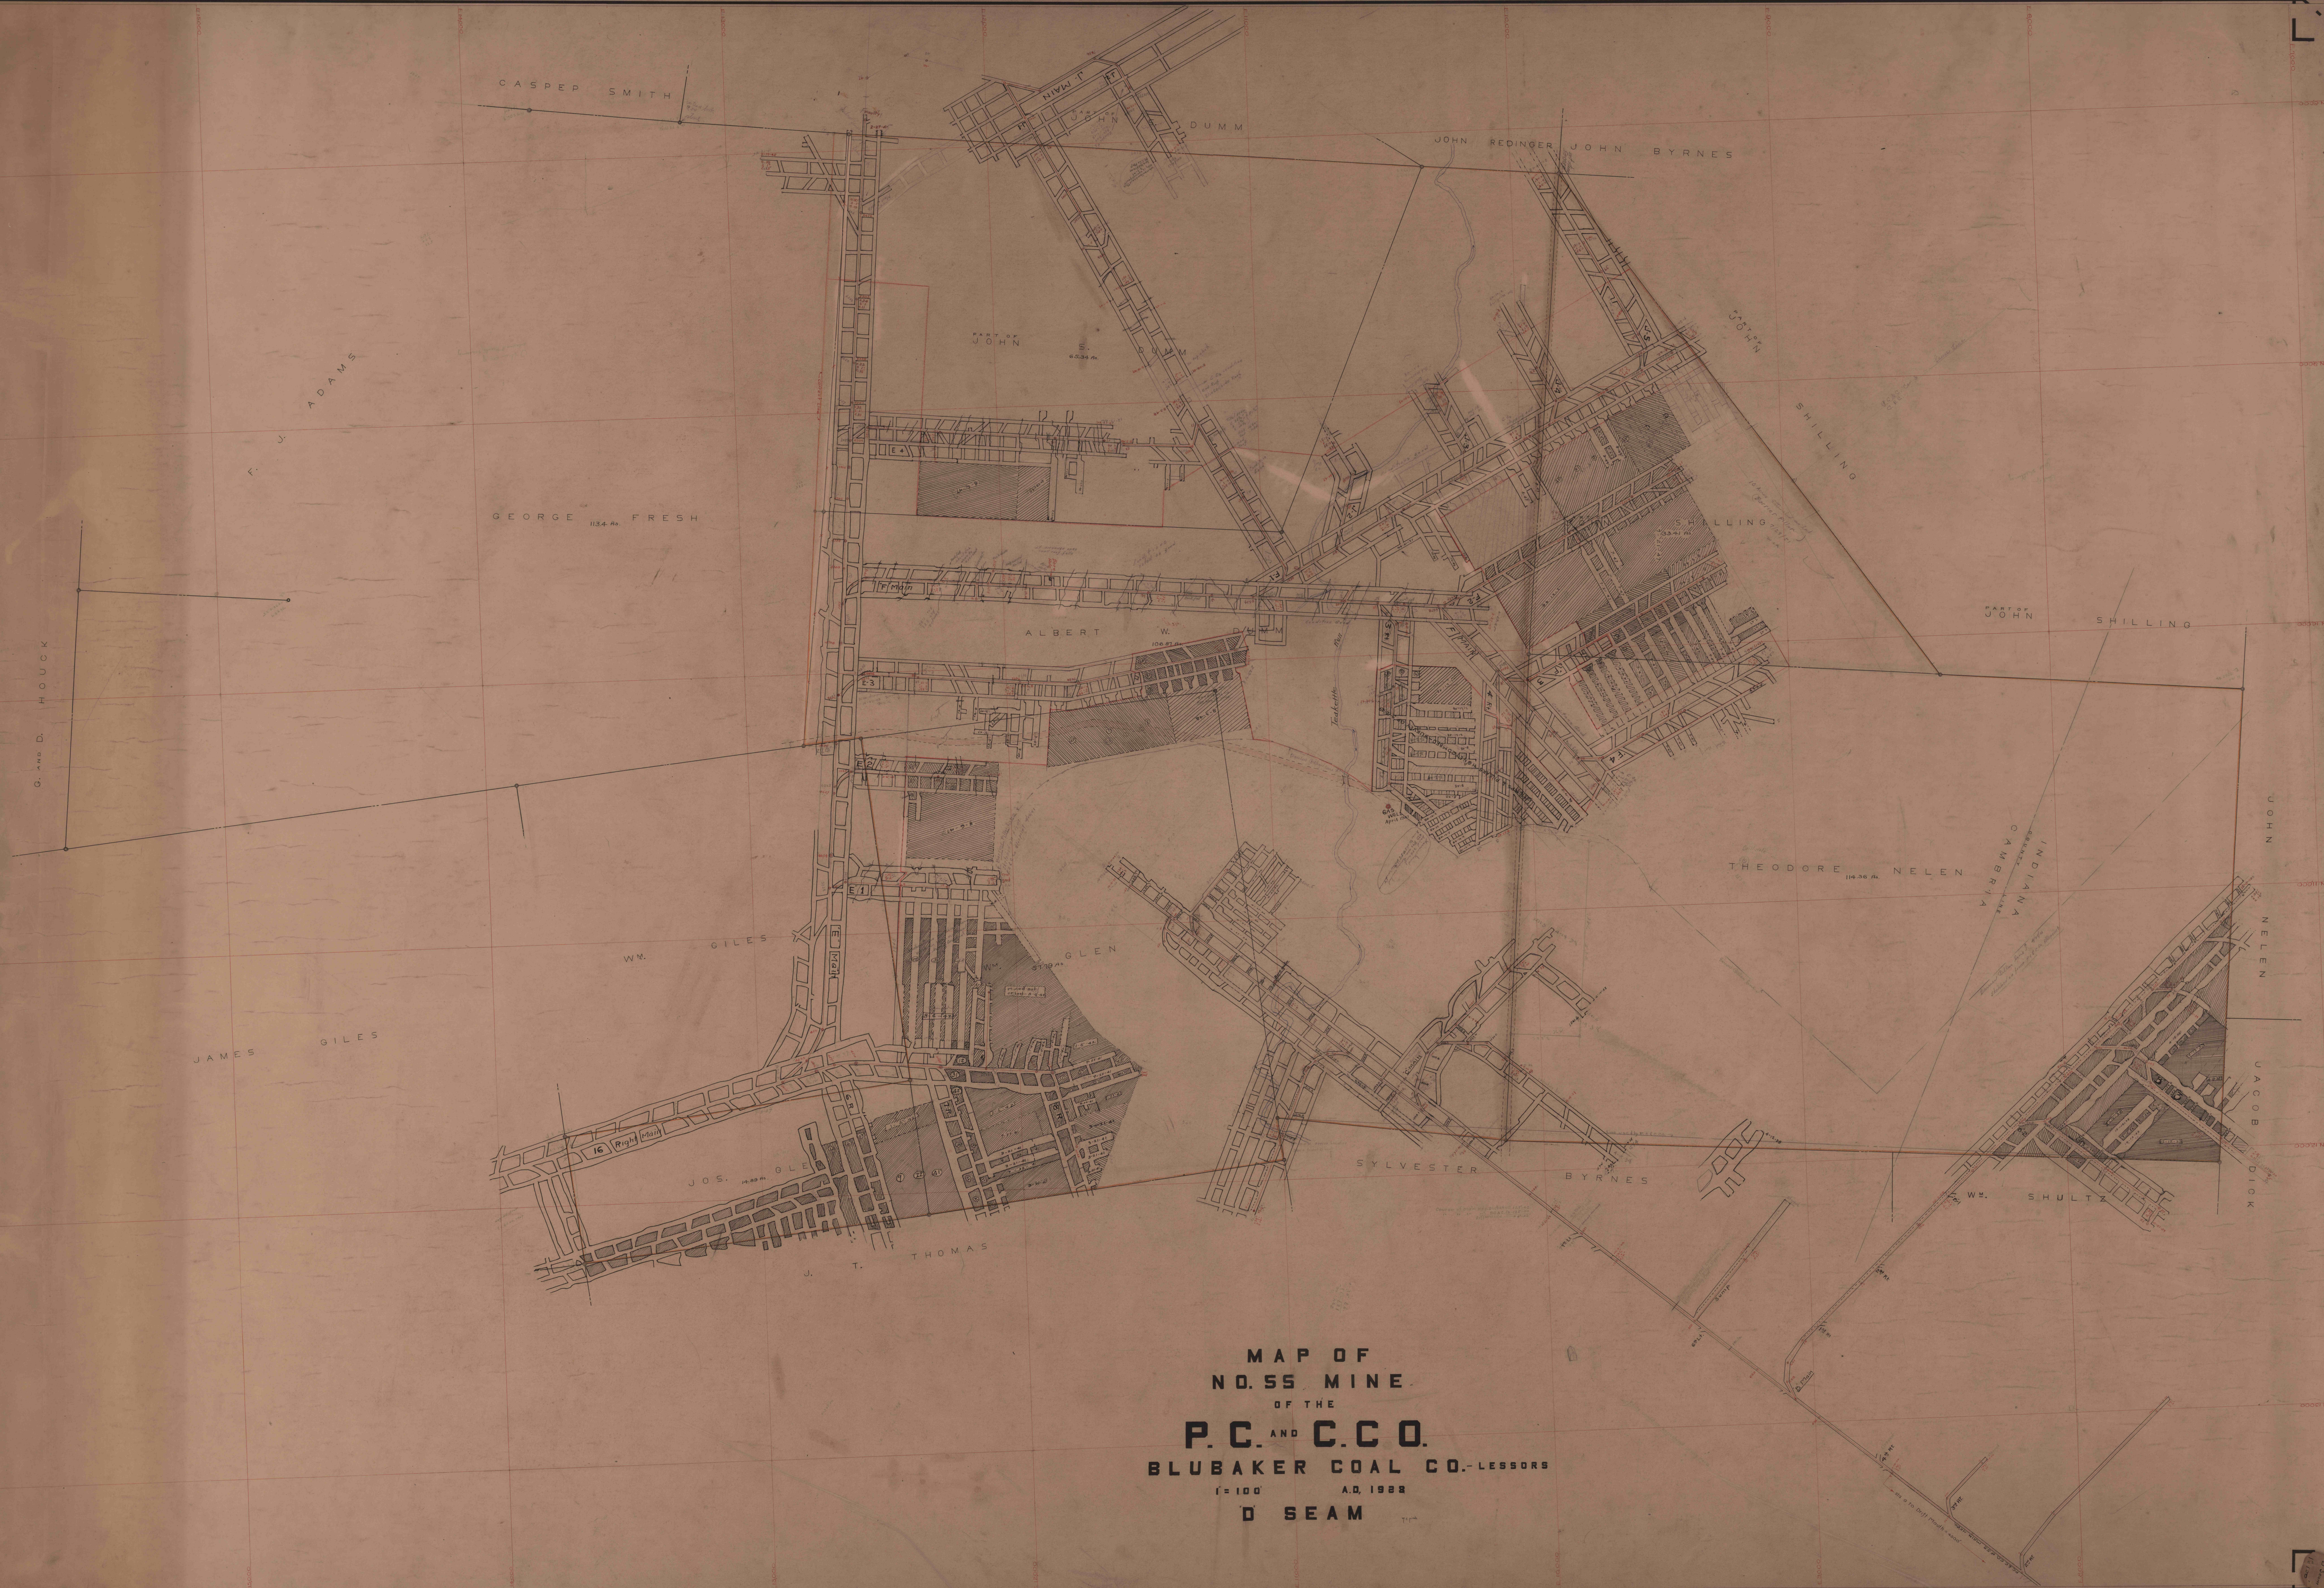

MAP OF
NO. 55 MINE
OF THE
P.C. AND C.C. CO.
BLUBAKER COAL CO.-LESSORS
1"=100' A.D. 1938
D SEAM