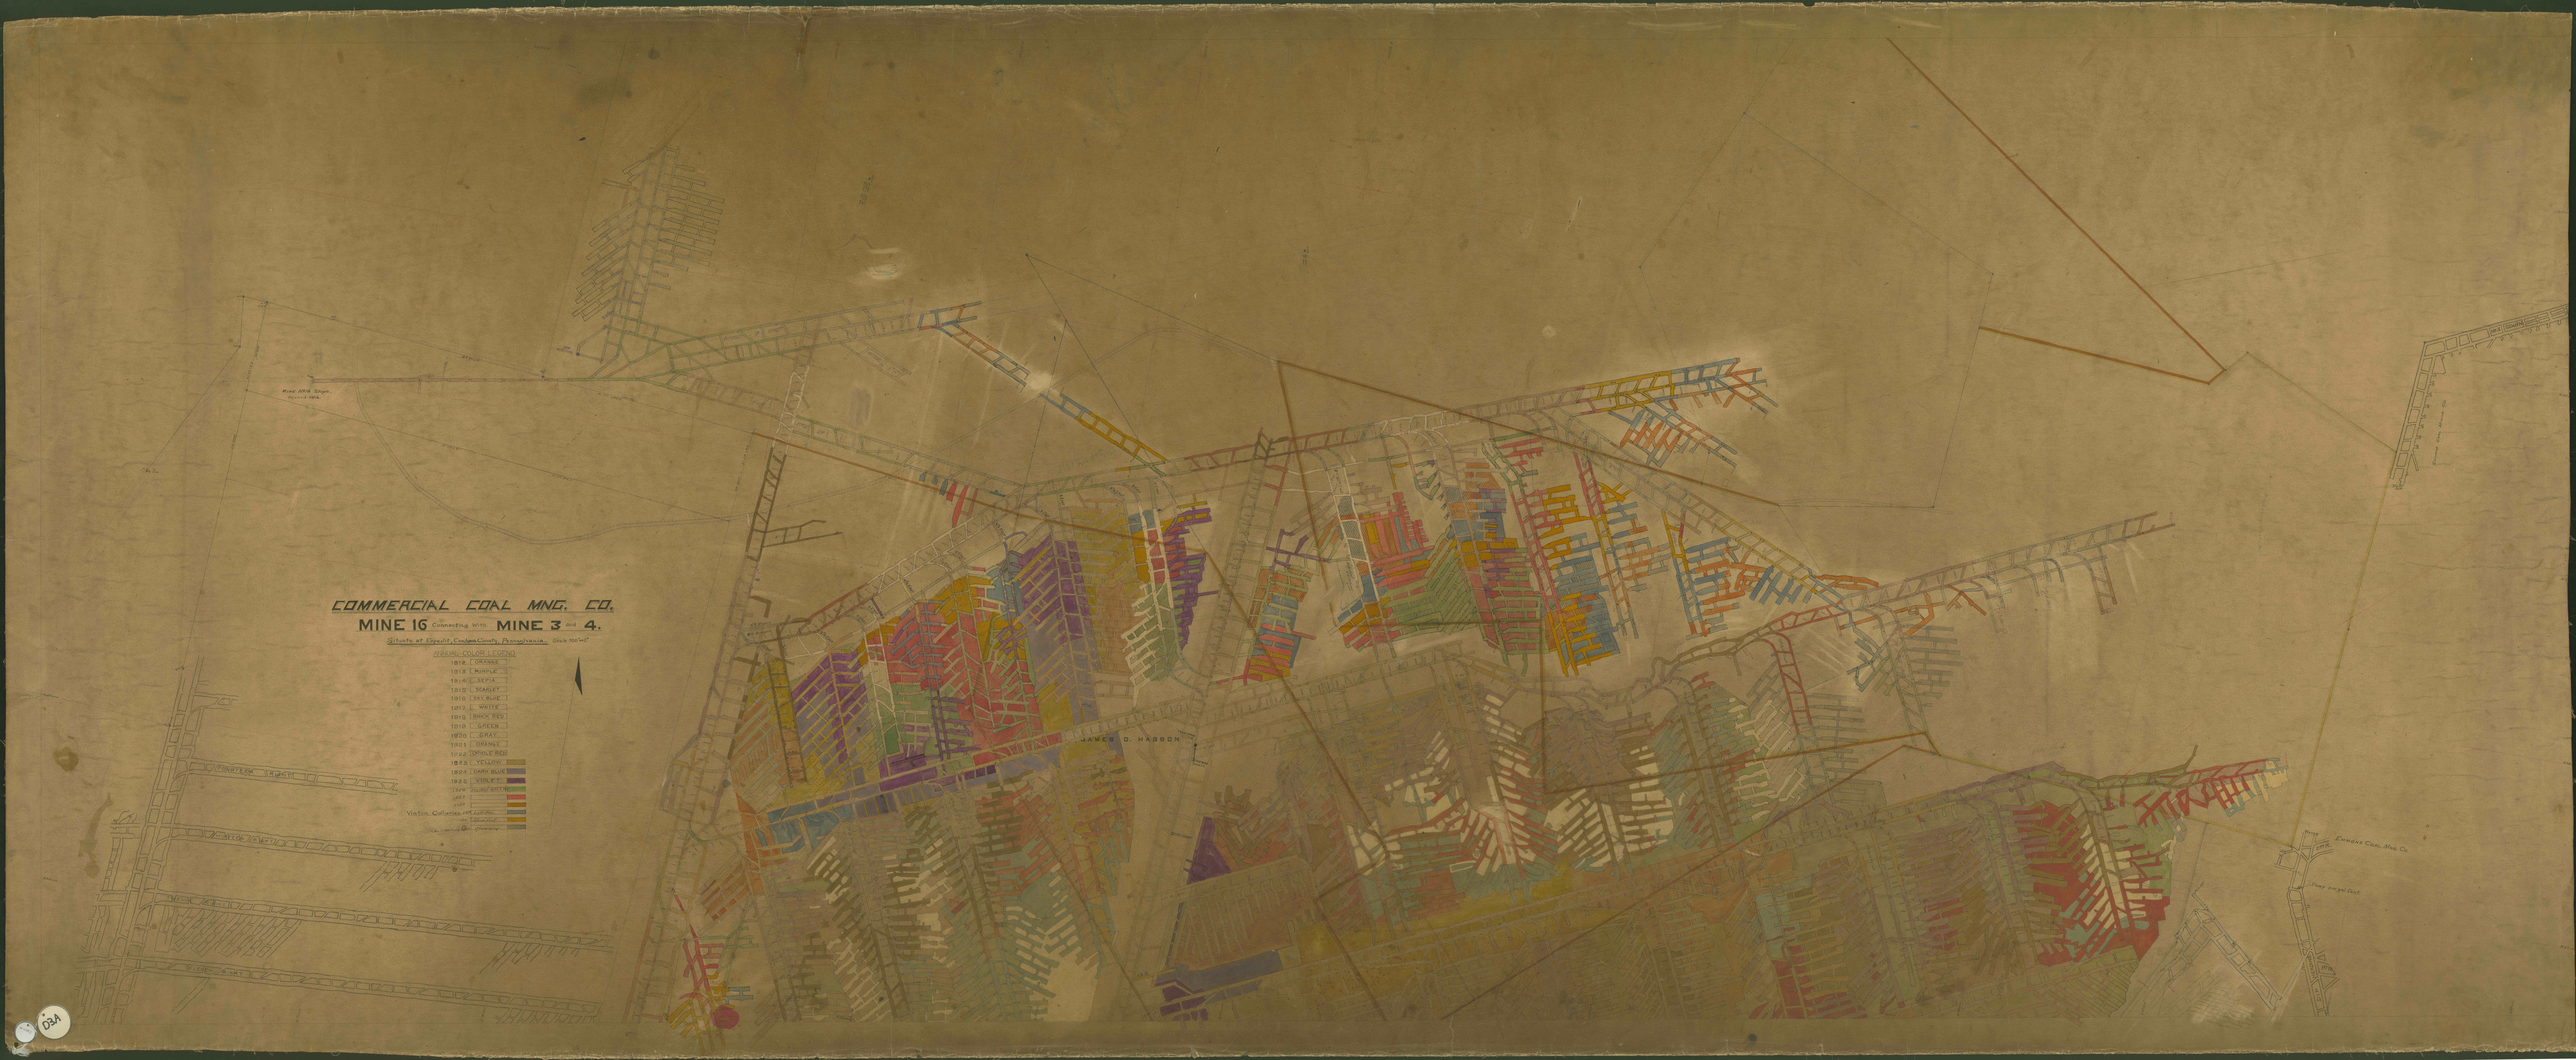
COMMERCIAL COAL MNG. CO.
MINE 16 Connecting with MINE 3 and 4.
Situate at Ehrgott, Cambria County, Pennsylvania. Scale 100 to 1"
ANNUAL COLOR LEGEND
1912 STRAWB
1913 PURPLE
1914 SEPIA
1915 SCARLET
1916 SKY BLUE
1917 WHITE
1918 BROCK RED
1919 GREEN
1920 GRAY
1921 ORANGE
1922 VIOLET RED
1923 YELLOW
1924 DARK BLUE
1925 VIOLET
1926 LIGHT GREEN
1927
1928
1929
Virgin Columns left standing
for Security
JAMES D. HASSON
Mine MAIN Slope
Opened 1906.
Ehrgott Coal Mng. Co.
Mine mined Out