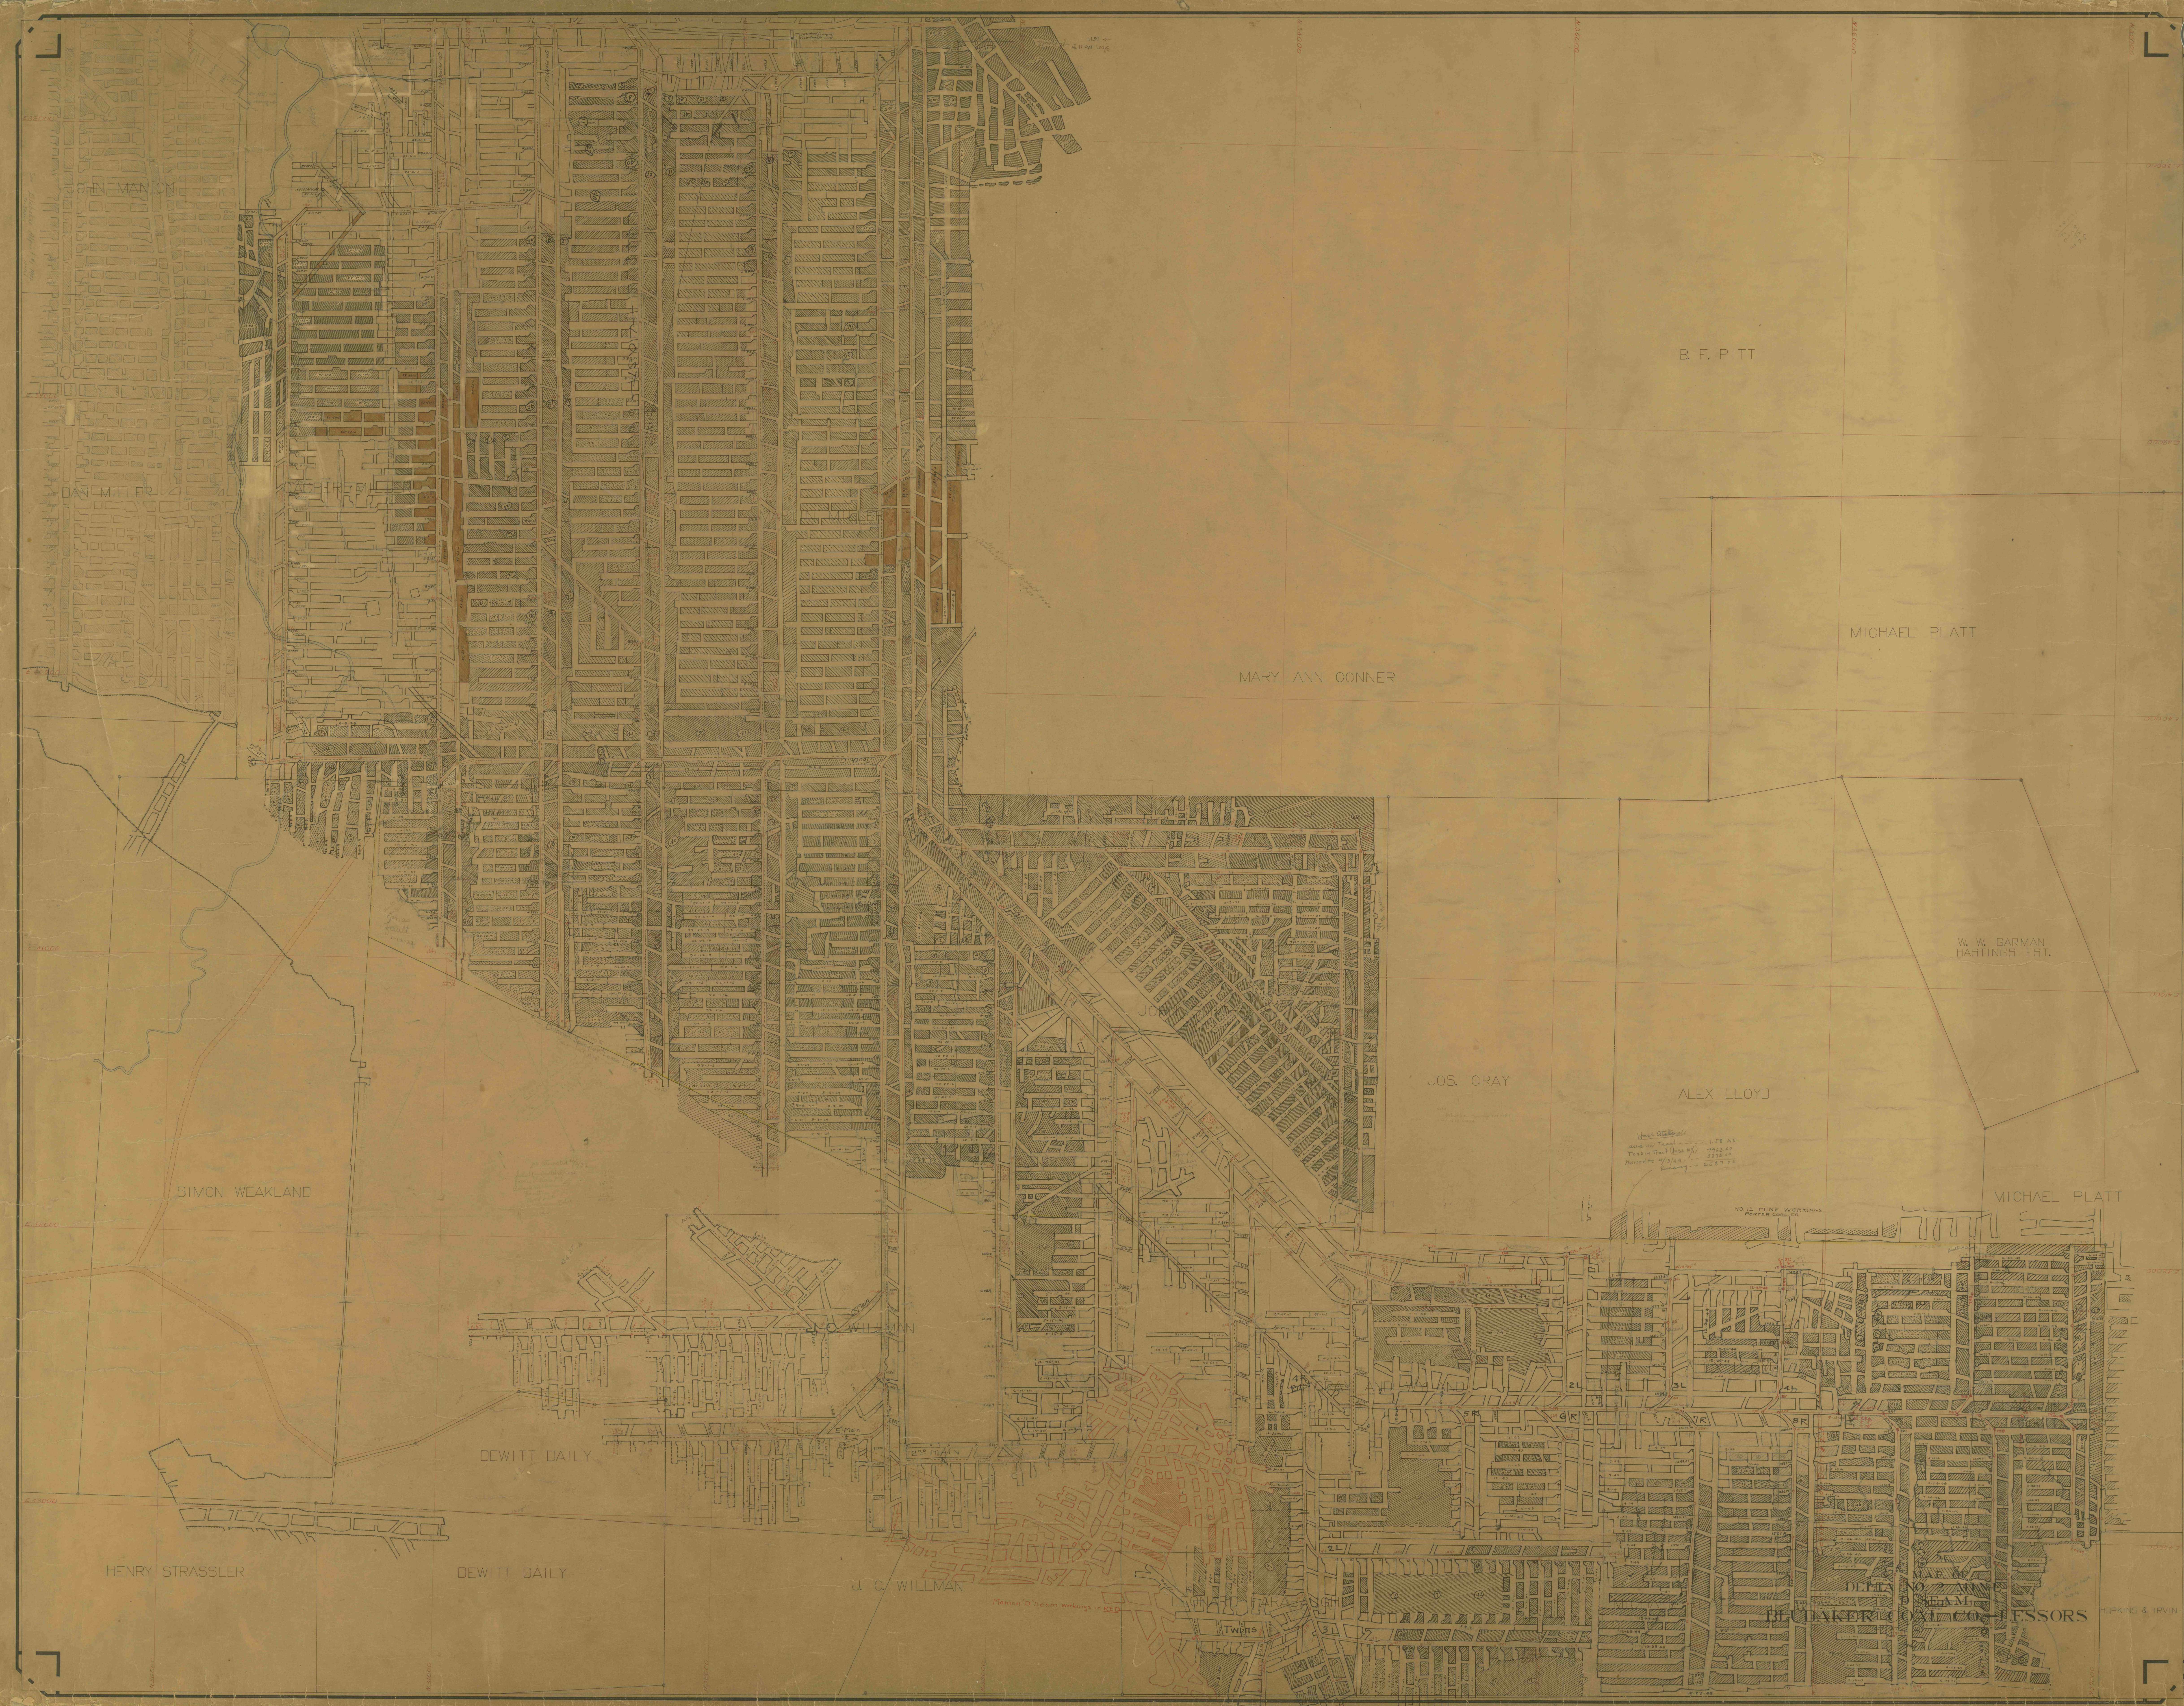
MAP OF
DELTA NO. 2 MINE
D SEAM
BLUBAKER COAL CO.—LESSORS
HOPKINS & IRVIN
JOHN MANION
DAN MILLER
B. F. PITT
MICHAEL PLATT
MARY ANN CONNER
W. W. GARMAN
HASTINGS EST.
JOS. GRAY
ALEX LLOYD
MICHAEL PLATT
SIMON WEAKLAND
DEWITT DAILY
HENRY STRASSLER
DEWITT DAILY
J. C. WILLMAN