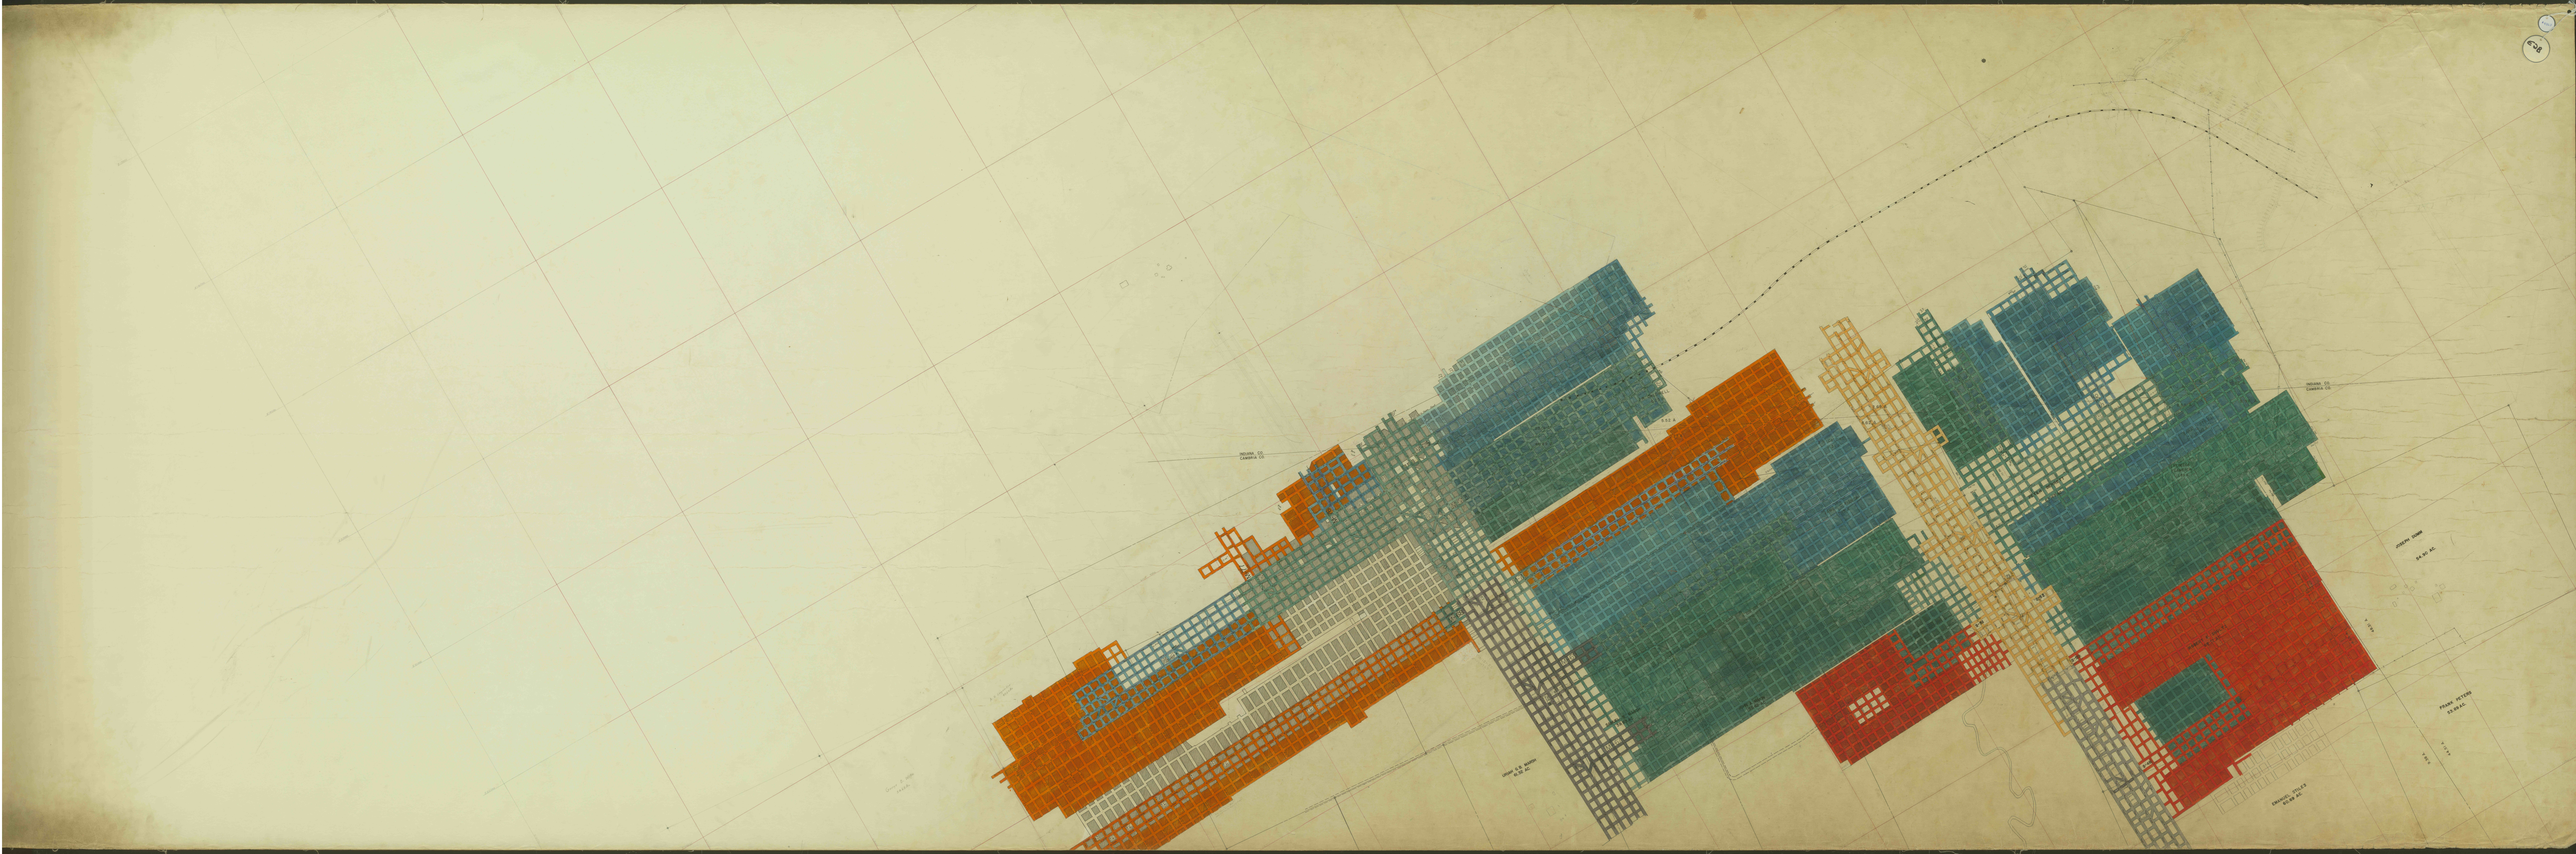

INDIANA CO.
CAMBRIA CO.
INDIANA CO.
CAMBRIA CO.
THOMAS H. MAHAN
83.62 A.
M-69
M-67
SAMUEL S. MARSH
59.63 AC.
JOHN A. MAKIN
55.62 AC.
URIAH G.B. MARSH
61.32 AC.
ROBERT F. SHULTZ
66.12 AC.
JOSEPH DUMM
54.90 AC.
FRANK PETERS
53.89 AC.
EMANUEL STILES
60.69 AC.
48.31 A.
9.38 A.
44.51 A.
S-48
Bad Top
E25000

#4363
E2B