



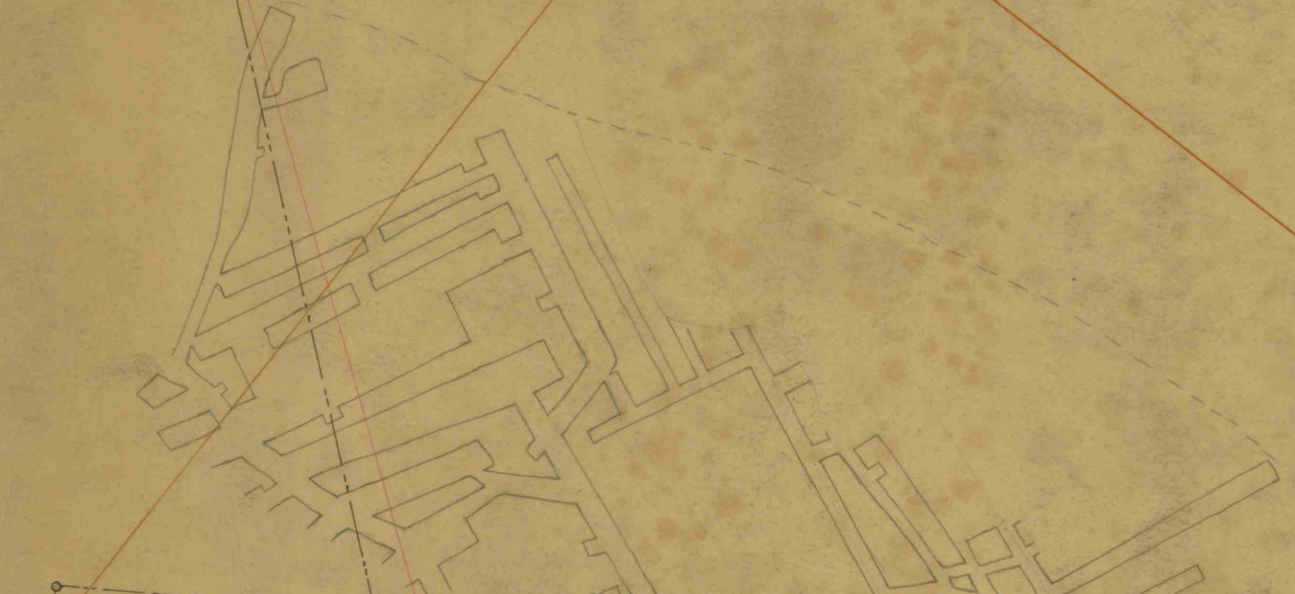

Coke Cinders

BLAIRSVILLE COKE CO

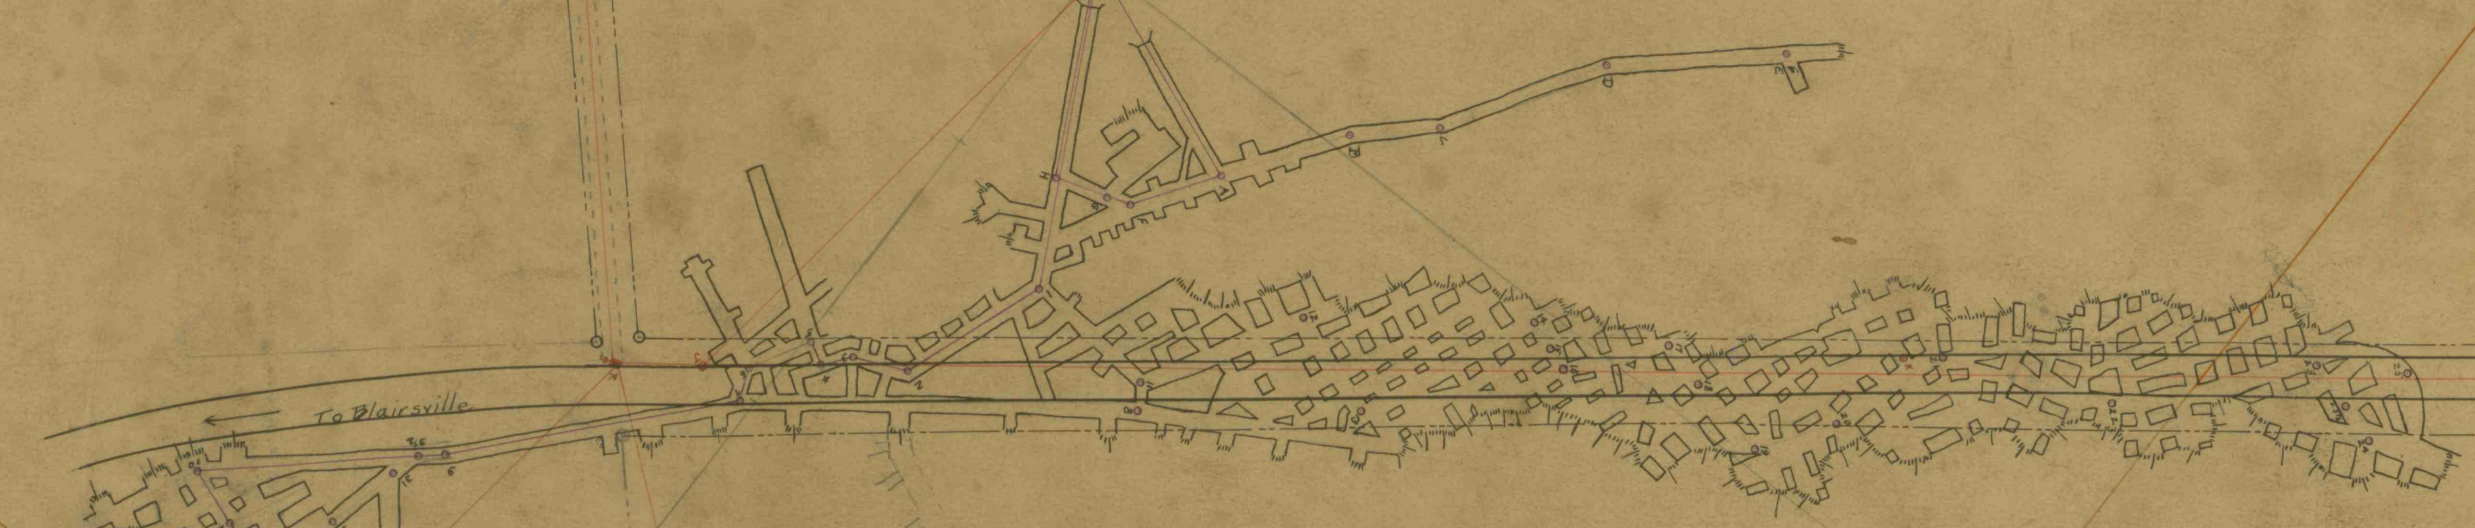

WILLIAM PENN HIGHWAY

BLAIRSVILLE COKE CO

William House



83E