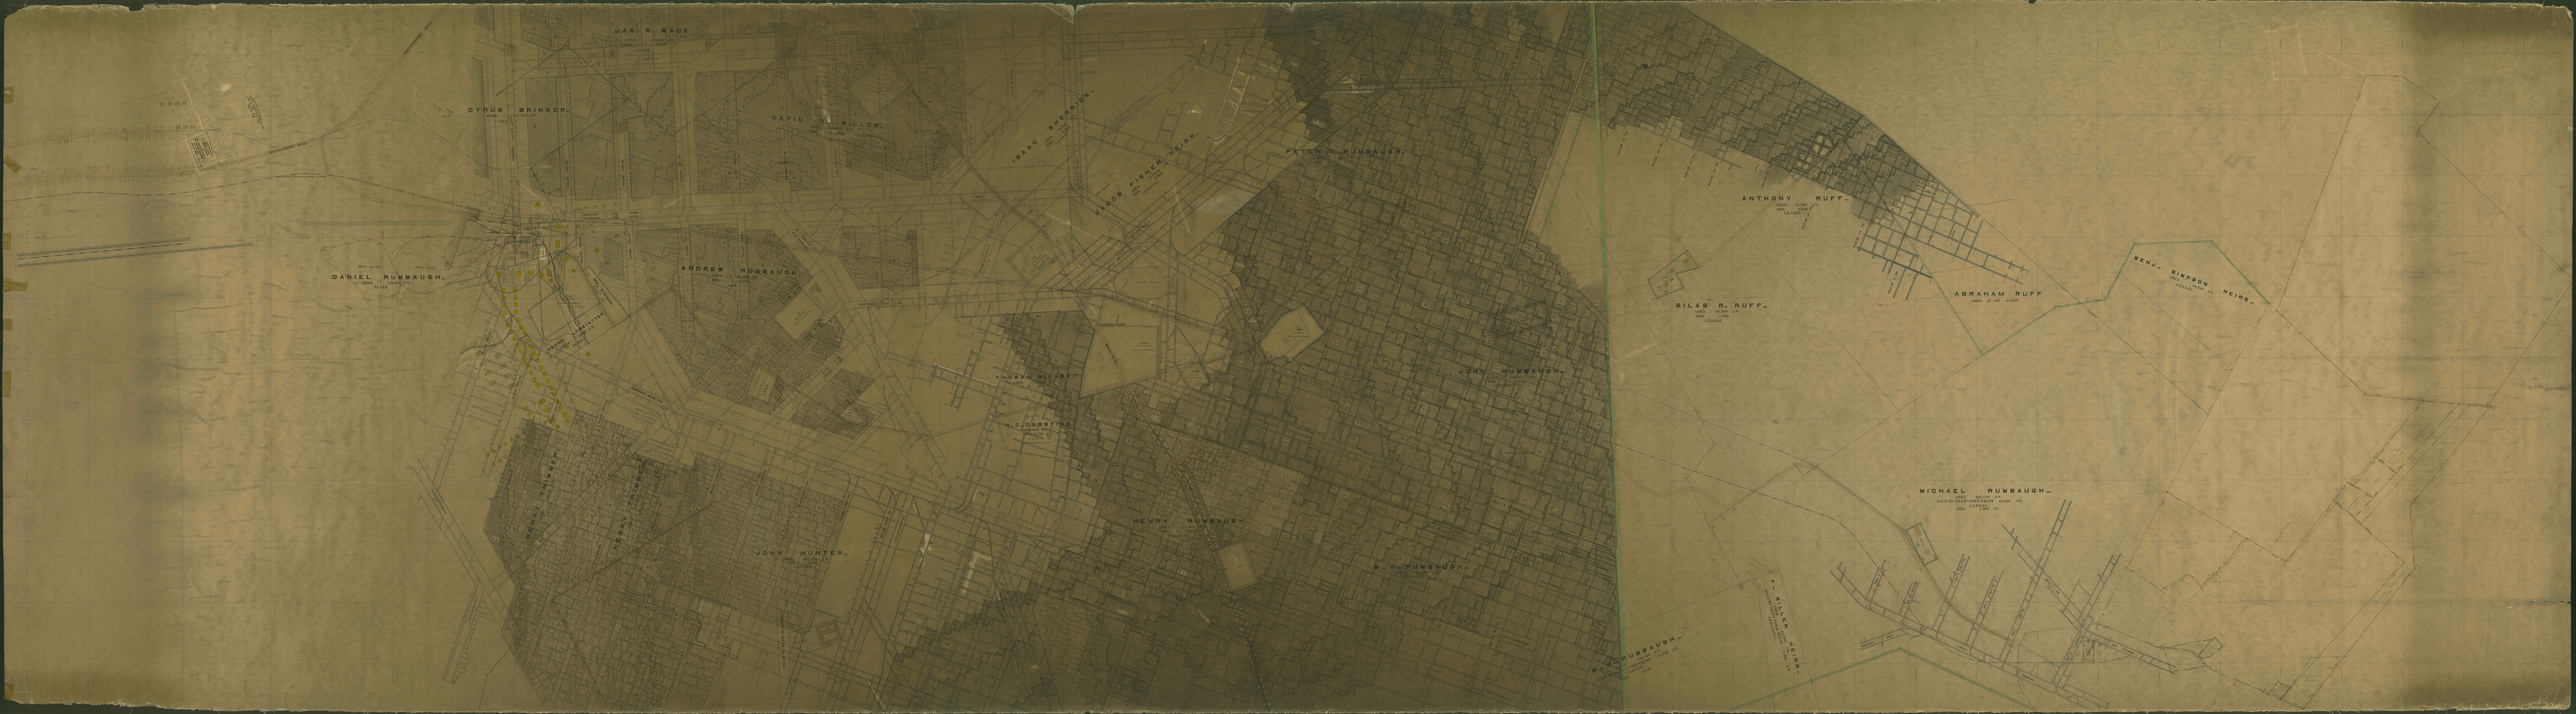

JAS. R. WADE
CYRUS BRINKER
DAVID B. MILLER
ISAAC SHERRICK
JACOB FISHER HEIRS
PETER RUMBAUGH
ANTHONY RUFF
DANIEL RUMBAUGH
ANDREW RUMBAUGH
SILAS R. RUFF
ABRAHAM RUFF
BENJ. SIMPSON HEIRS
THOMAS MILLER
JOHN RUMBAUGH
H. C. DUMBAUGH
HENRY RUMBAUGH
JOHN HUNTER
M. H. RUMBAUGH
MICHAEL RUMBAUGH