


No 726

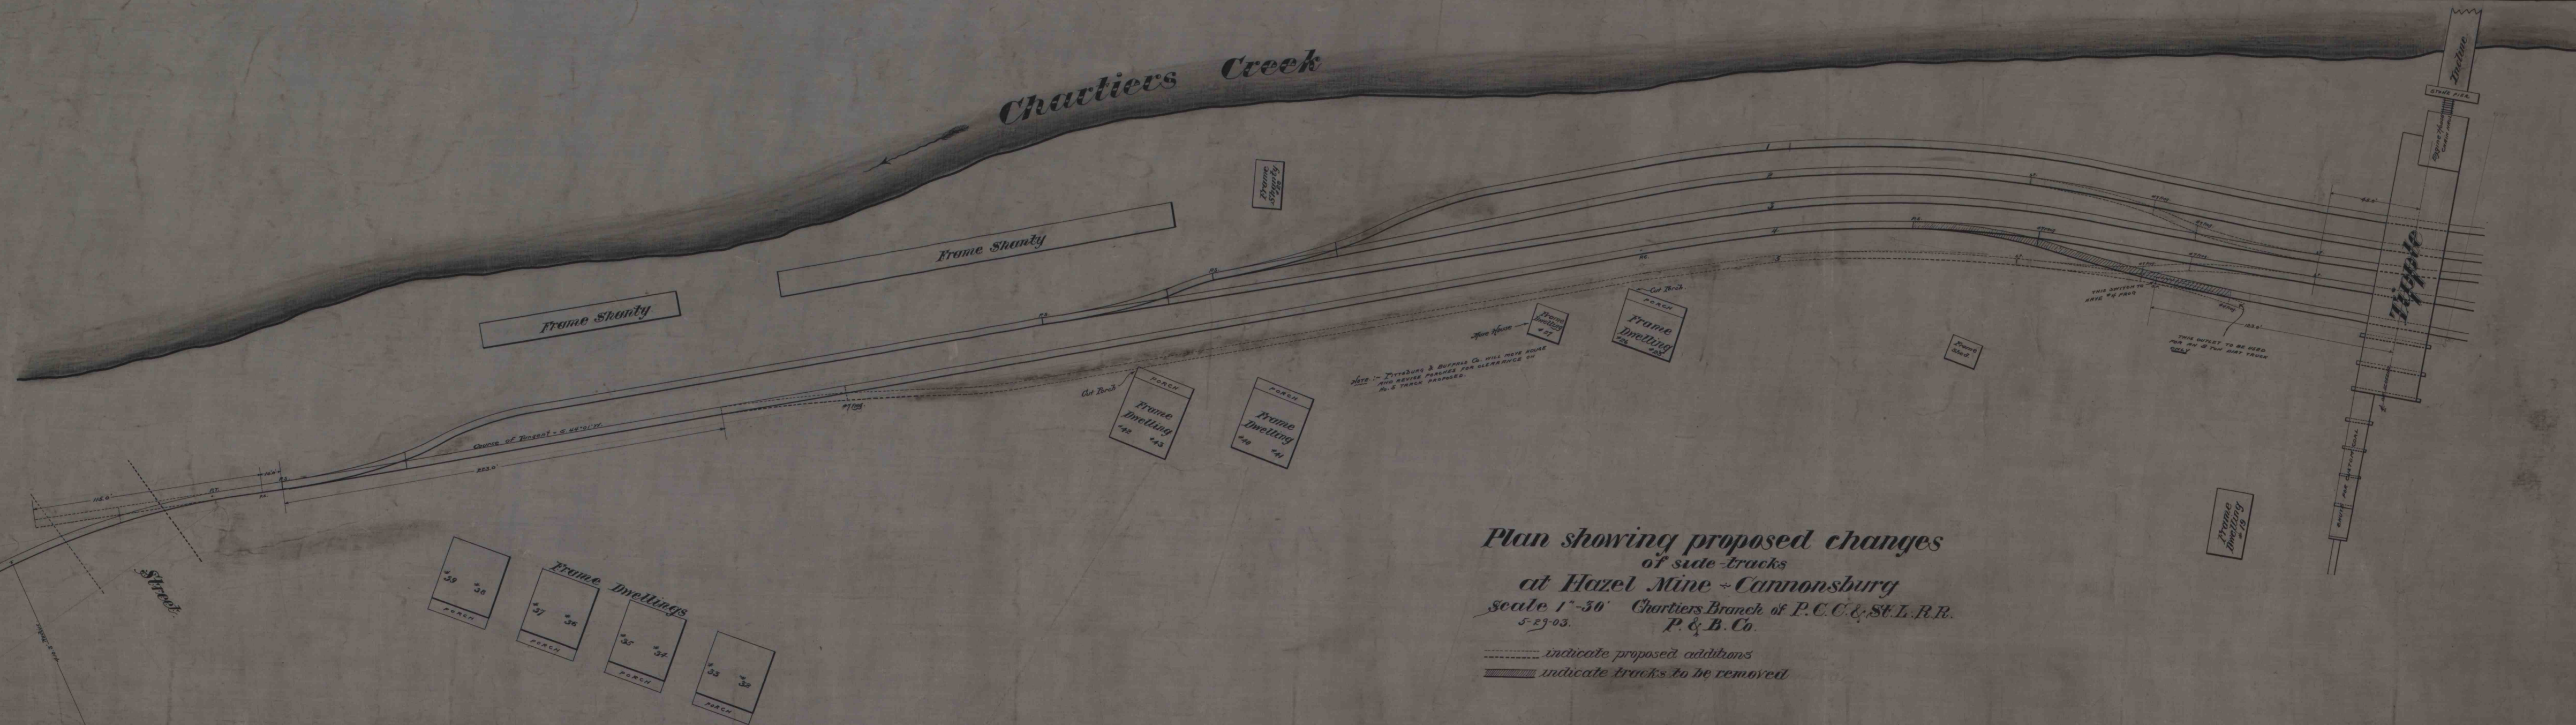

Plan showing proposed changes
of side tracks
at Hazel Mine & Cannonsburg
Scale 1"=30' Chartiers Branch of P.C.C. & St. L.R.R.
P. & B. Co.
5-29-03.

----- indicate proposed additions
===== indicate tracks to be removed

