


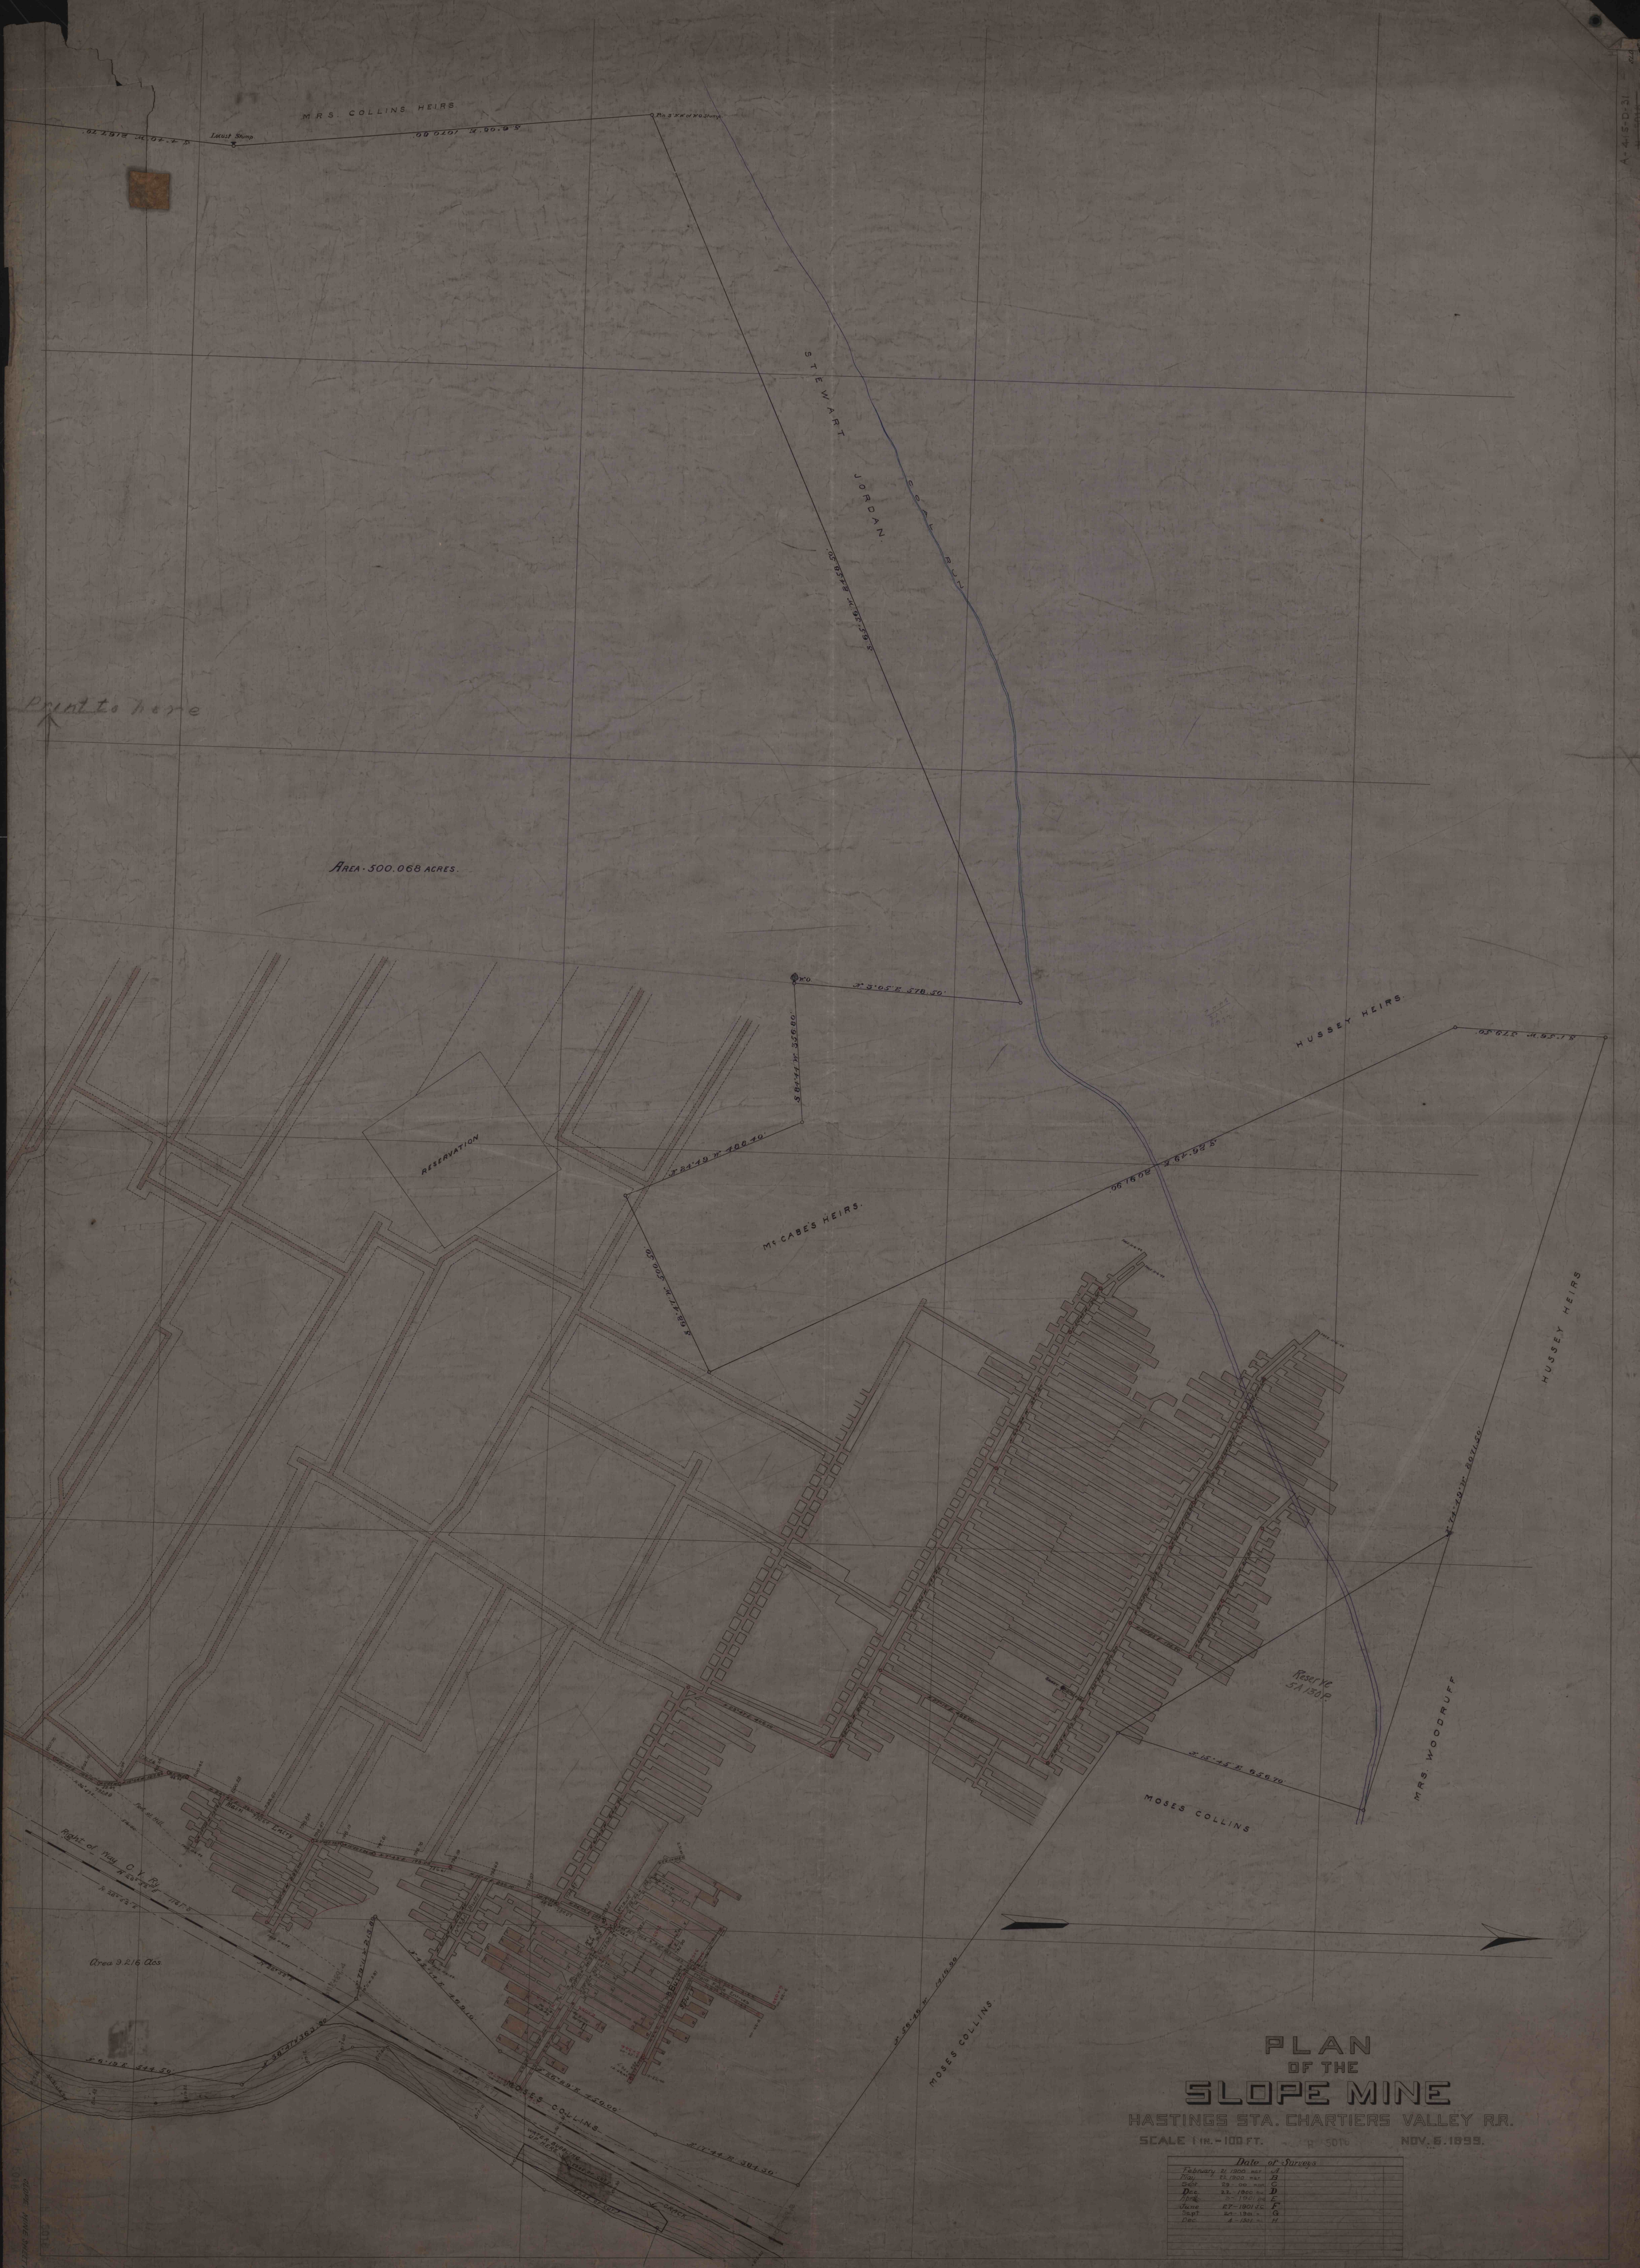

Point to here

AREA 500.068 ACRES.

RESERVATION

McCABES HEIRS.

HUSSEY HEIRS

HUSSEY HEIRS

MRS. WOODRUFF

MOSES COLLINS

MOSES COLLINS

PLAN OF THE SLOPE MINE

HASTINGS STA. CHARTIERS VALLEY R.R.

SCALE 1 IN. = 100 FT. NOV. 6. 1899.

Date of Survey	
February 21, 1900	A
May 21, 1900	B
June 28, 1900	C
Dec. 21, 1900	D
June 17, 1901	E
Aug. 18, 1901	F
Dec. 4, 1901	G