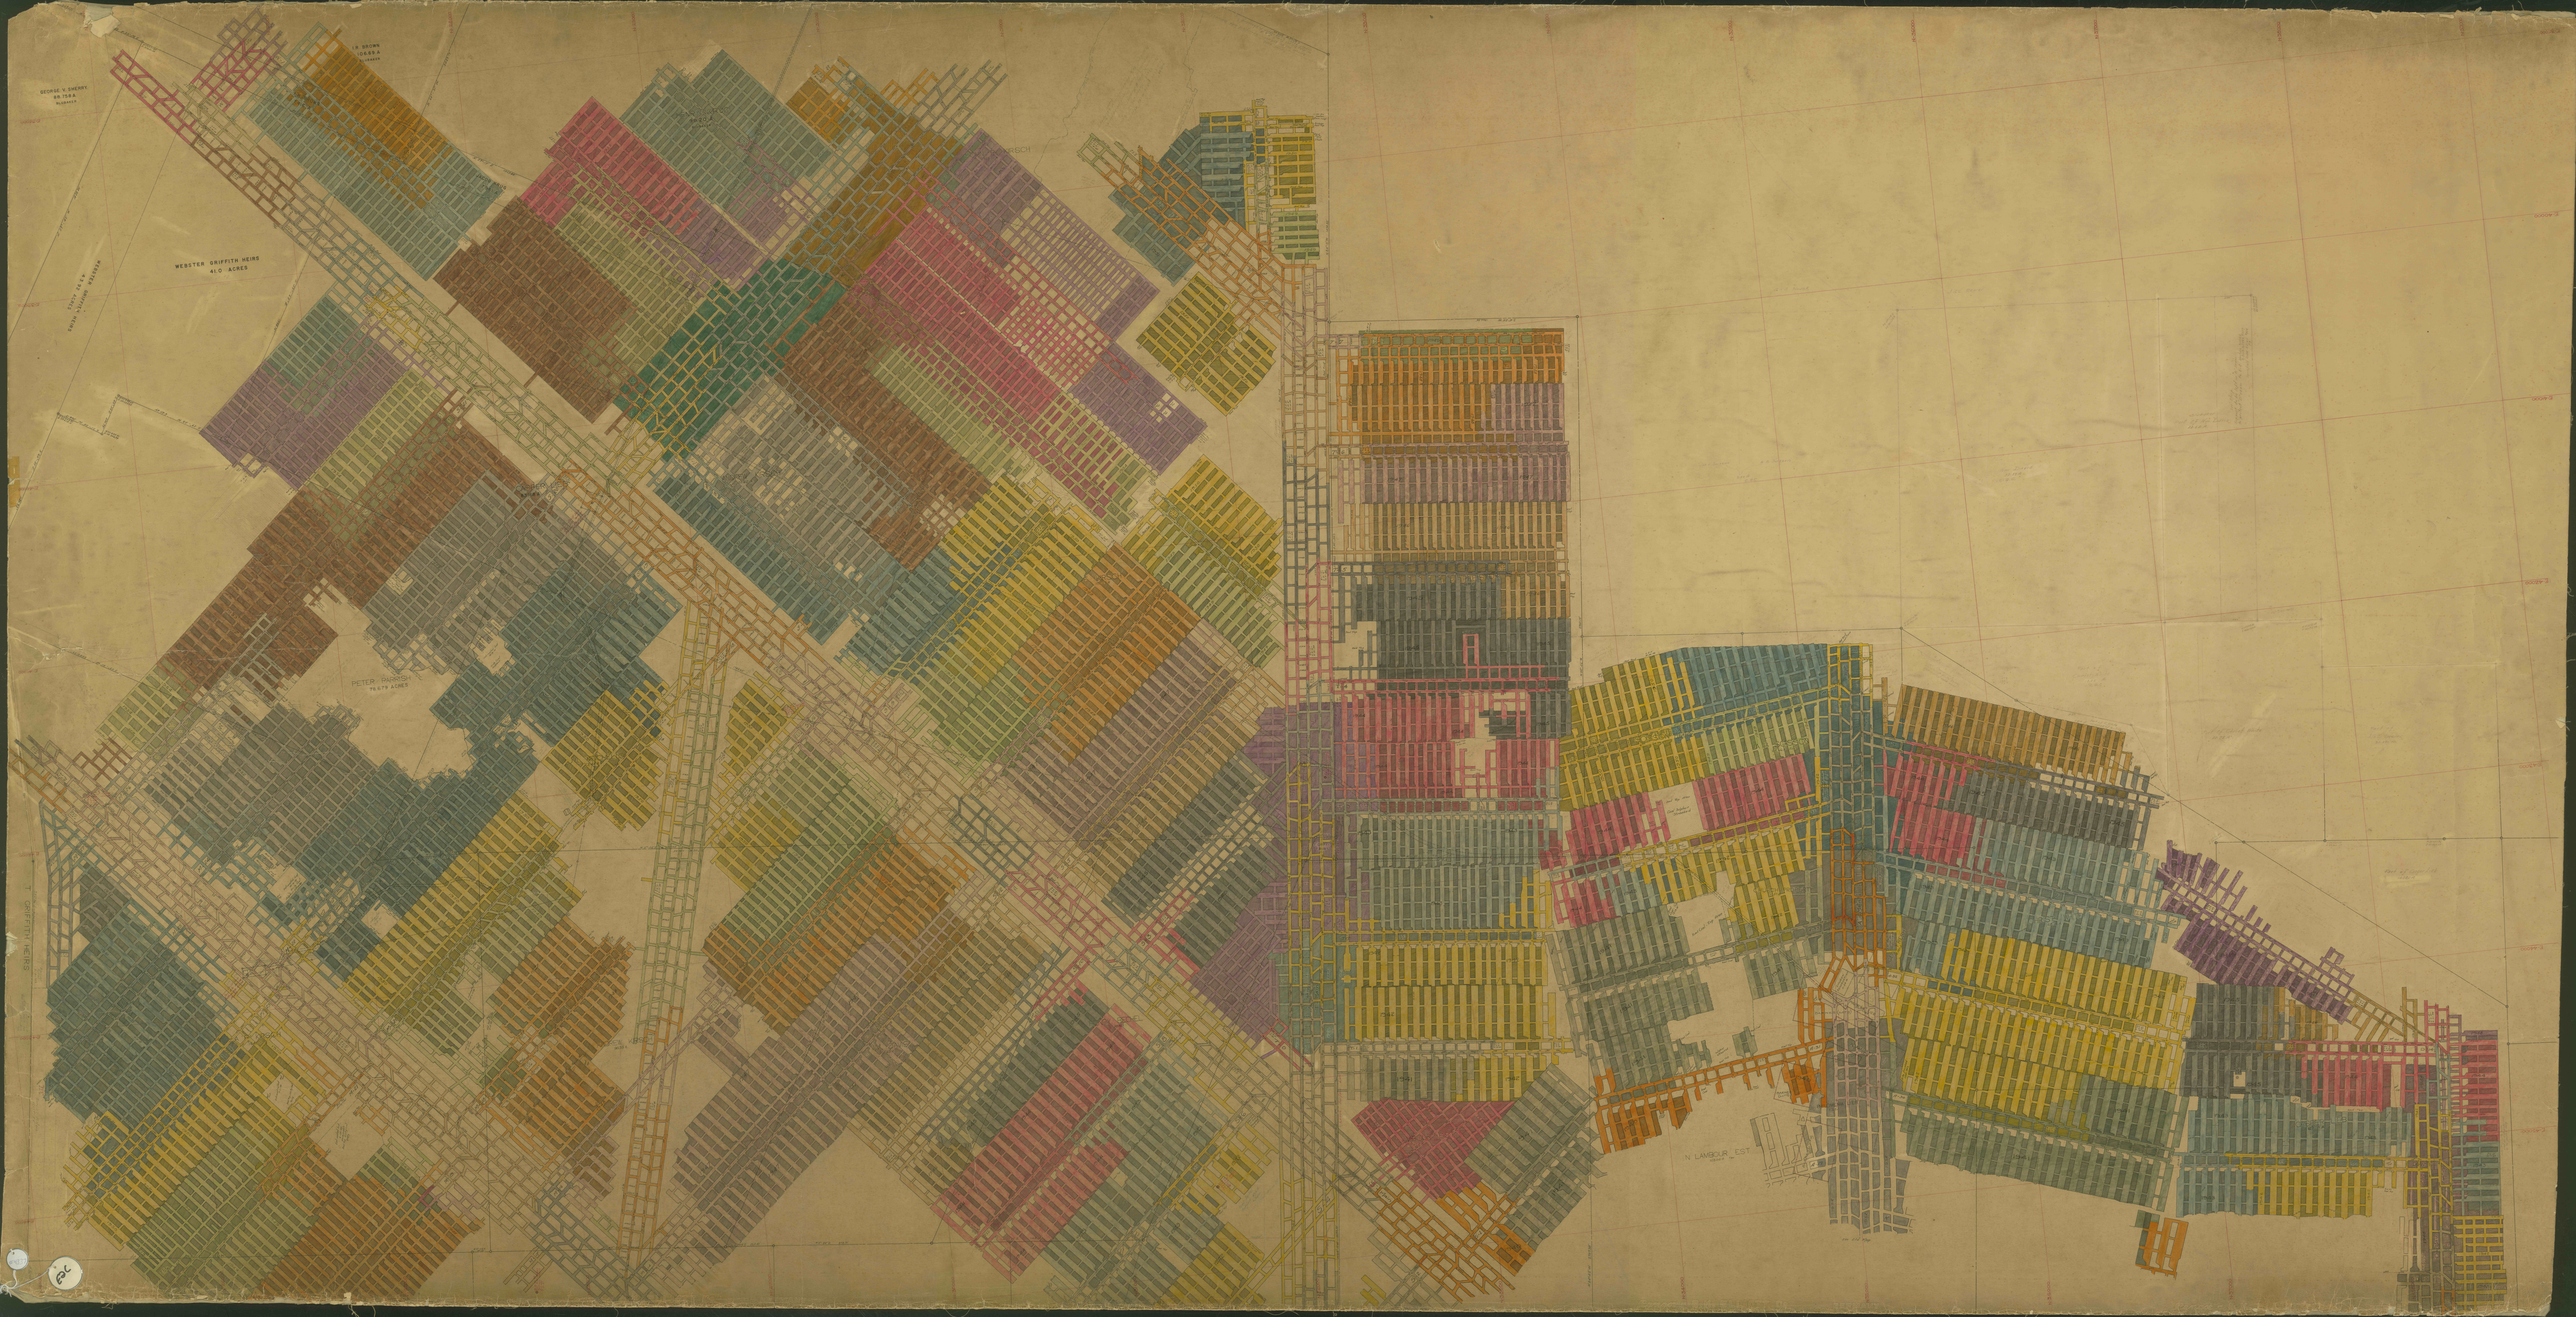

GEORGE V. SHERRY
88.758 A
BLUBAKER
I.R. BROWN
106.69 A
BLUBAKER
I.R. BROWN
7.416 A
WEBSTER GRIFFITH HEIRS
41.0 ACRES
WEBSTER GRIFFITH HEIRS
43.92 ACRES
PETER PARRISH
78.679 ACRES
1953
1952
1951
N LAMBOUR EST
105.04 A Fee
PHILOMENIA LIEB
3.328 A
BARNES (LOTS)
A-29
A-30
1940
1941
1942
A-30 finished Mar. 1942
see Old Map.
Dirty Coal
Sulphur
Bad Top
Bad Coal