


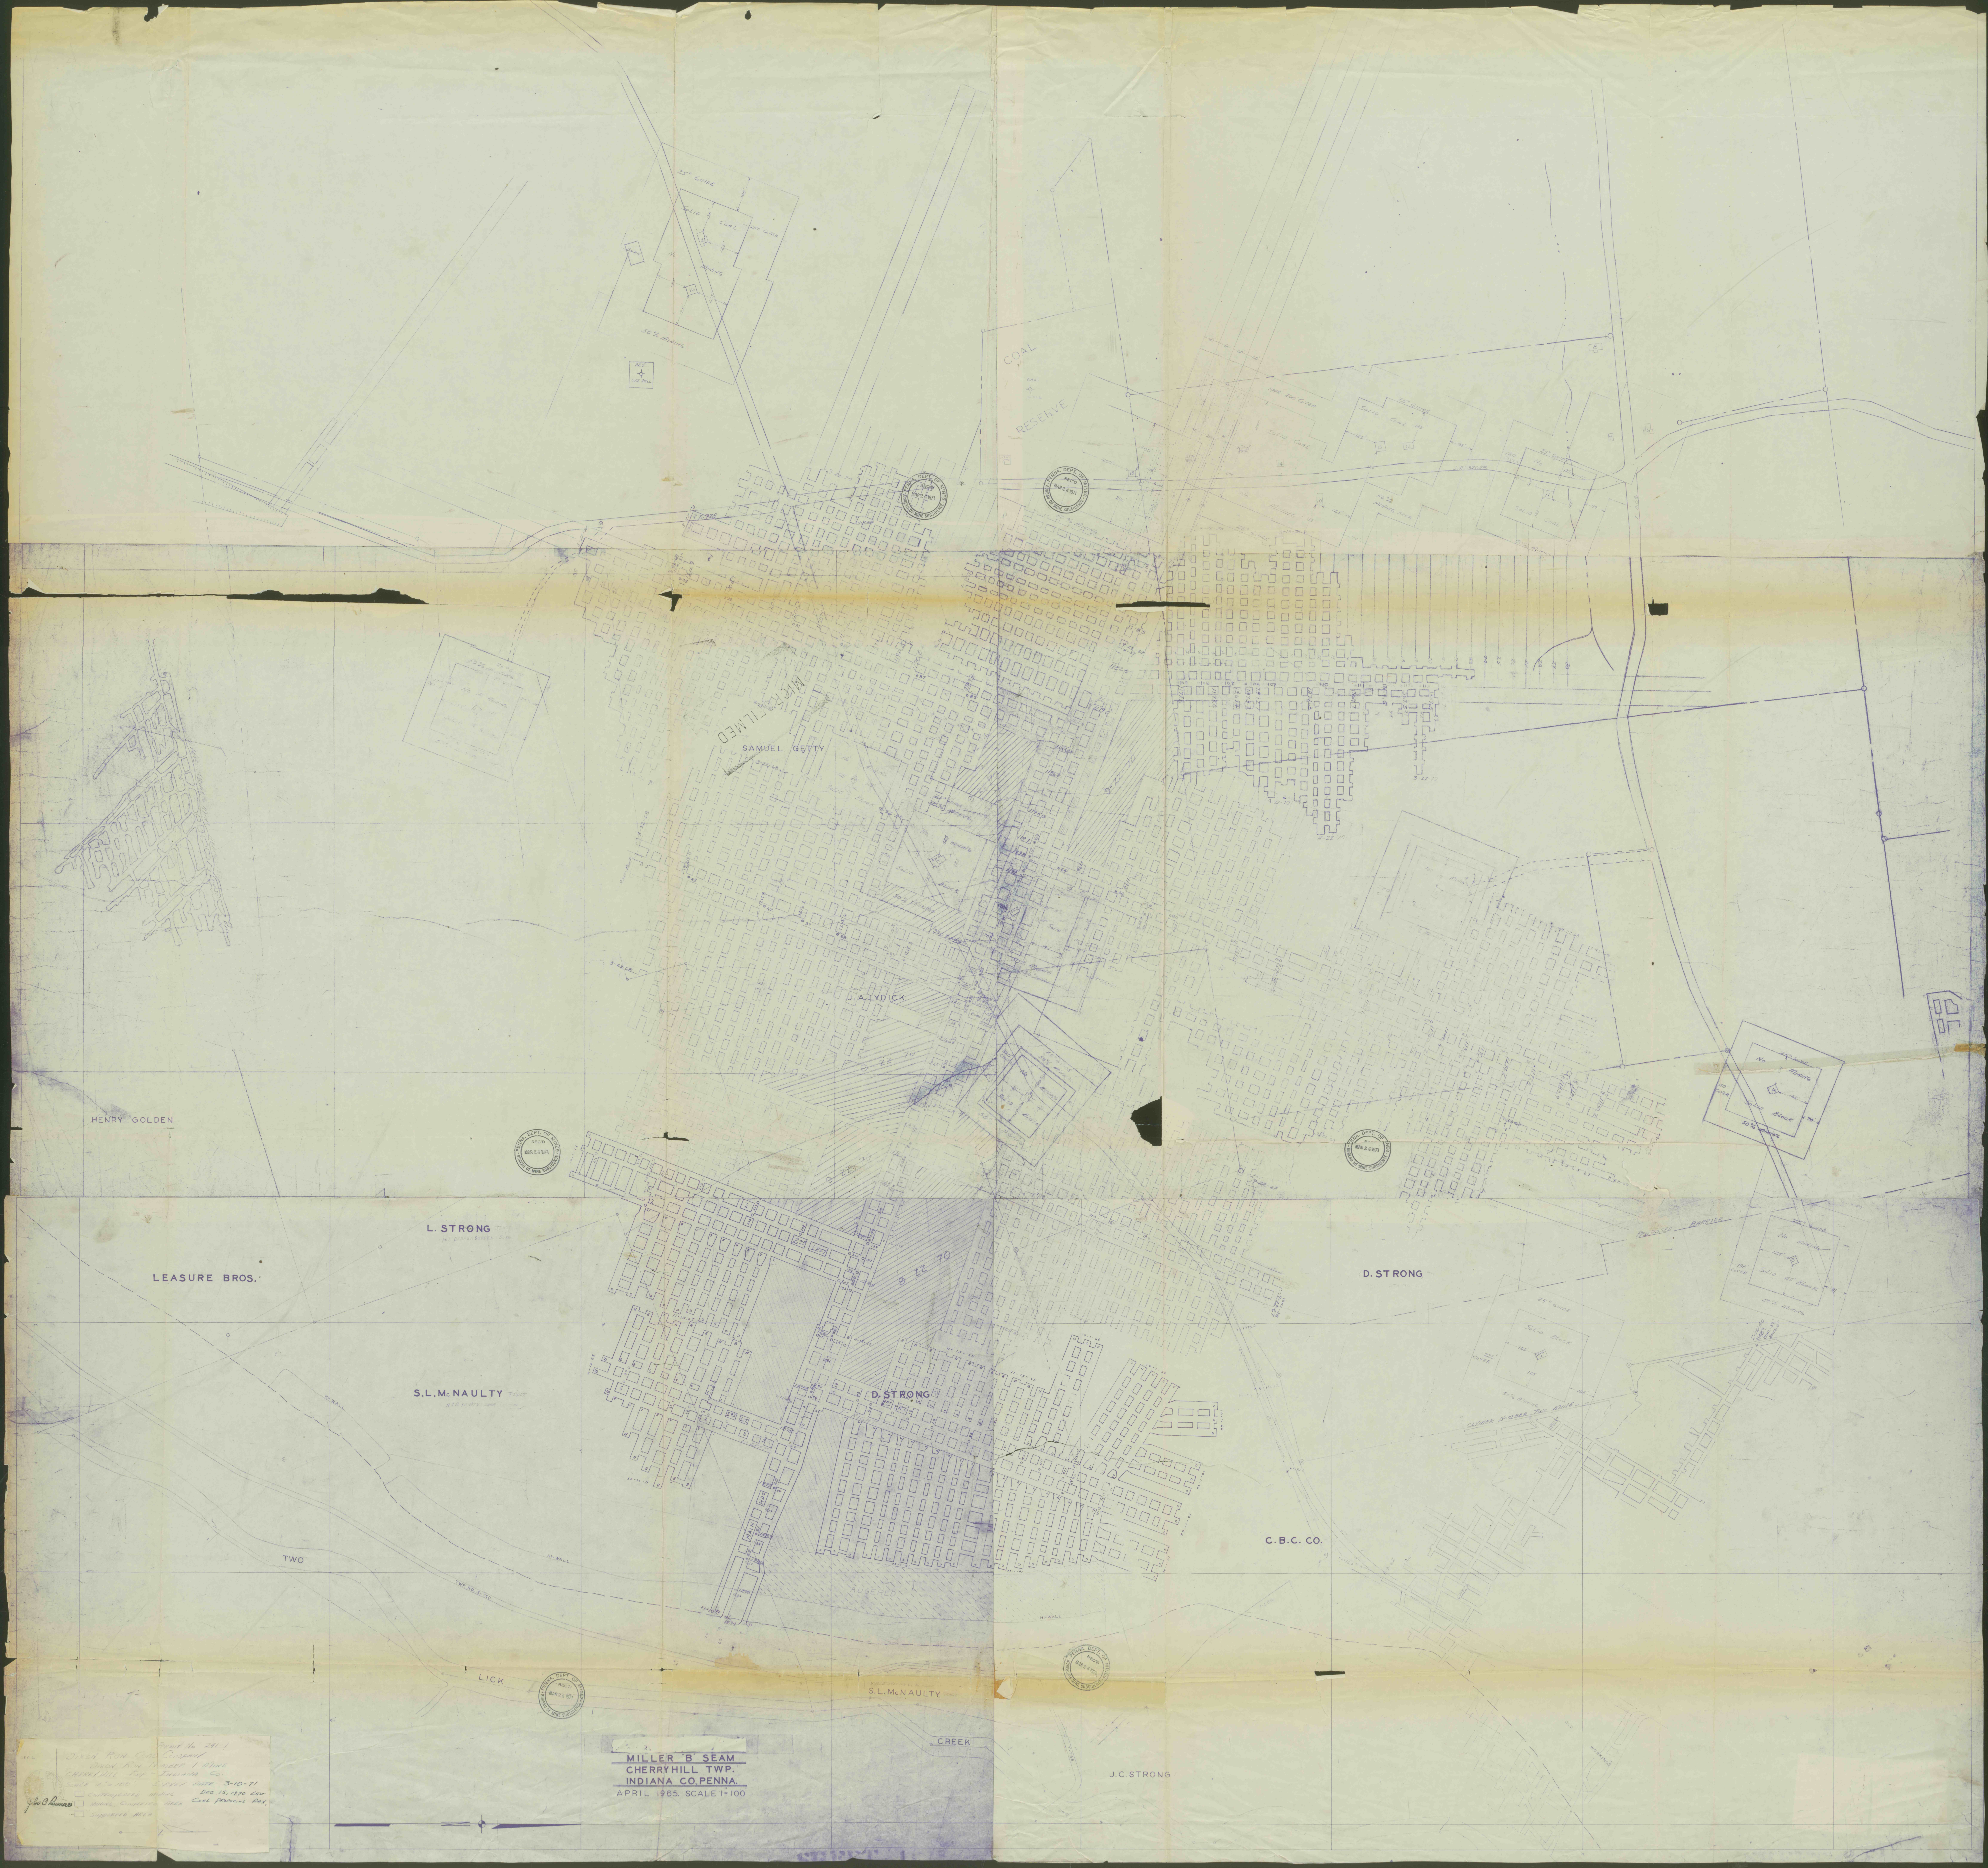

Hand No. 240-1
DATE 3-10-71

MILLER B SEAM
CHERRY HILL TWP.
INDIANA CO. PENNA.
APRIL 1965. SCALE 1"=100'