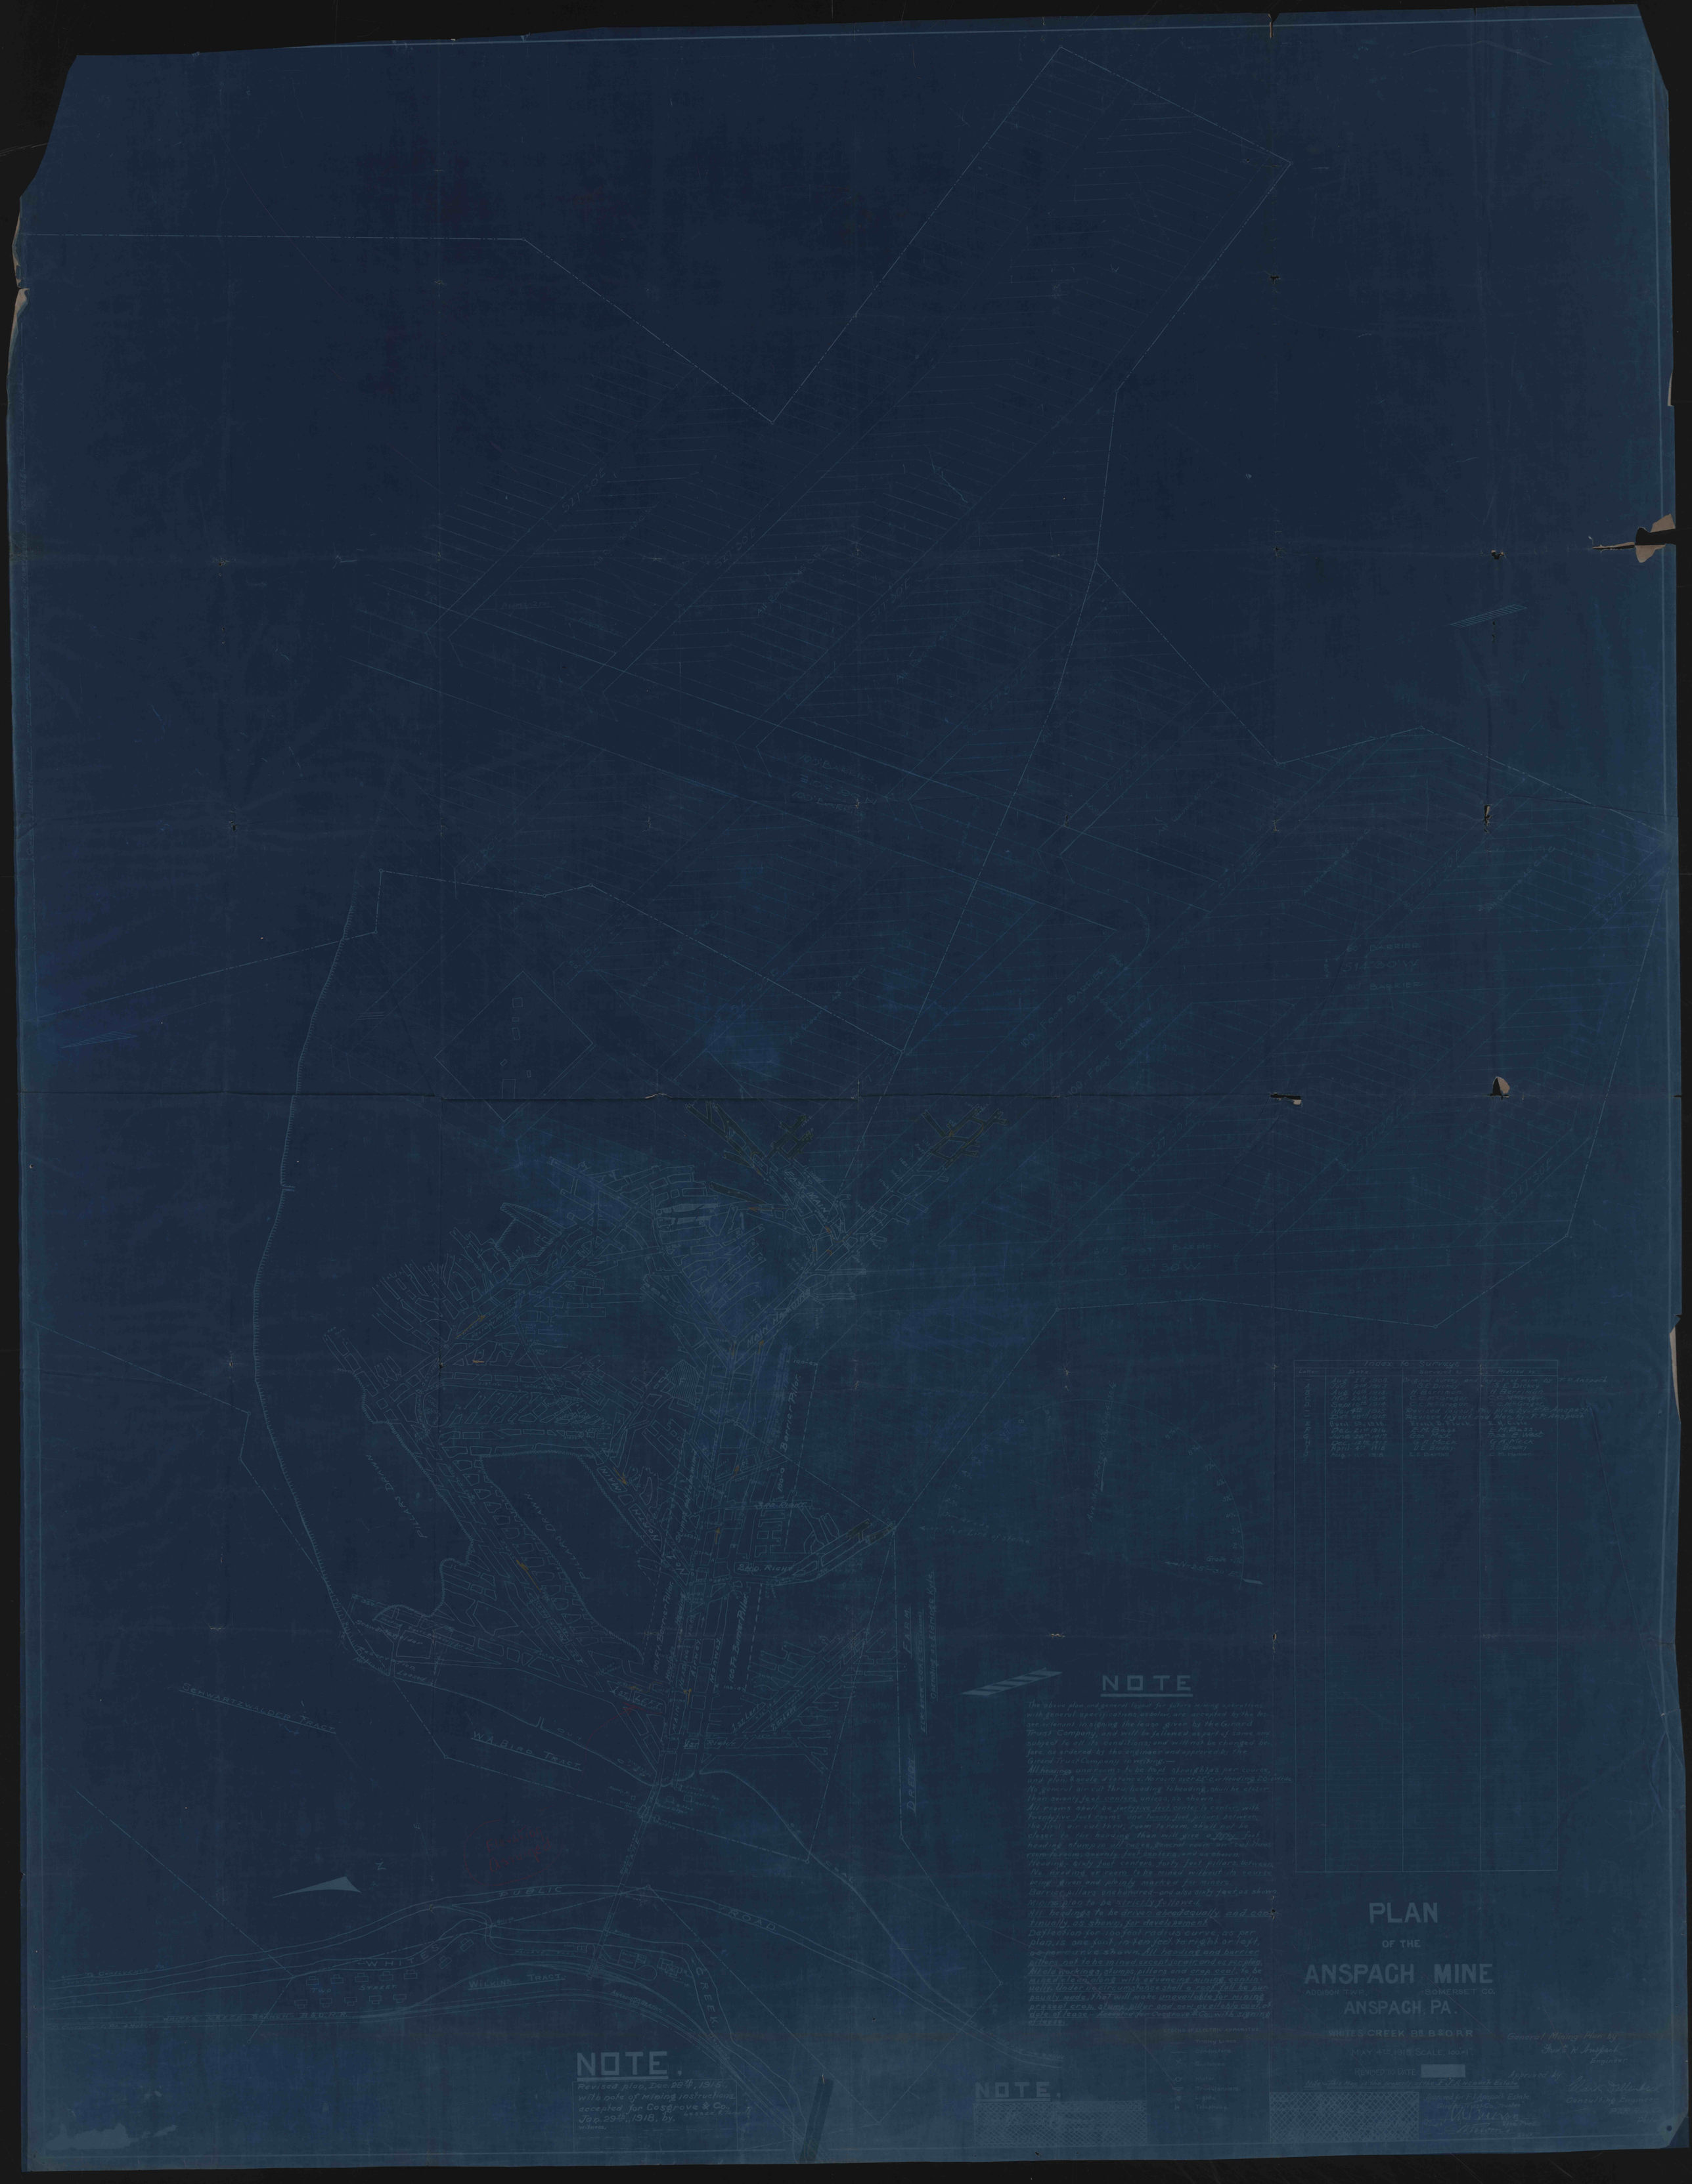
Index to Surveys
Date
Surveyed by
Drawn by
Revised plan, Dec. 29th, 1915.
with note of mining instructions,
accepted for Cosgrove & Co.
Jan. 29th, 1918, by.
Lessee & Owner
Witness.
NOTE
The above plan and general layout for future mining operations with general specifications as below, are accepted by the lessee or tenant in signing the lease given by the Girard Trust Company, and will be followed as part of same and subject to all its conditions; and will not be changed before as ordered by the engineer and approved by the Girard Trust Company in writing.—
All headings and rooms to be kept straightest per course, and plan, to scale distance. No room over 15 feet heading to drive.
No general air cut thru heading to heading shall be closer than seventy feet centers, unless as shown.
All rooms shall be forty five feet center to center with twenty five feet rooms and twenty feet pillars between.
The first air cut thru room to room, shall not be closer to the heading than will give a forty foot heading stump in all cases. General room air cut thru room to room, seventy feet centers, and as shown.
Heading, sixty feet centers, forty feet pillars between.
No heading or room to be mined without any causes being given and plainly marked for miners.
Barrier pillars one hundred and also sixty feet as shown.
Mining plan to be strictly followed.
All headings to be driven abreast equally and continually, as shown, for developement.
Deflection for no fixed radius curve, as per plan, is one foot, in ten feet to right or left as per curve shown. All heading and barrier pillars not to be mined except at rear ends as per plan.
All old workings, stumps, pillars and crop coal, to be mined as economical with advancing mining, caving walls, and surroundings shall be considered, as usually needs, that will make unavoidable for mining present crop, stump, pillar and new available coal at date of lease. Accepted per Cosgrove & Co. with signing of lease.
LEGEND OF ELECTRIC APPARATUS
Trolley Lines
Connections
Switches
Motors
Transformers
Lamps
Telephone
NOTE.
Revised plan, Dec. 29th, 1915.
with note of mining instructions,
accepted for Cosgrove & Co.
Jan. 29th, 1918, by.
Lessee & Owner
Witness.
NOTE.
PLAN
OF THE
ANSPACH MINE
ADDISON TWP. SOMERSET CO.
ANSPACH, PA.
WHITES CREEK B&B & O R R
MAY 4TH, 1915 SCALE, 100 ft
REDUCED TO DATE
Note: This plan is the property of the F. J. Ansbach Estate
Recorded in Ansbach Estate Property Title Co. Office
General Mining Plan by
Fred K. Ansbach
Engineer
Approved by
Consulting Engineer
Pittsburgh
Pa.
Scale of Miles
Scale of Feet
Two Street
Wilkins Tract
Public Road
Whites Creek
Schwartzwalder Tract
W. A. Bird Tract
Pillars Drawing
Main Haulage
Main Heading
Main Entry
Rock Barrier
Barrier Pillar
Barrier Pillar
Farm
Farm Area Not Included
Operating as Farm & Style
Grade
Grade
Grade