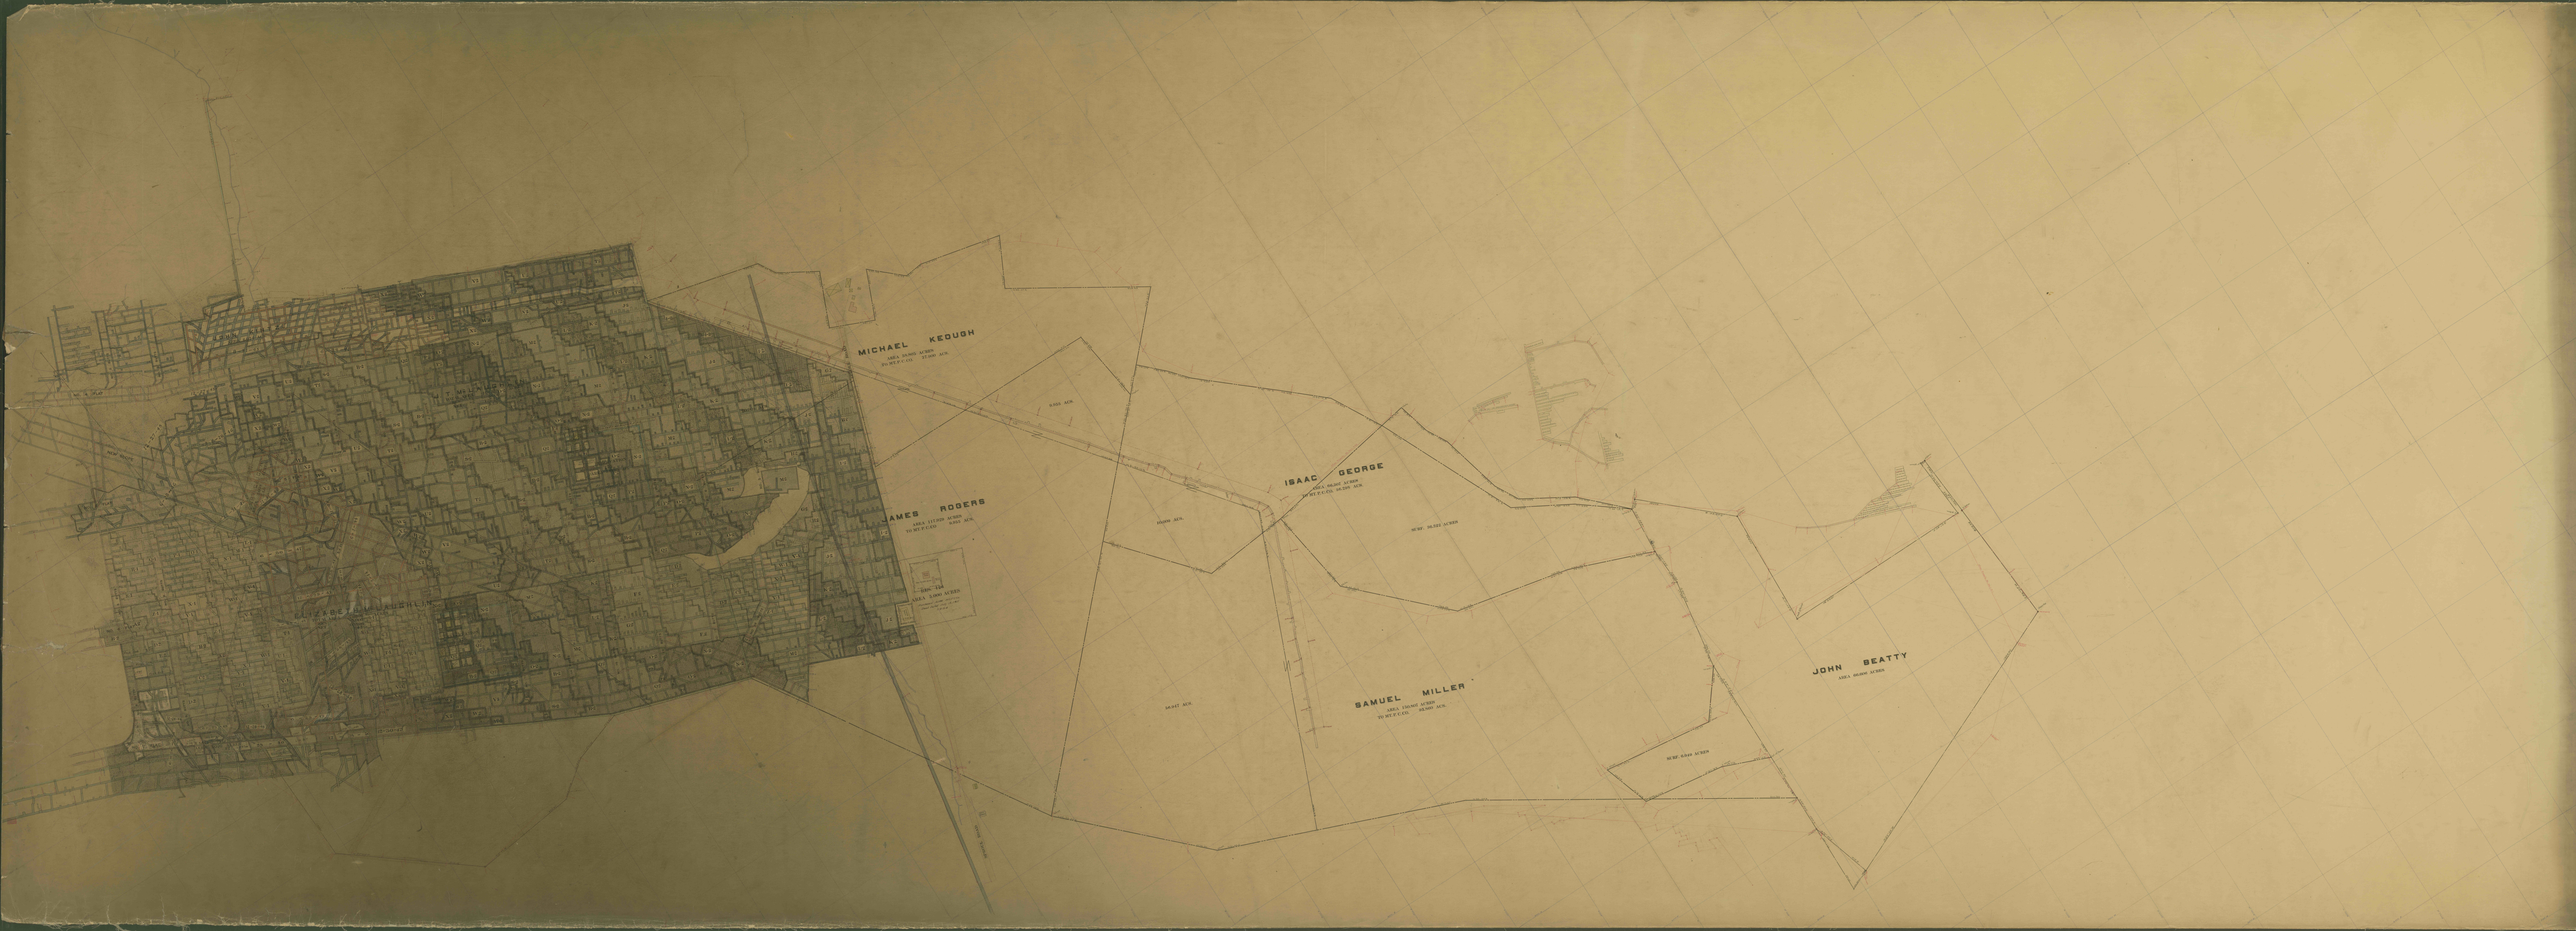
MICHAEL KEOUGH
AREA 39.9400 ACRES
TO REV. CO. 39.9400 ACR.
JAMES ROGERS
AREA 111.1000 ACRES
TO REV. CO. 110.1000 ACR.
ISAAC GEORGE
AREA 98.8400 ACRES
TO REV. CO. 98.8400 ACR.
SAMUEL MILLER
AREA 150.0000 ACRES
TO REV. CO. 150.0000 ACR.
JOHN BEATTY
AREA 80.0000 ACRES
AREA 3.5000 ACRES