


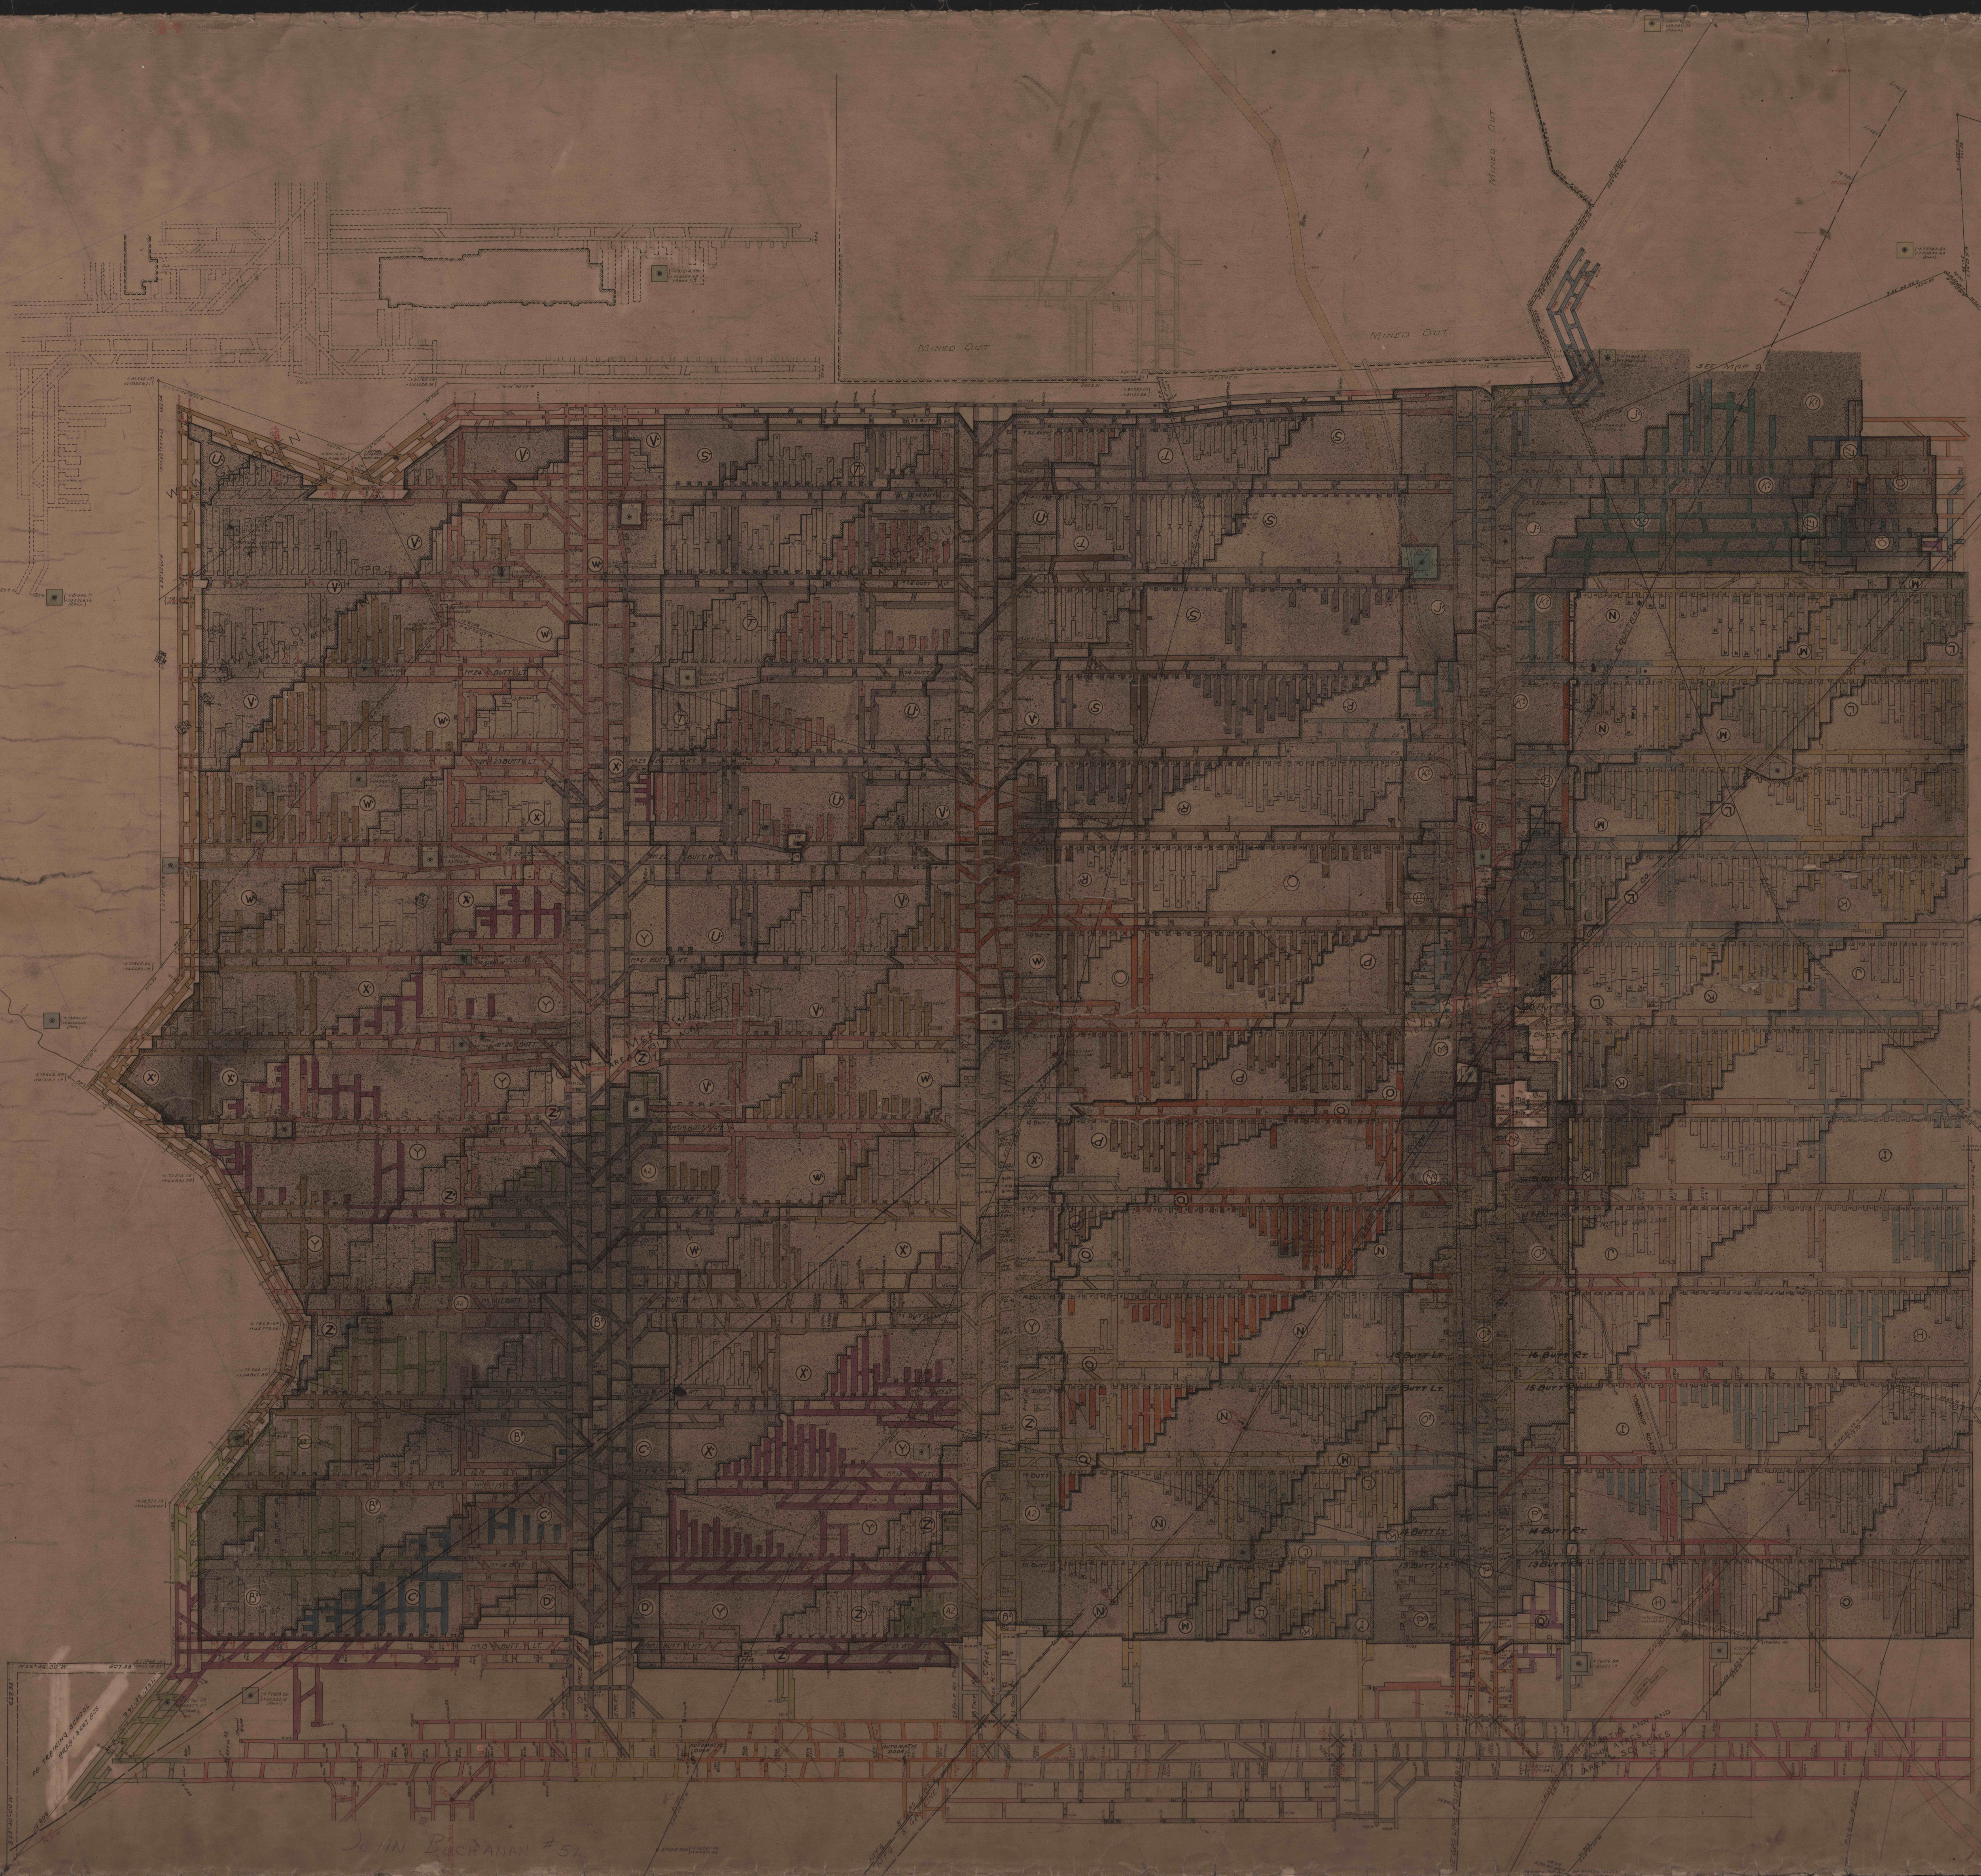

JOHN BUCHANAN #51