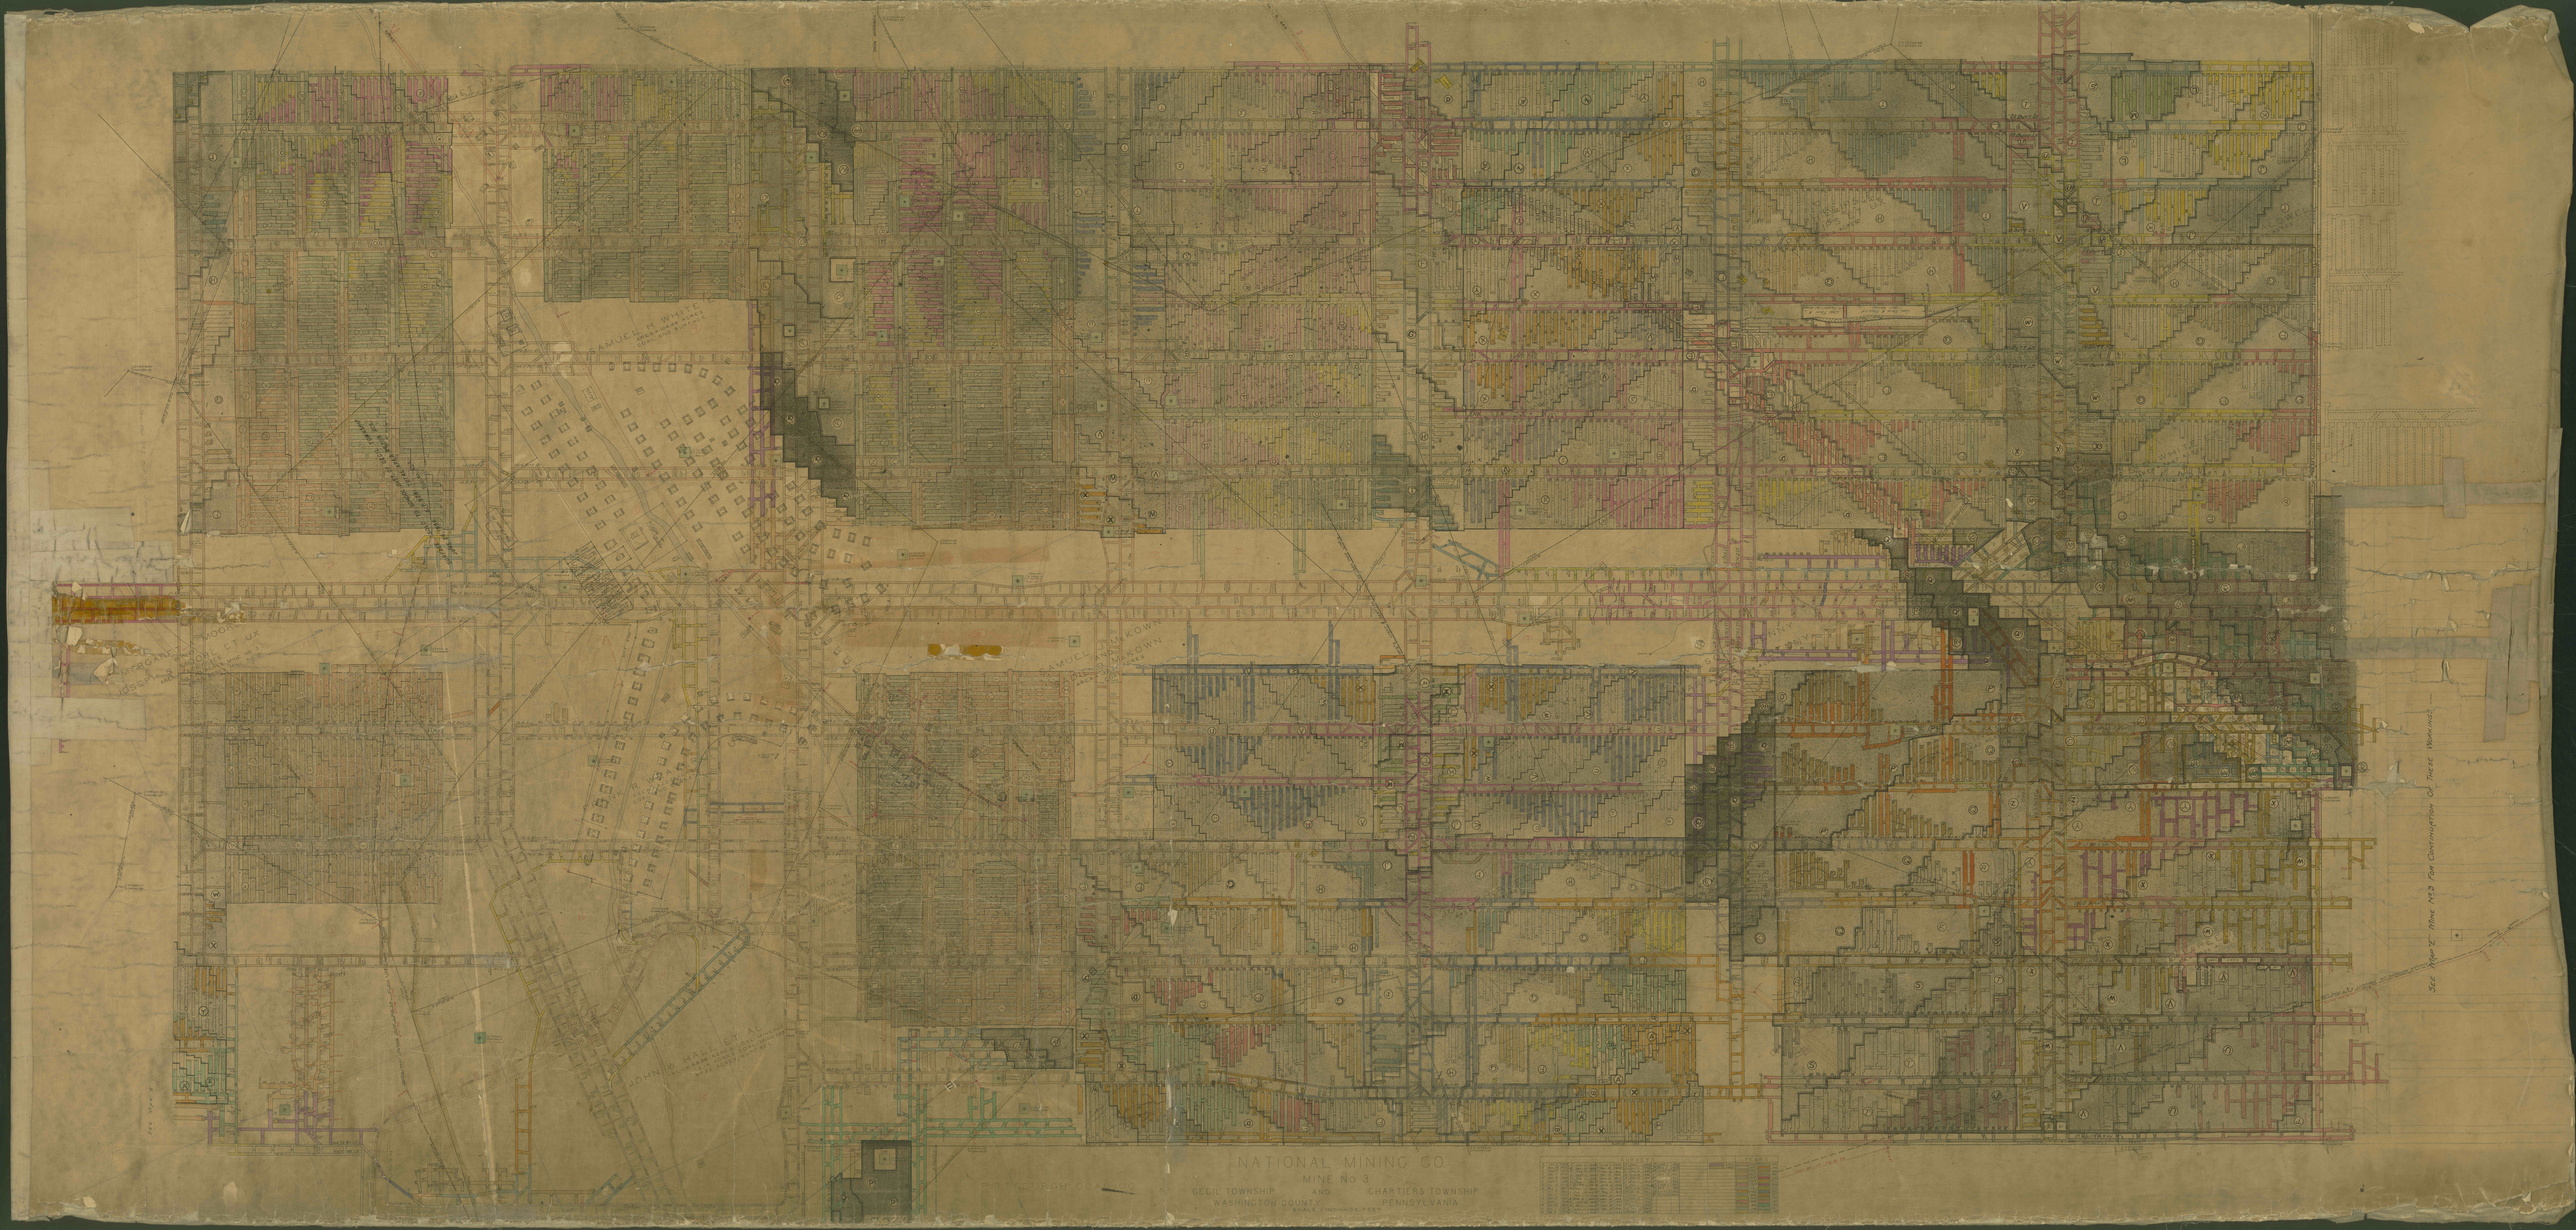

NATIONAL MINING CO.
MINE No 3
CECIL TOWNSHIP AND CHARTIERS TOWNSHIP
WASHINGTON COUNTY PENNSYLVANIA
SCALE 1 INCH = 100 FEET
See Plan E Mine No 3 for Continuation of These Workings