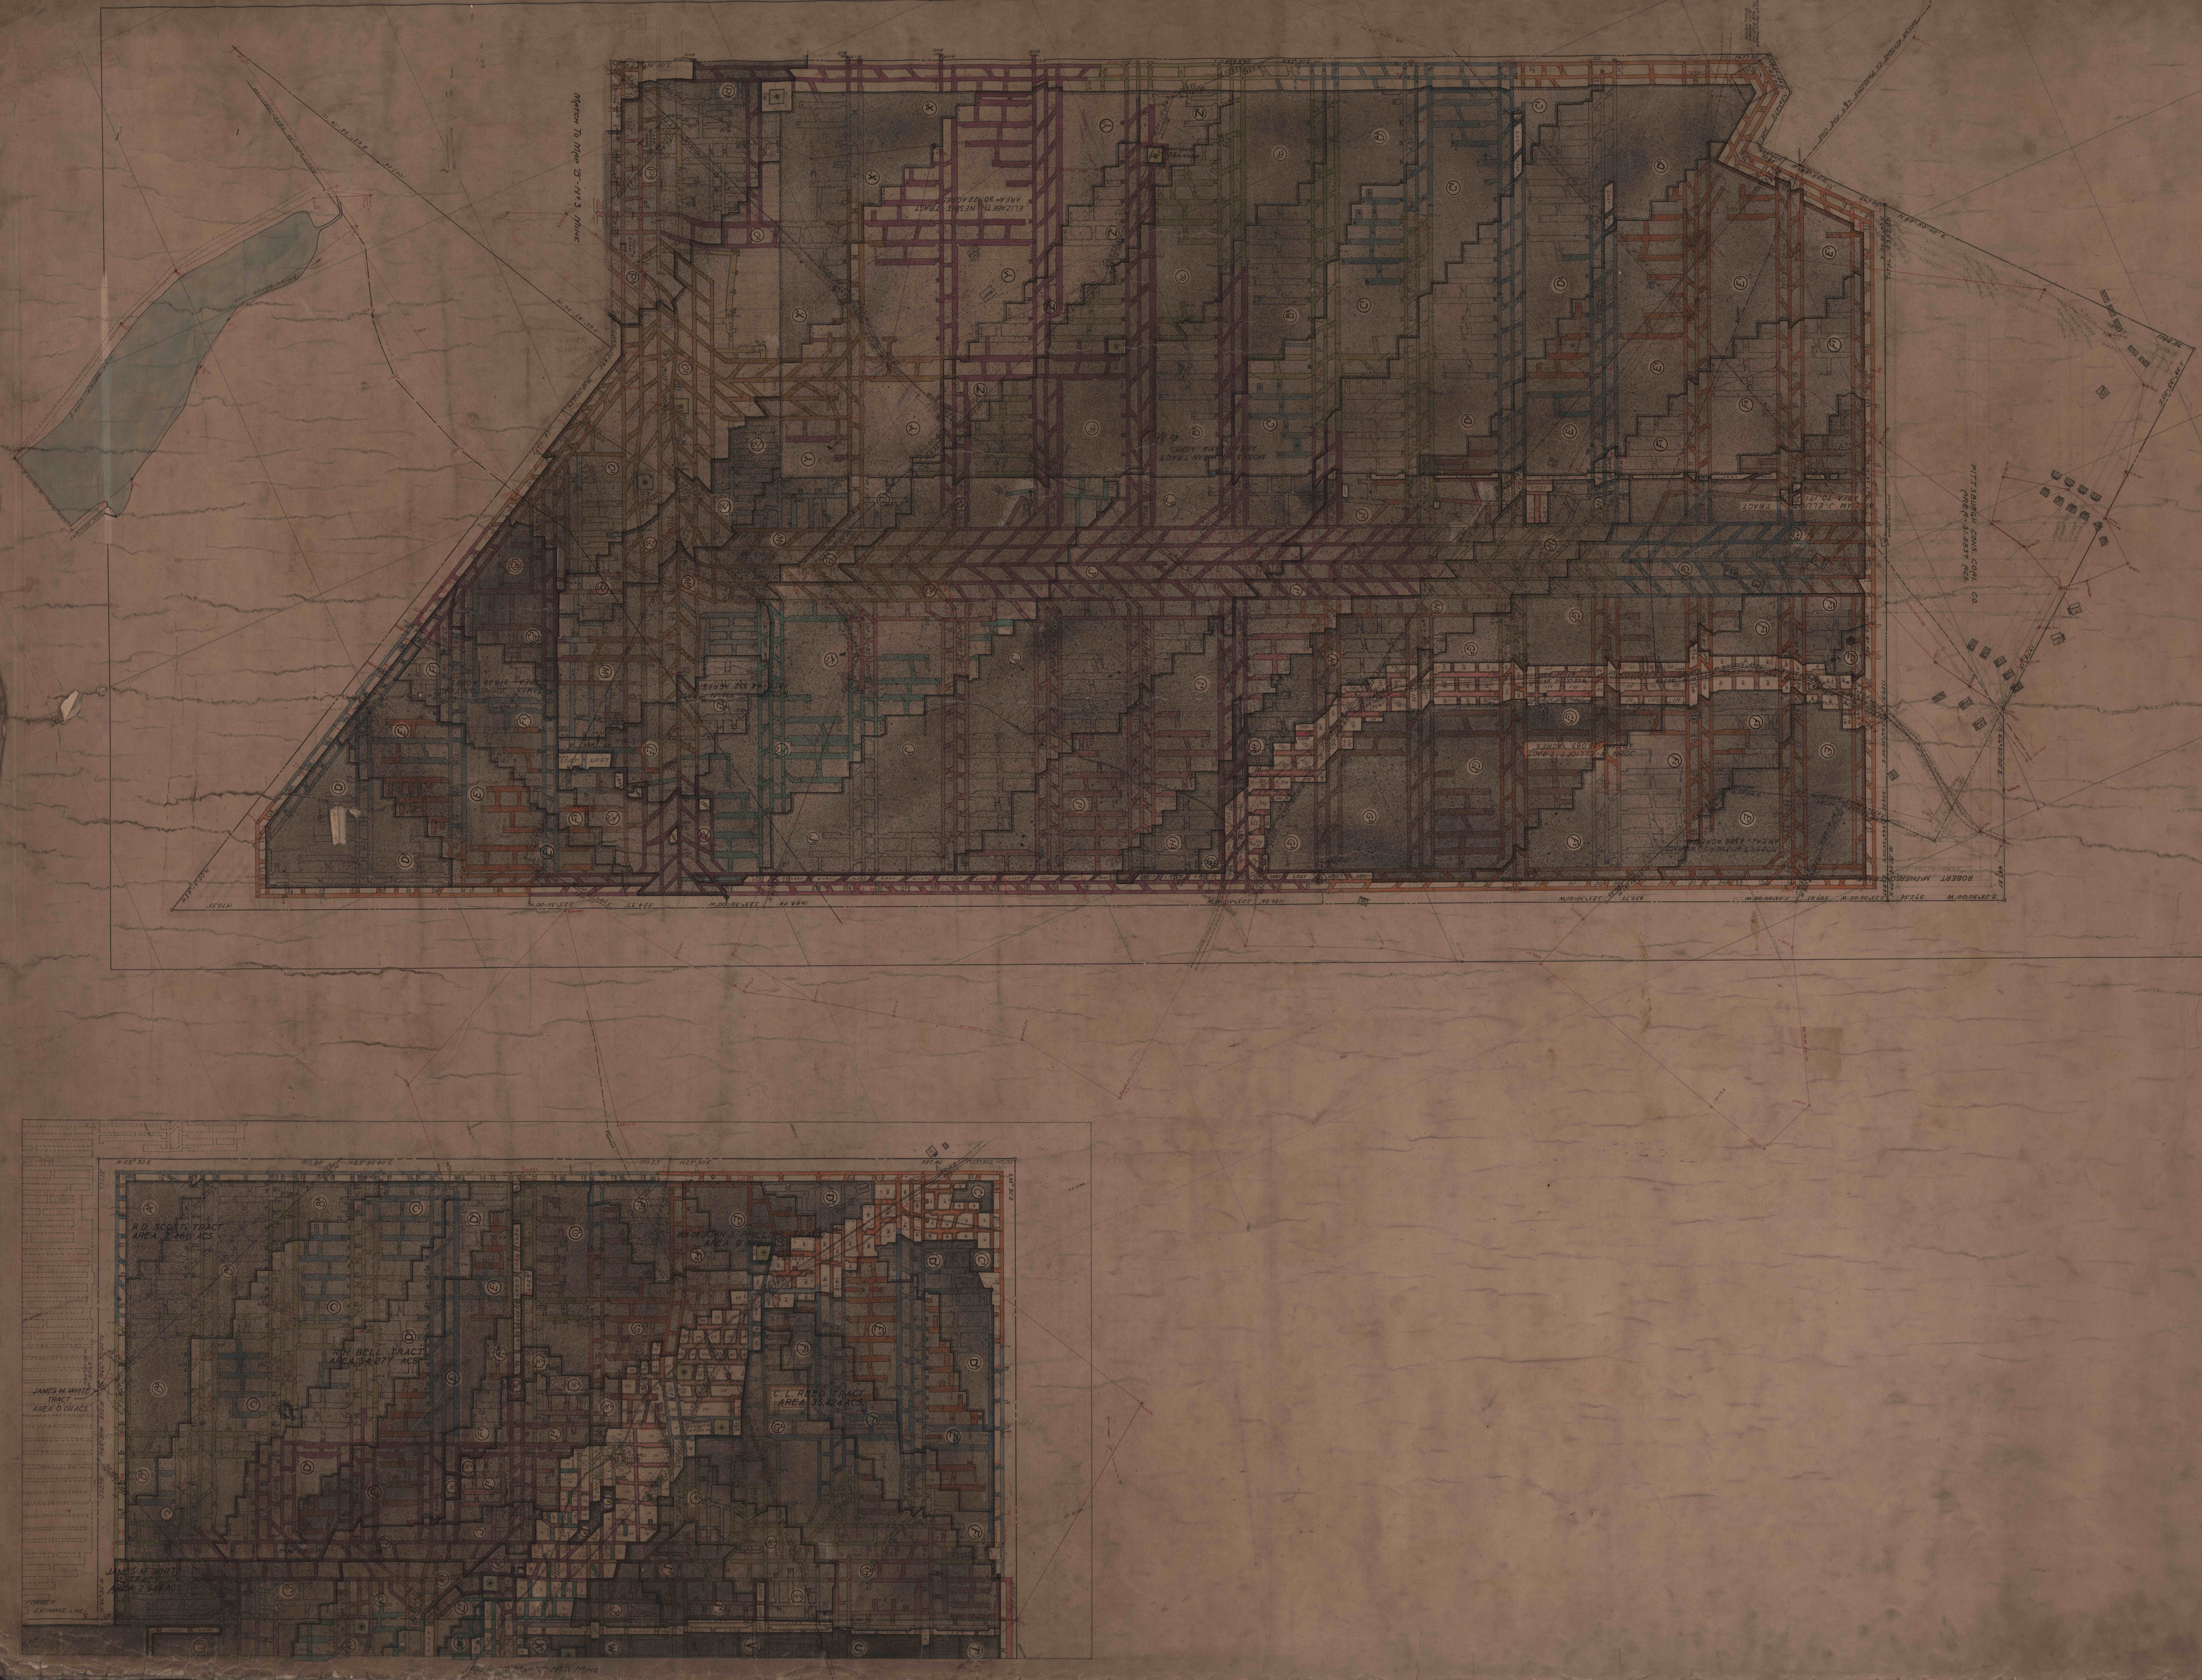

MATCH TO MAP "B" - Nº 3 MINE
HIGH WATER LINE
BUTT MAIN
ELIZABETH NESBIT TRACT
AREA = 30.122 ACRES
JAMES JOHNSTON TRACT
AREA 31.848 ACRES
JOHN W. ELLIOTT TRACT
AREA 29.063 ACRES
ROBERT McPHERSON TRACT
AREA 4.386 ACRES
ROBERT McPHERSON TRACT
PITTSBURGH CONS. COAL CO.
AREA 31.5839 ACS.
N 48°50'00" E
S 38°35'50" E
S 23°30'00" W
R.D. SCOTT TRACT
AREA 7.460 ACS.
R.H. BELL TRACT
AREA 54.277 ACS.
JAMES M. WHITE
TRACT
AREA 0.011 ACS.
JAMES M. WHITE
TRACT
AREA 2.944 ACS.
C.L. REED TRACT
AREA 35.424 ACS.
FORMER
EXCHANGE LINE
N 23°30' E
LOST