


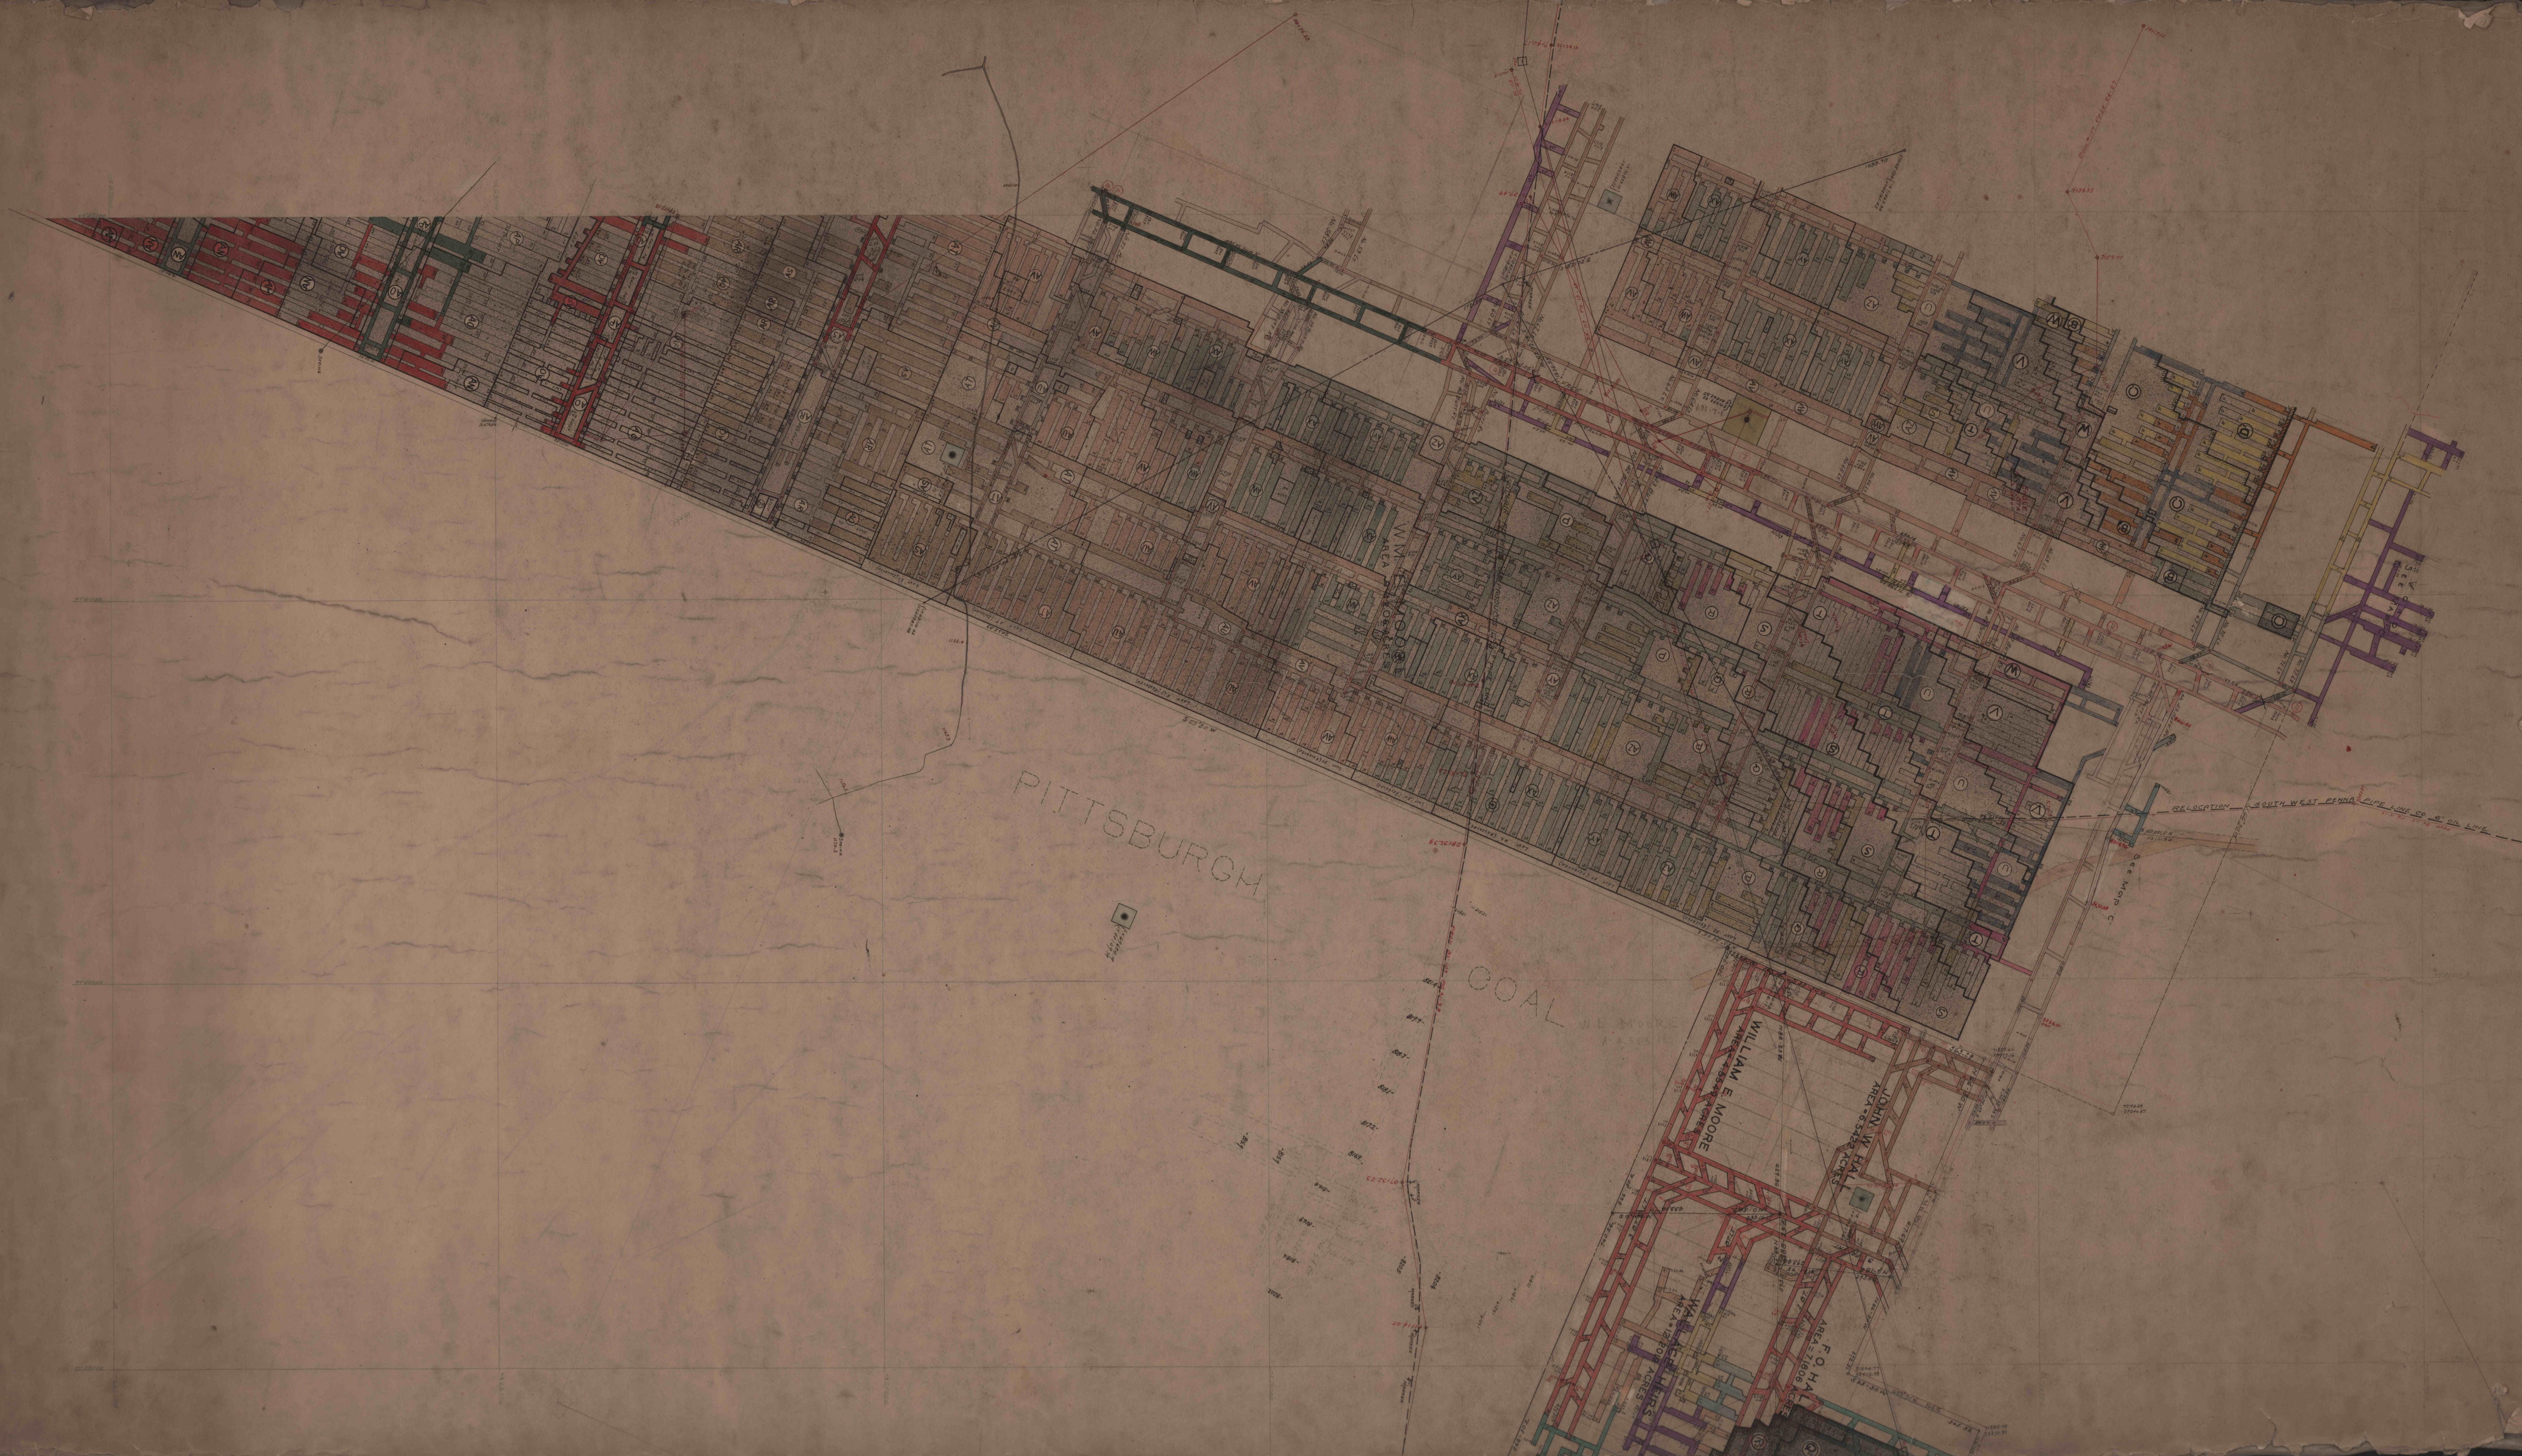

PITTSBURGH

COAL

WILLIAM E. MOORE

JOHN W. RAIL

FOH A