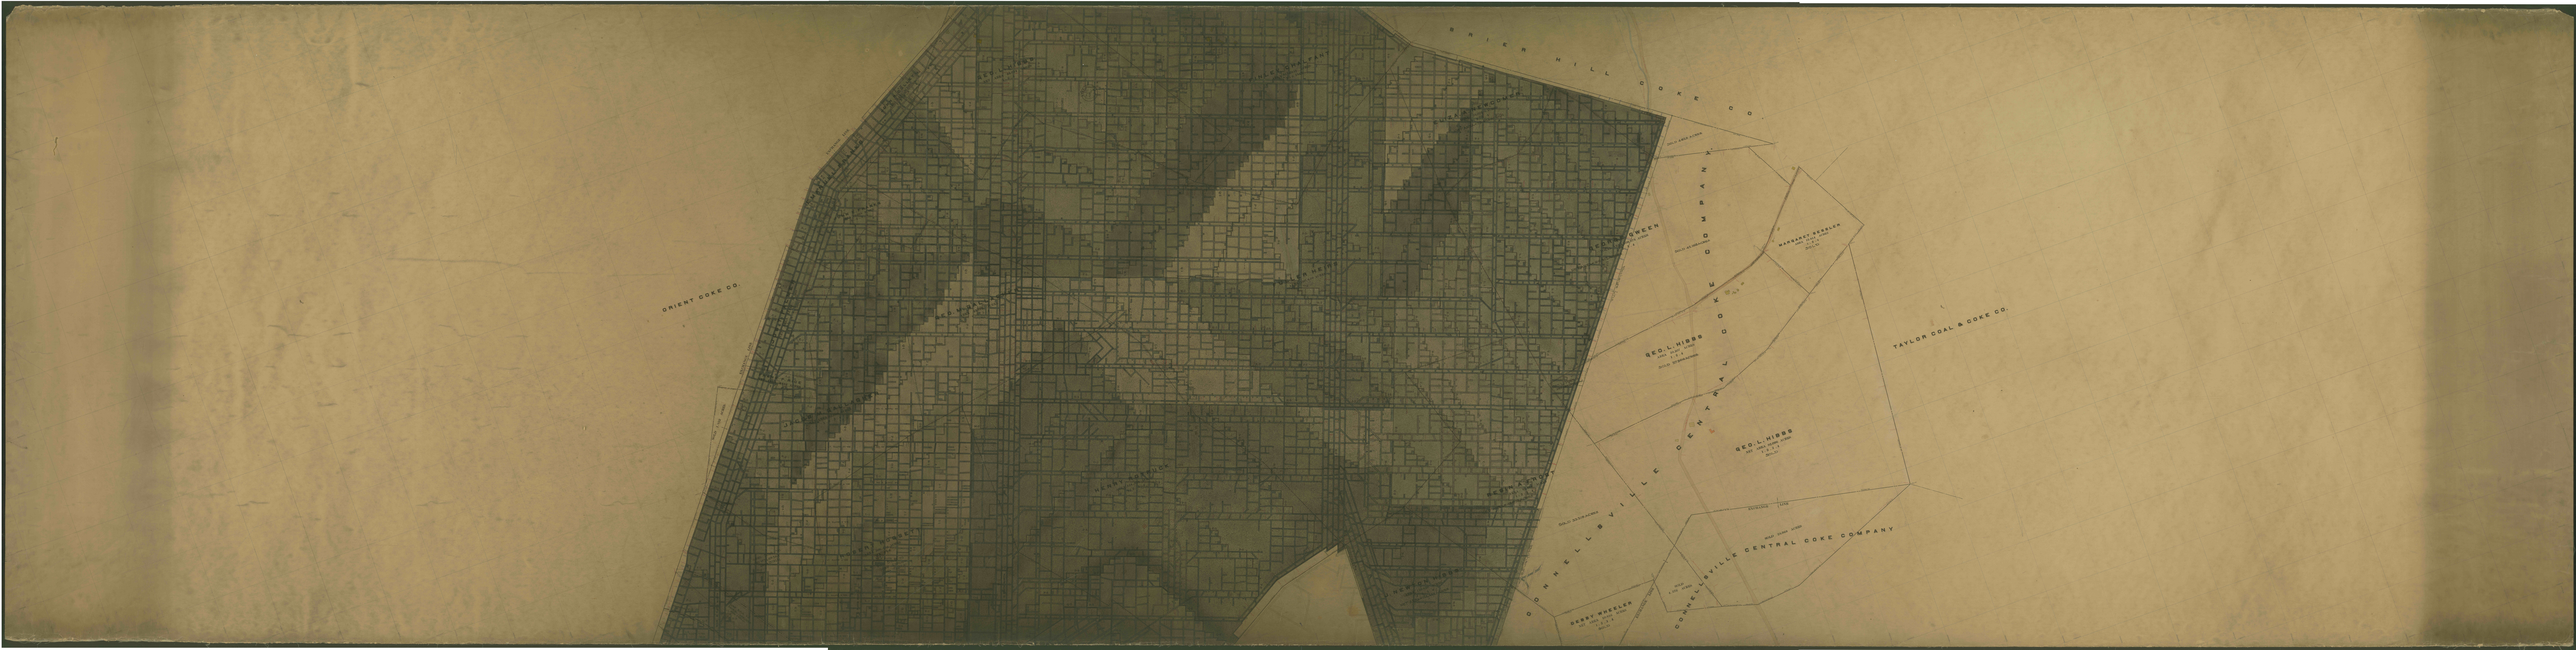

ORIENT COKE CO.
BRIER HILL COKE CO.
CONNELLSVILLE CENTRAL COKE COMPANY
GEO. L. HIBBS
TAYLOR COAL & COKE CO.
CONNELLSVILLE CENTRAL COKE COMPANY