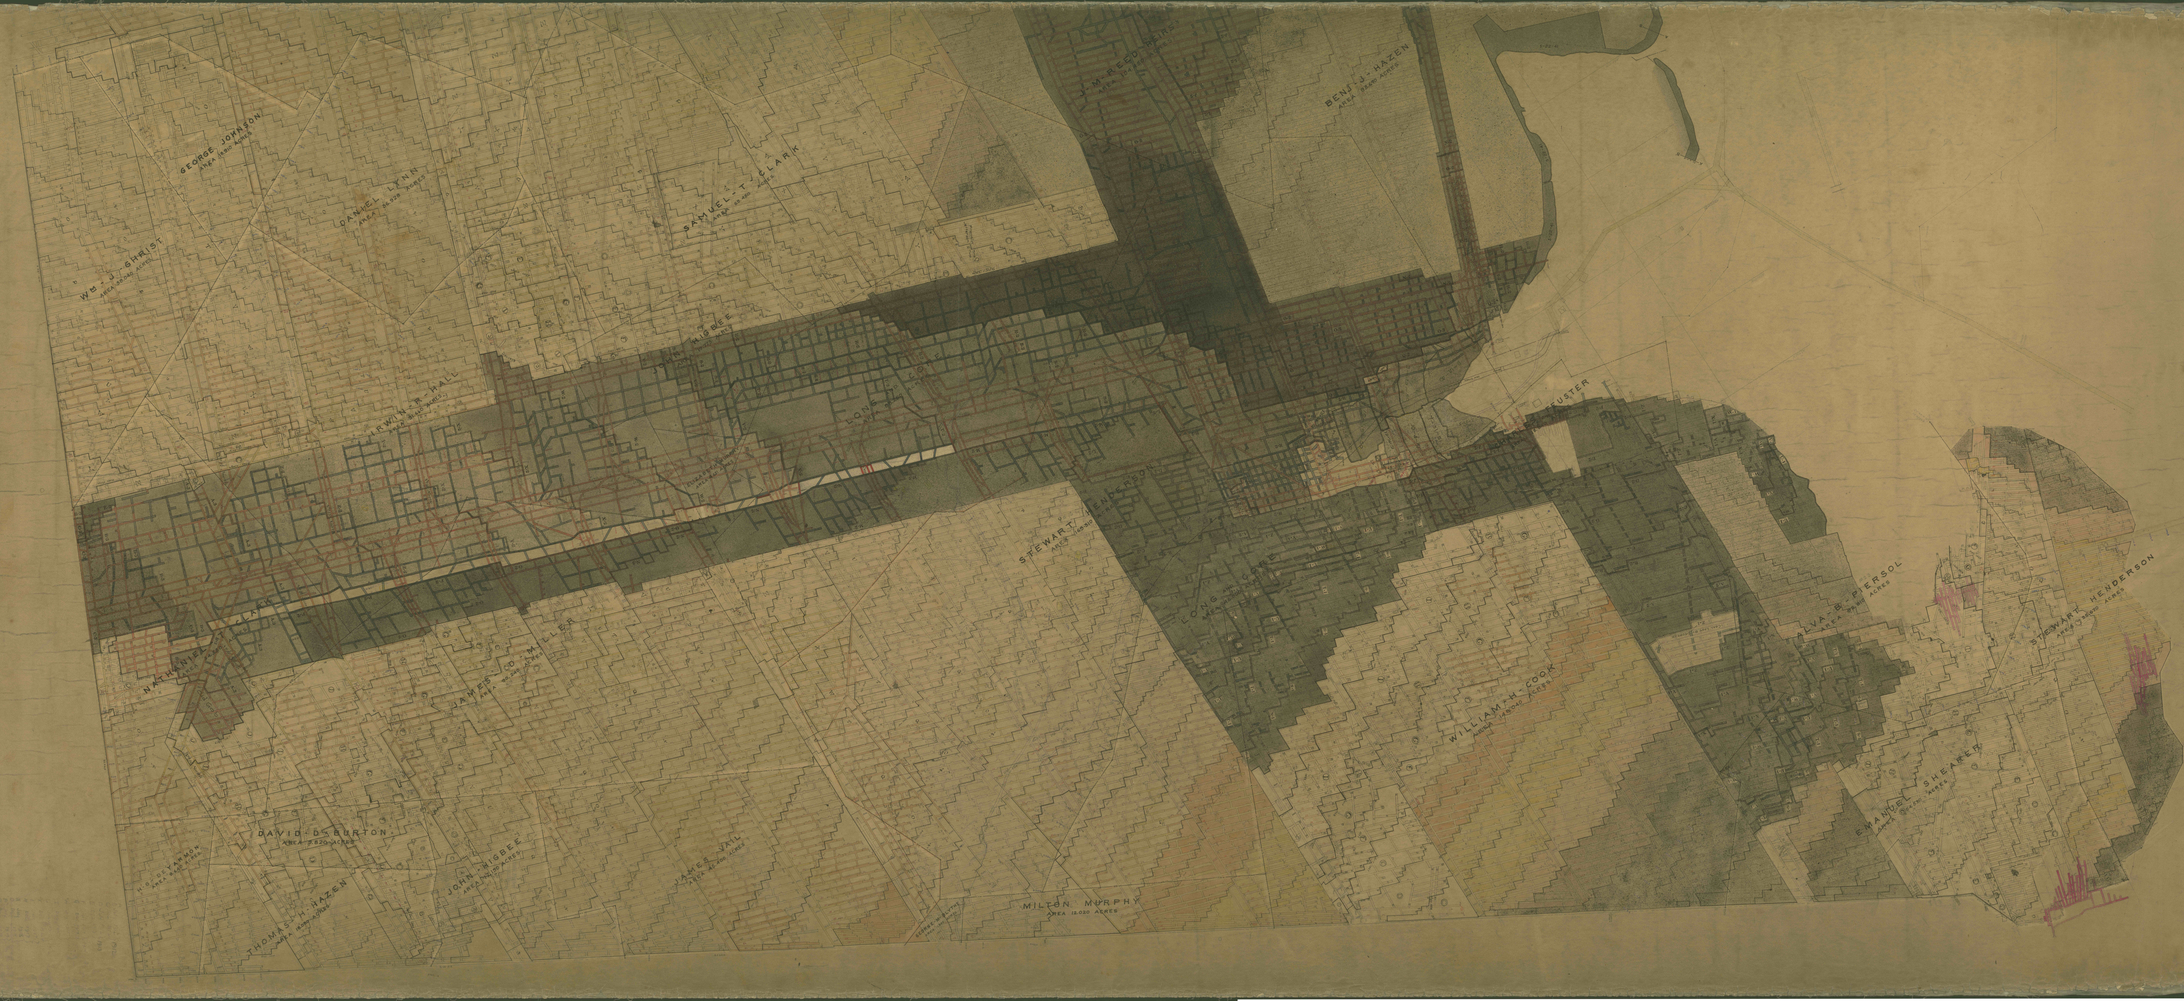

Wm J. GHRIST
AREA 38.040 ACRES
GEORGE JOHNSON
AREA 18.910 ACRES
DANIEL LYNN
AREA 36.928 ACRES
SAMUEL T. CLARK
AREA 69.450 ACRES
J. M. REED HEIRS
AREA 104.450 ACRES
BENJ. J. HAZEN
AREA 93.690 ACRES
IRWIN R. HALL
AREA 31.660 ACRES
JOHN HIGBEE
AREA 15.773 ACRES
LONG AND CORE
AREA 59.760 ACRES
ELIZABETH MURPHY
AREA 4.621 ACRES
STEWART HENDERSON
AREA 169.310 ACRES
LONG AND CORE
AREA 48.500 ACRES
CHARLES FEUSTER
NATHANIEL T. CLARK
AREA 54.550 ACRES
JAMES D. MILLER
AREA 90.240 ACRES
ALVA B. PIERSOL
AREA 32.810 ACRES
STEWART HENDERSON
AREA 85.670 ACRES
WILLIAM H. COOK
AREA 149.040 ACRES
EMANUEL SHEARER
AREA 54.530 ACRES
DAVID D. BURTON
AREA 9.820 ACRES
H. G. DEYARMON
AREA 9.640 ACRES
THOMAS H. HAZEN
AREA 16.080 ACRES
JOHN HIGBEE
AREA 12.150 ACRES
JAMES VAIL
AREA 45.400 ACRES
GEORGE M. BLYTHE
AREA 1.140 ACRES
MILTON MURPHY
AREA 12.020 ACRES
Coal Lost By Squeeze
Dec. 1926
July 1929
5-22-41
Jul 1912
Jan 1913
M Dec 1917
N July 1918
V Dec 1921
W July 1923
X Dec 1923
Y July 1924
Z Dec 1924
A July 1925
B Dec 1925
C July 1926
D Dec 1926
E July 1927
F Dec 1927
G July 1928
H Dec 1928
I July 1929
J Dec 1929