


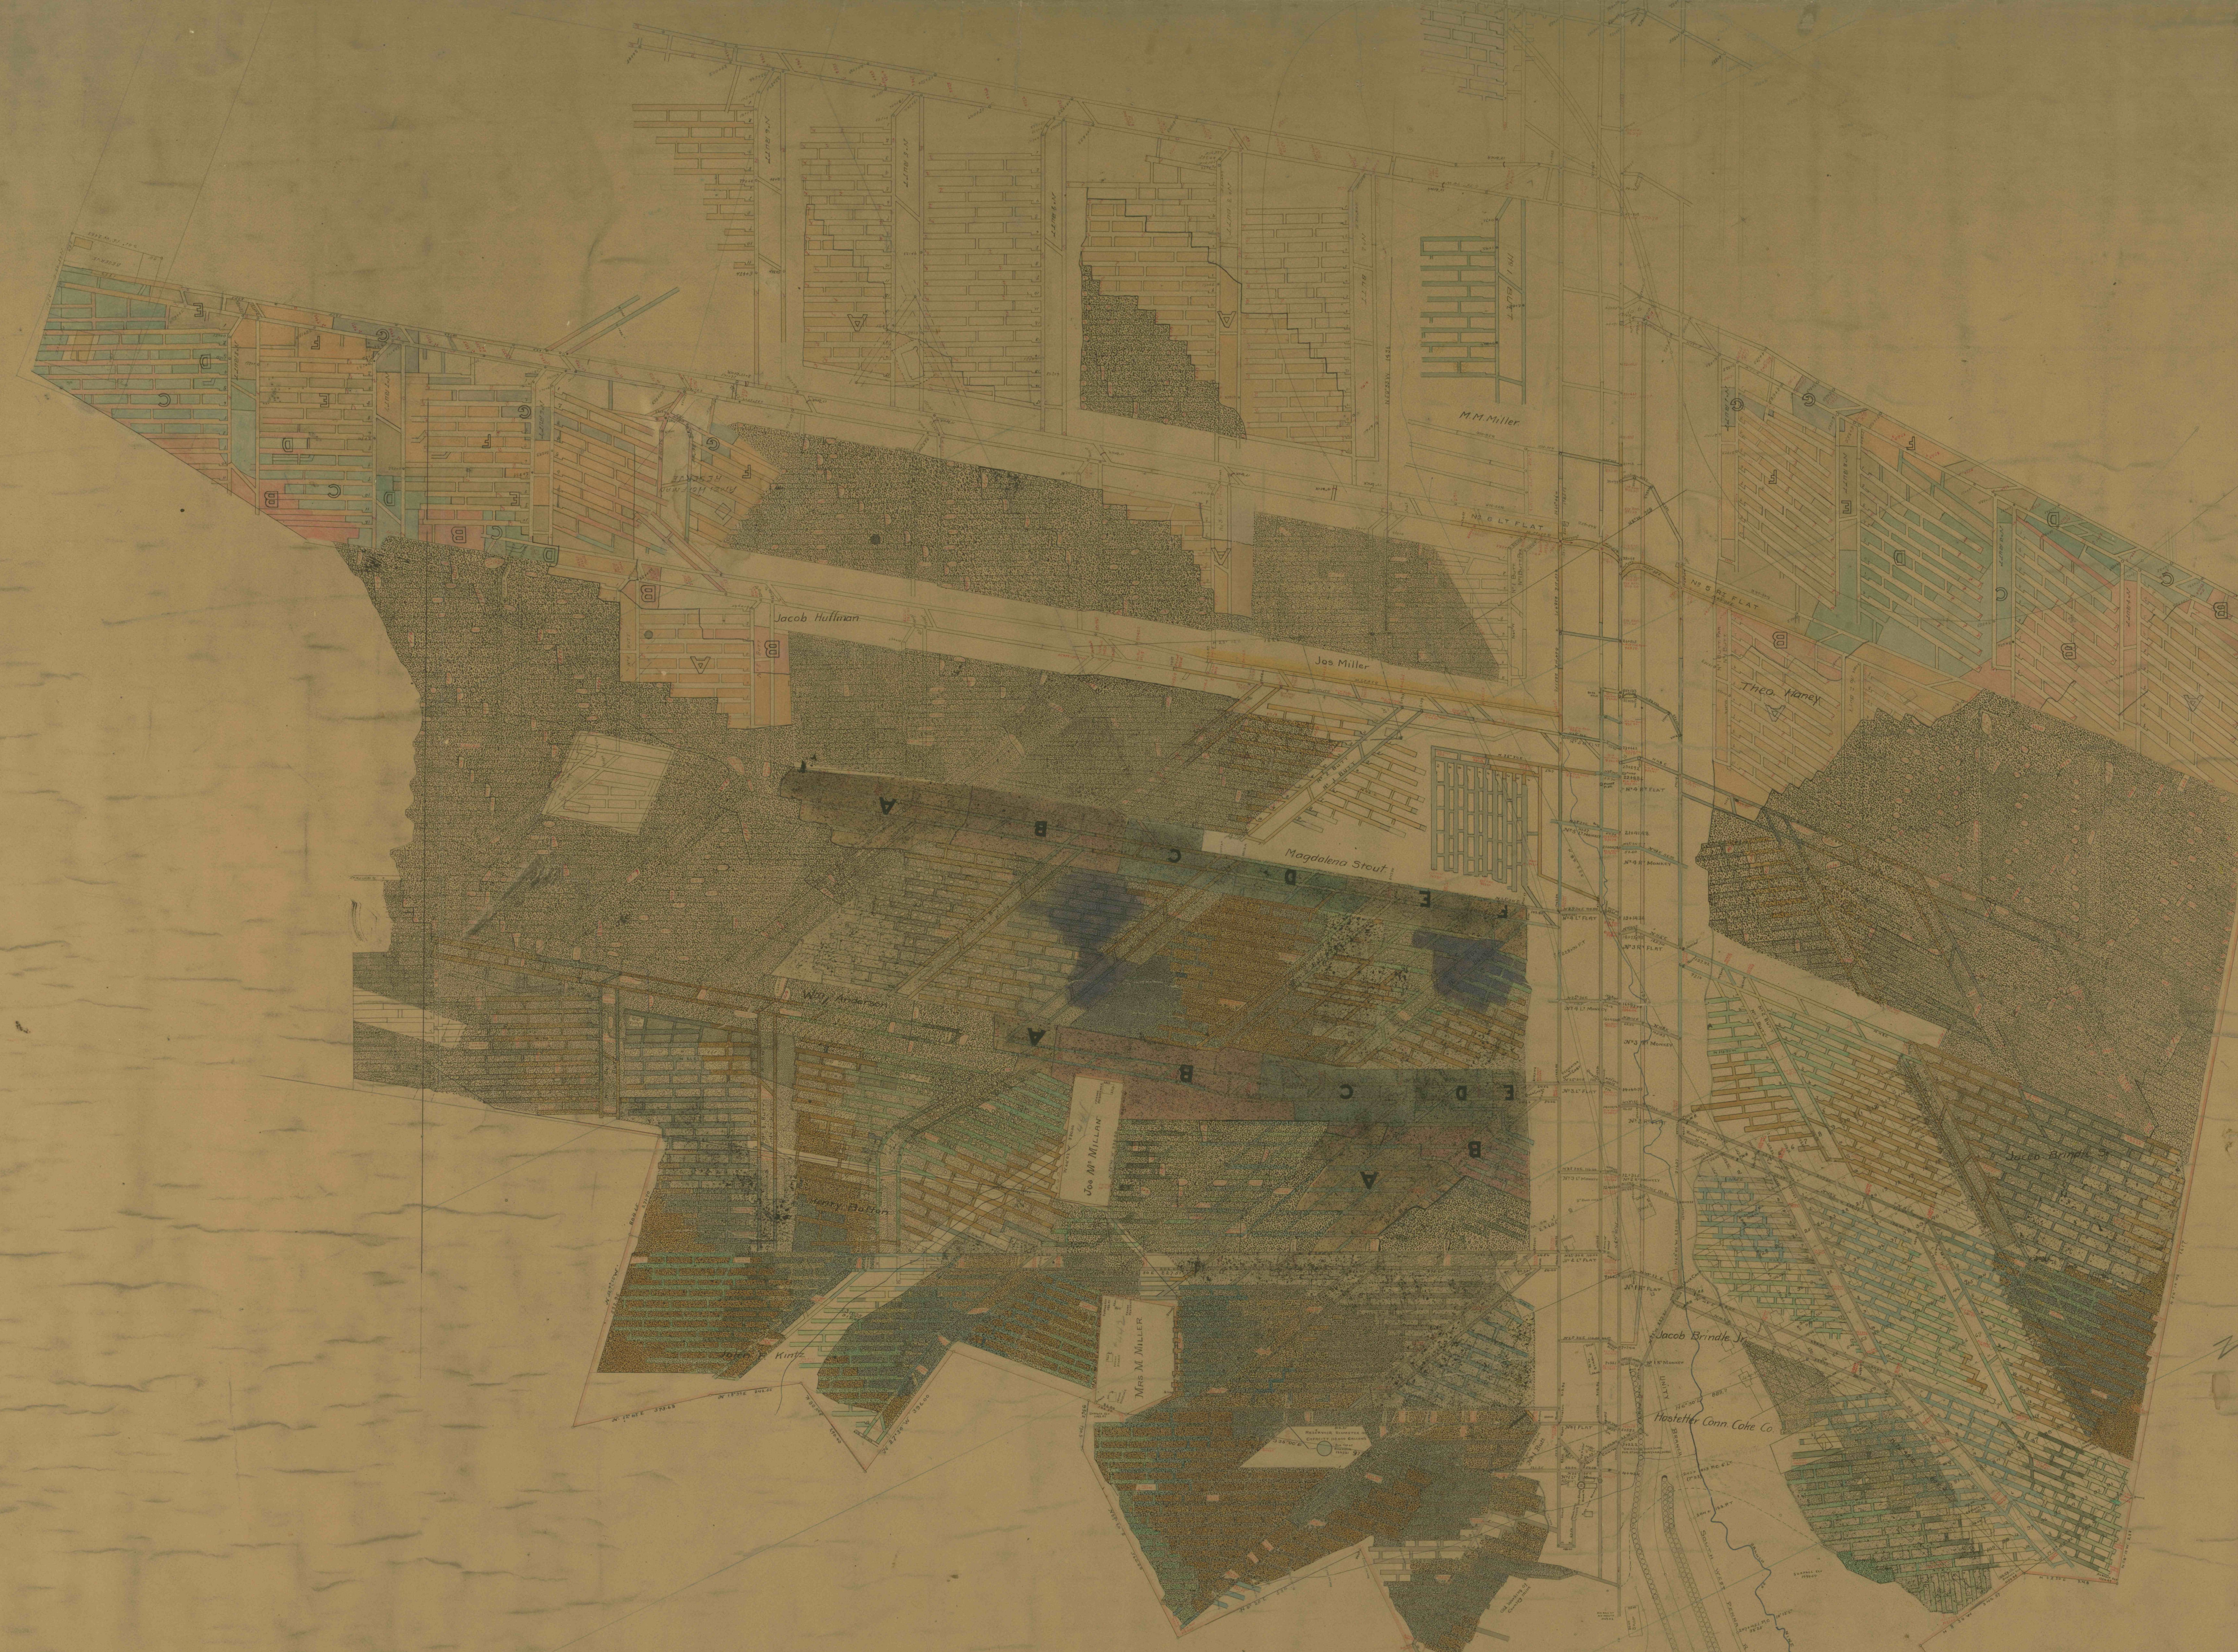

plan of
LIPPINCOTT MINE
— owned by —
The Hostetter Coke Co.
situate in
UNITY TWP.
WESTMORELAND CO. PA.

Scale: Each to 100 feet.

May 1891.



