


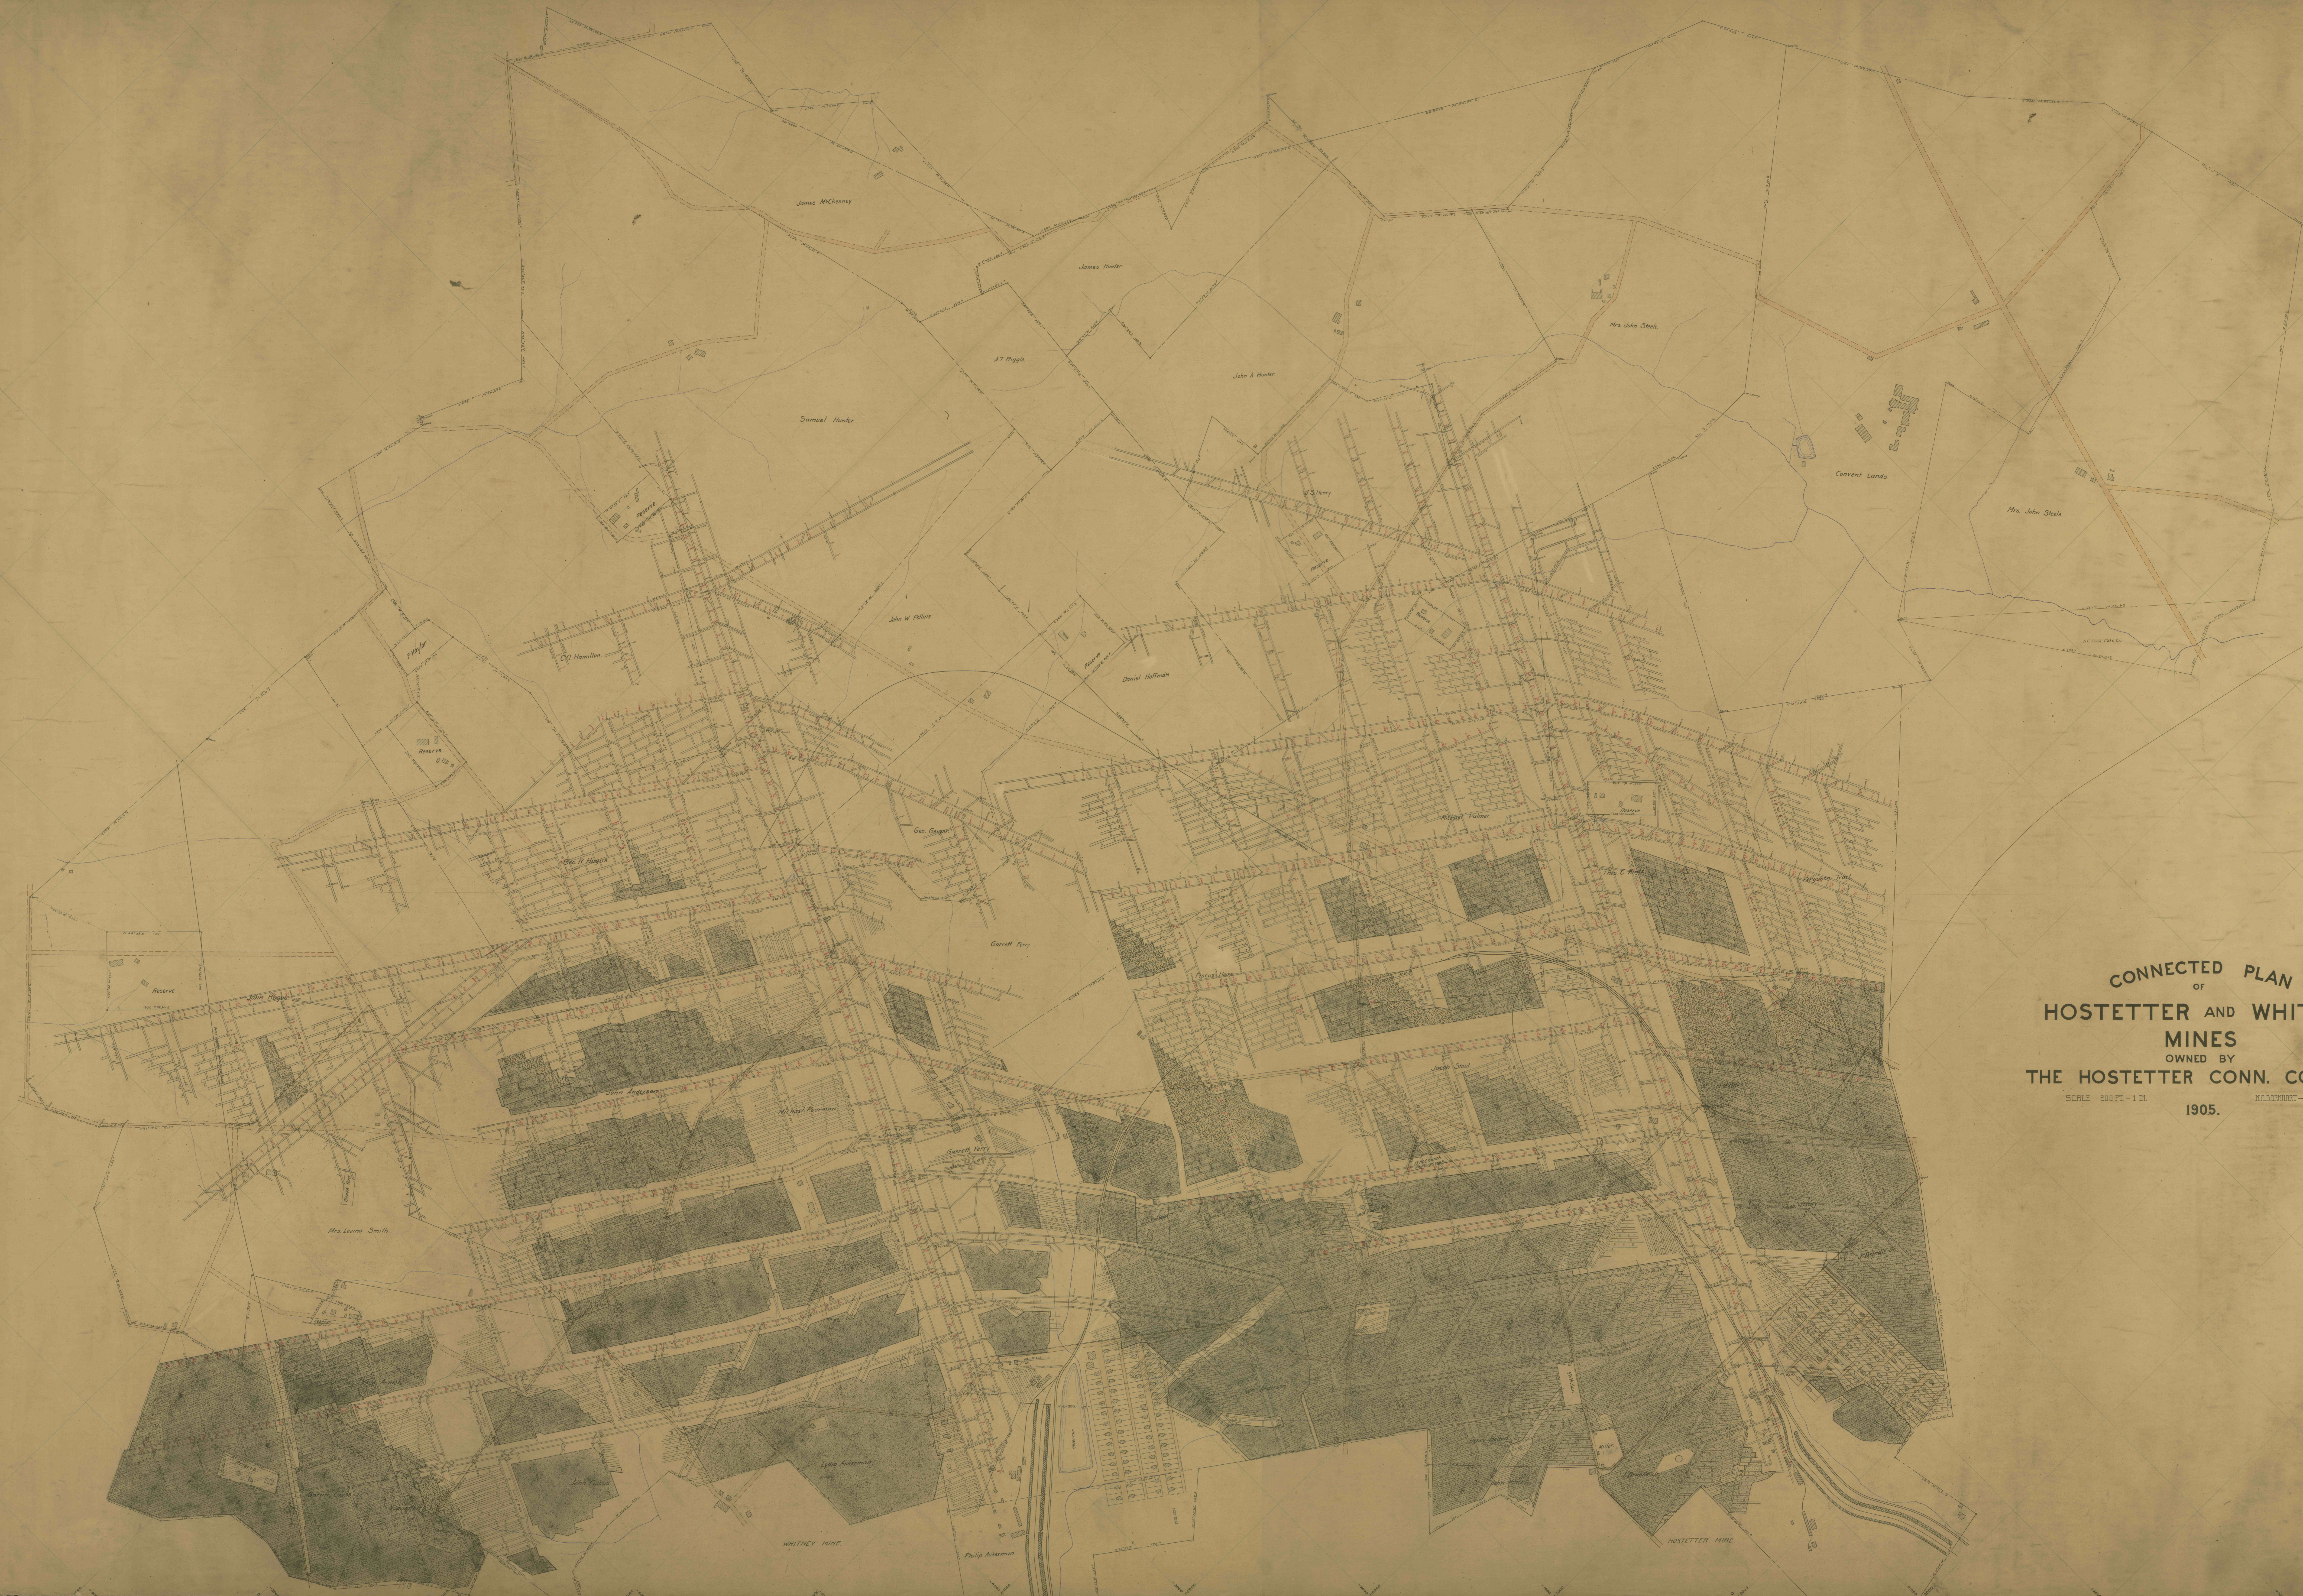

CONNECTED PLAN
OF
HOSTETTER AND WHITNEY
MINES
OWNED BY
THE HOSTETTER CONN. COKE CO.
SCALE 200 FT. = 1 IN.
1905.