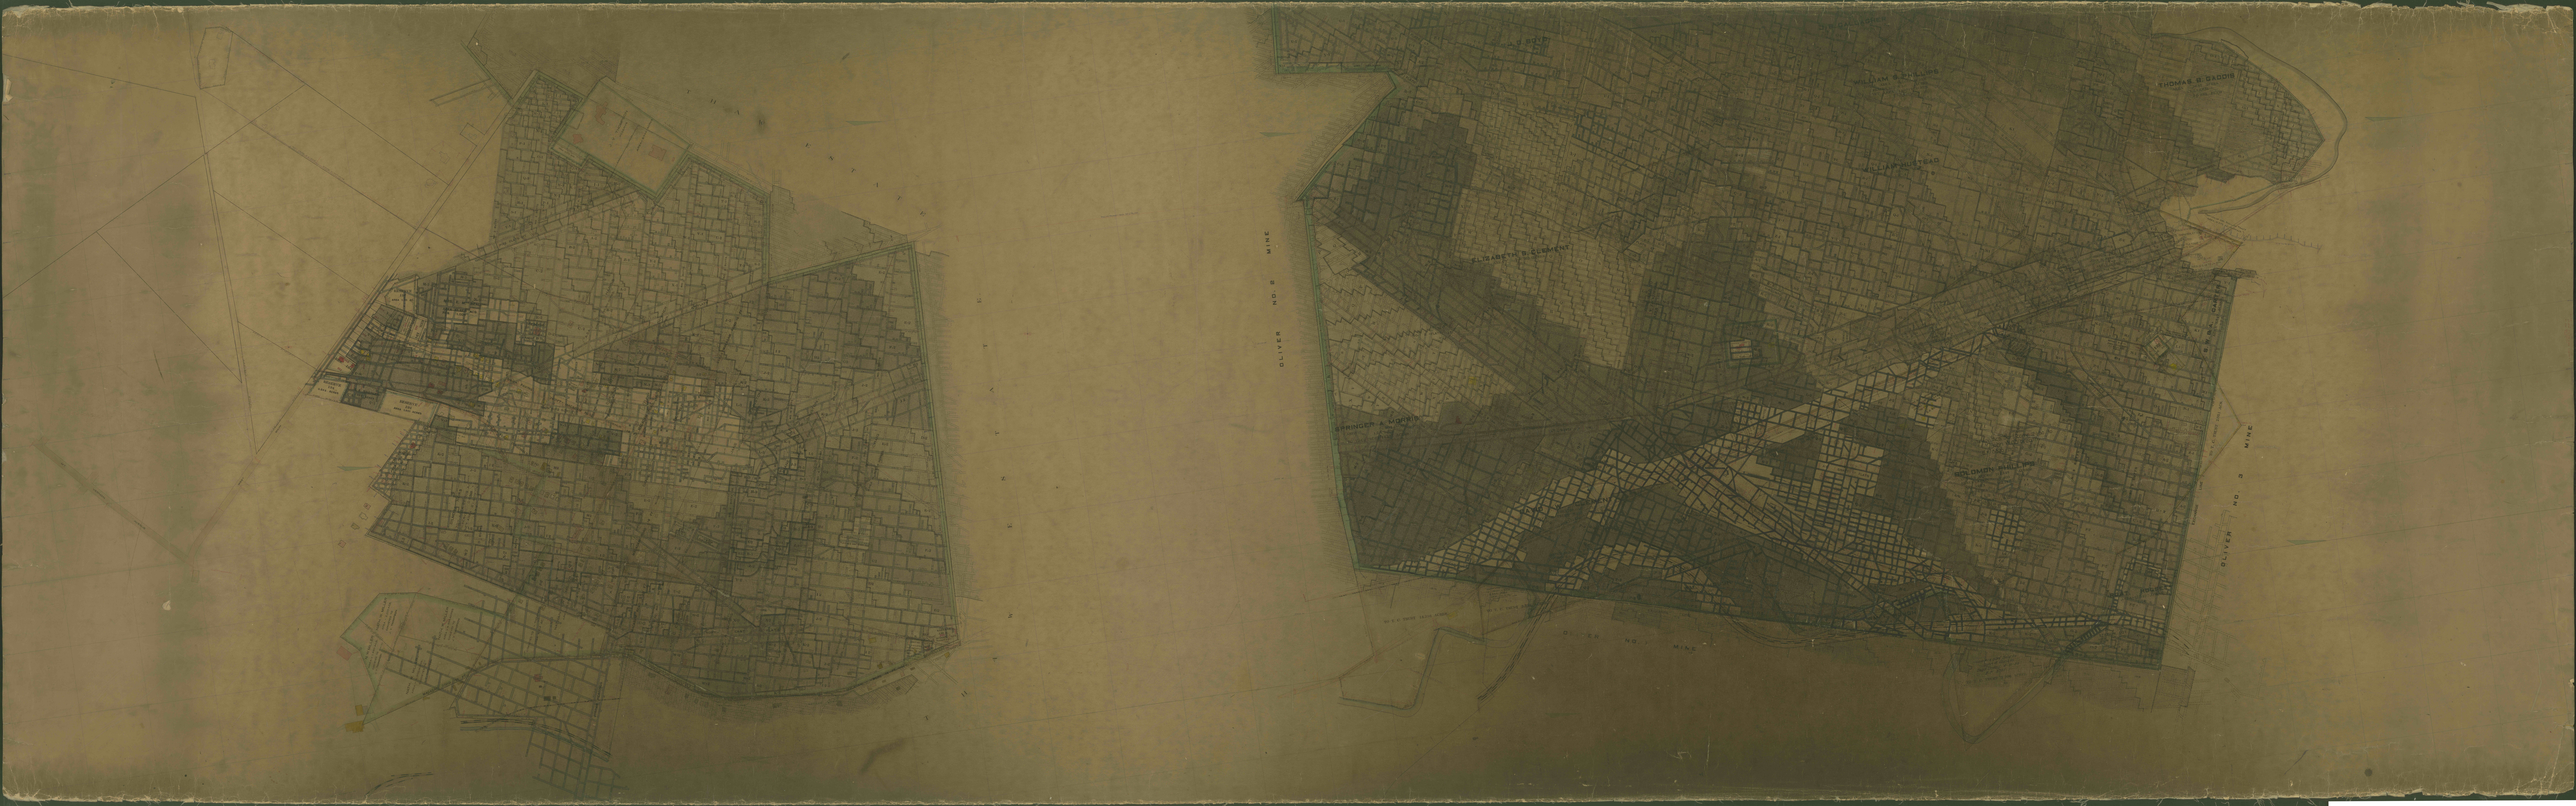
OLIVER NO 8 MINE
OLIVER NO 3 MINE
ELIZABETH B. CLEMENT
SPRINGER A. WOOD
WILLIAM S. KNAUSS
WILLIAM HOMESTEAD
THOMAS B. DADDIS
MONUMENT HILL