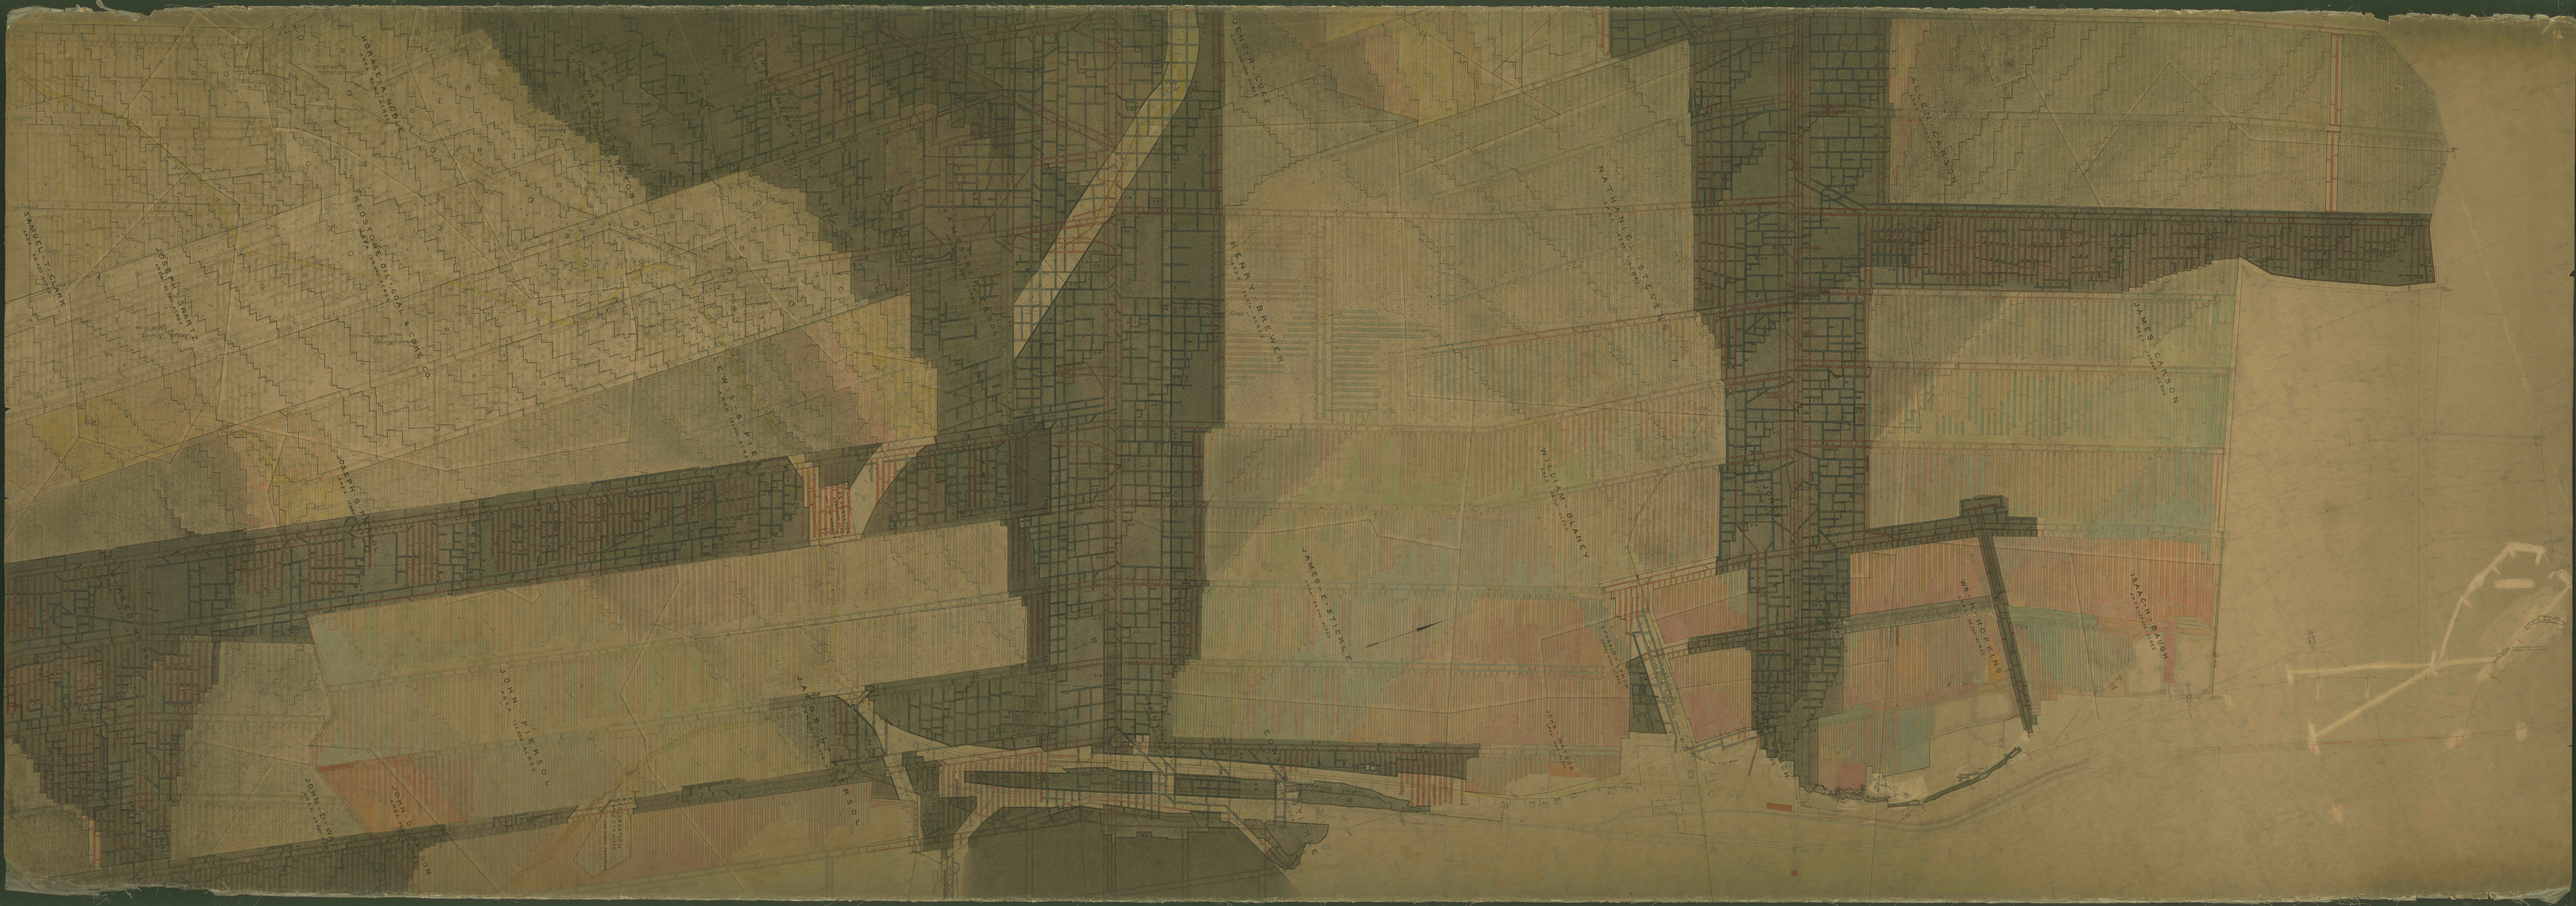
HORATIO NOBLE
JOSEPH SMART
SAMUEL T. CLARK
E.W.S. GRIFFIN
JOSEPH GLOVER
WILLIAM GLOVER
JOHN P. PIERSON
JOHN O. PIERSON
JOHN O'NEIL
JACOB PIERSON
HENRY J. BREWER
NATHANIEL STEVENS
WILLIAM BLANEY
JOSEPH WALKER
WILLIAM HOPKINS
