


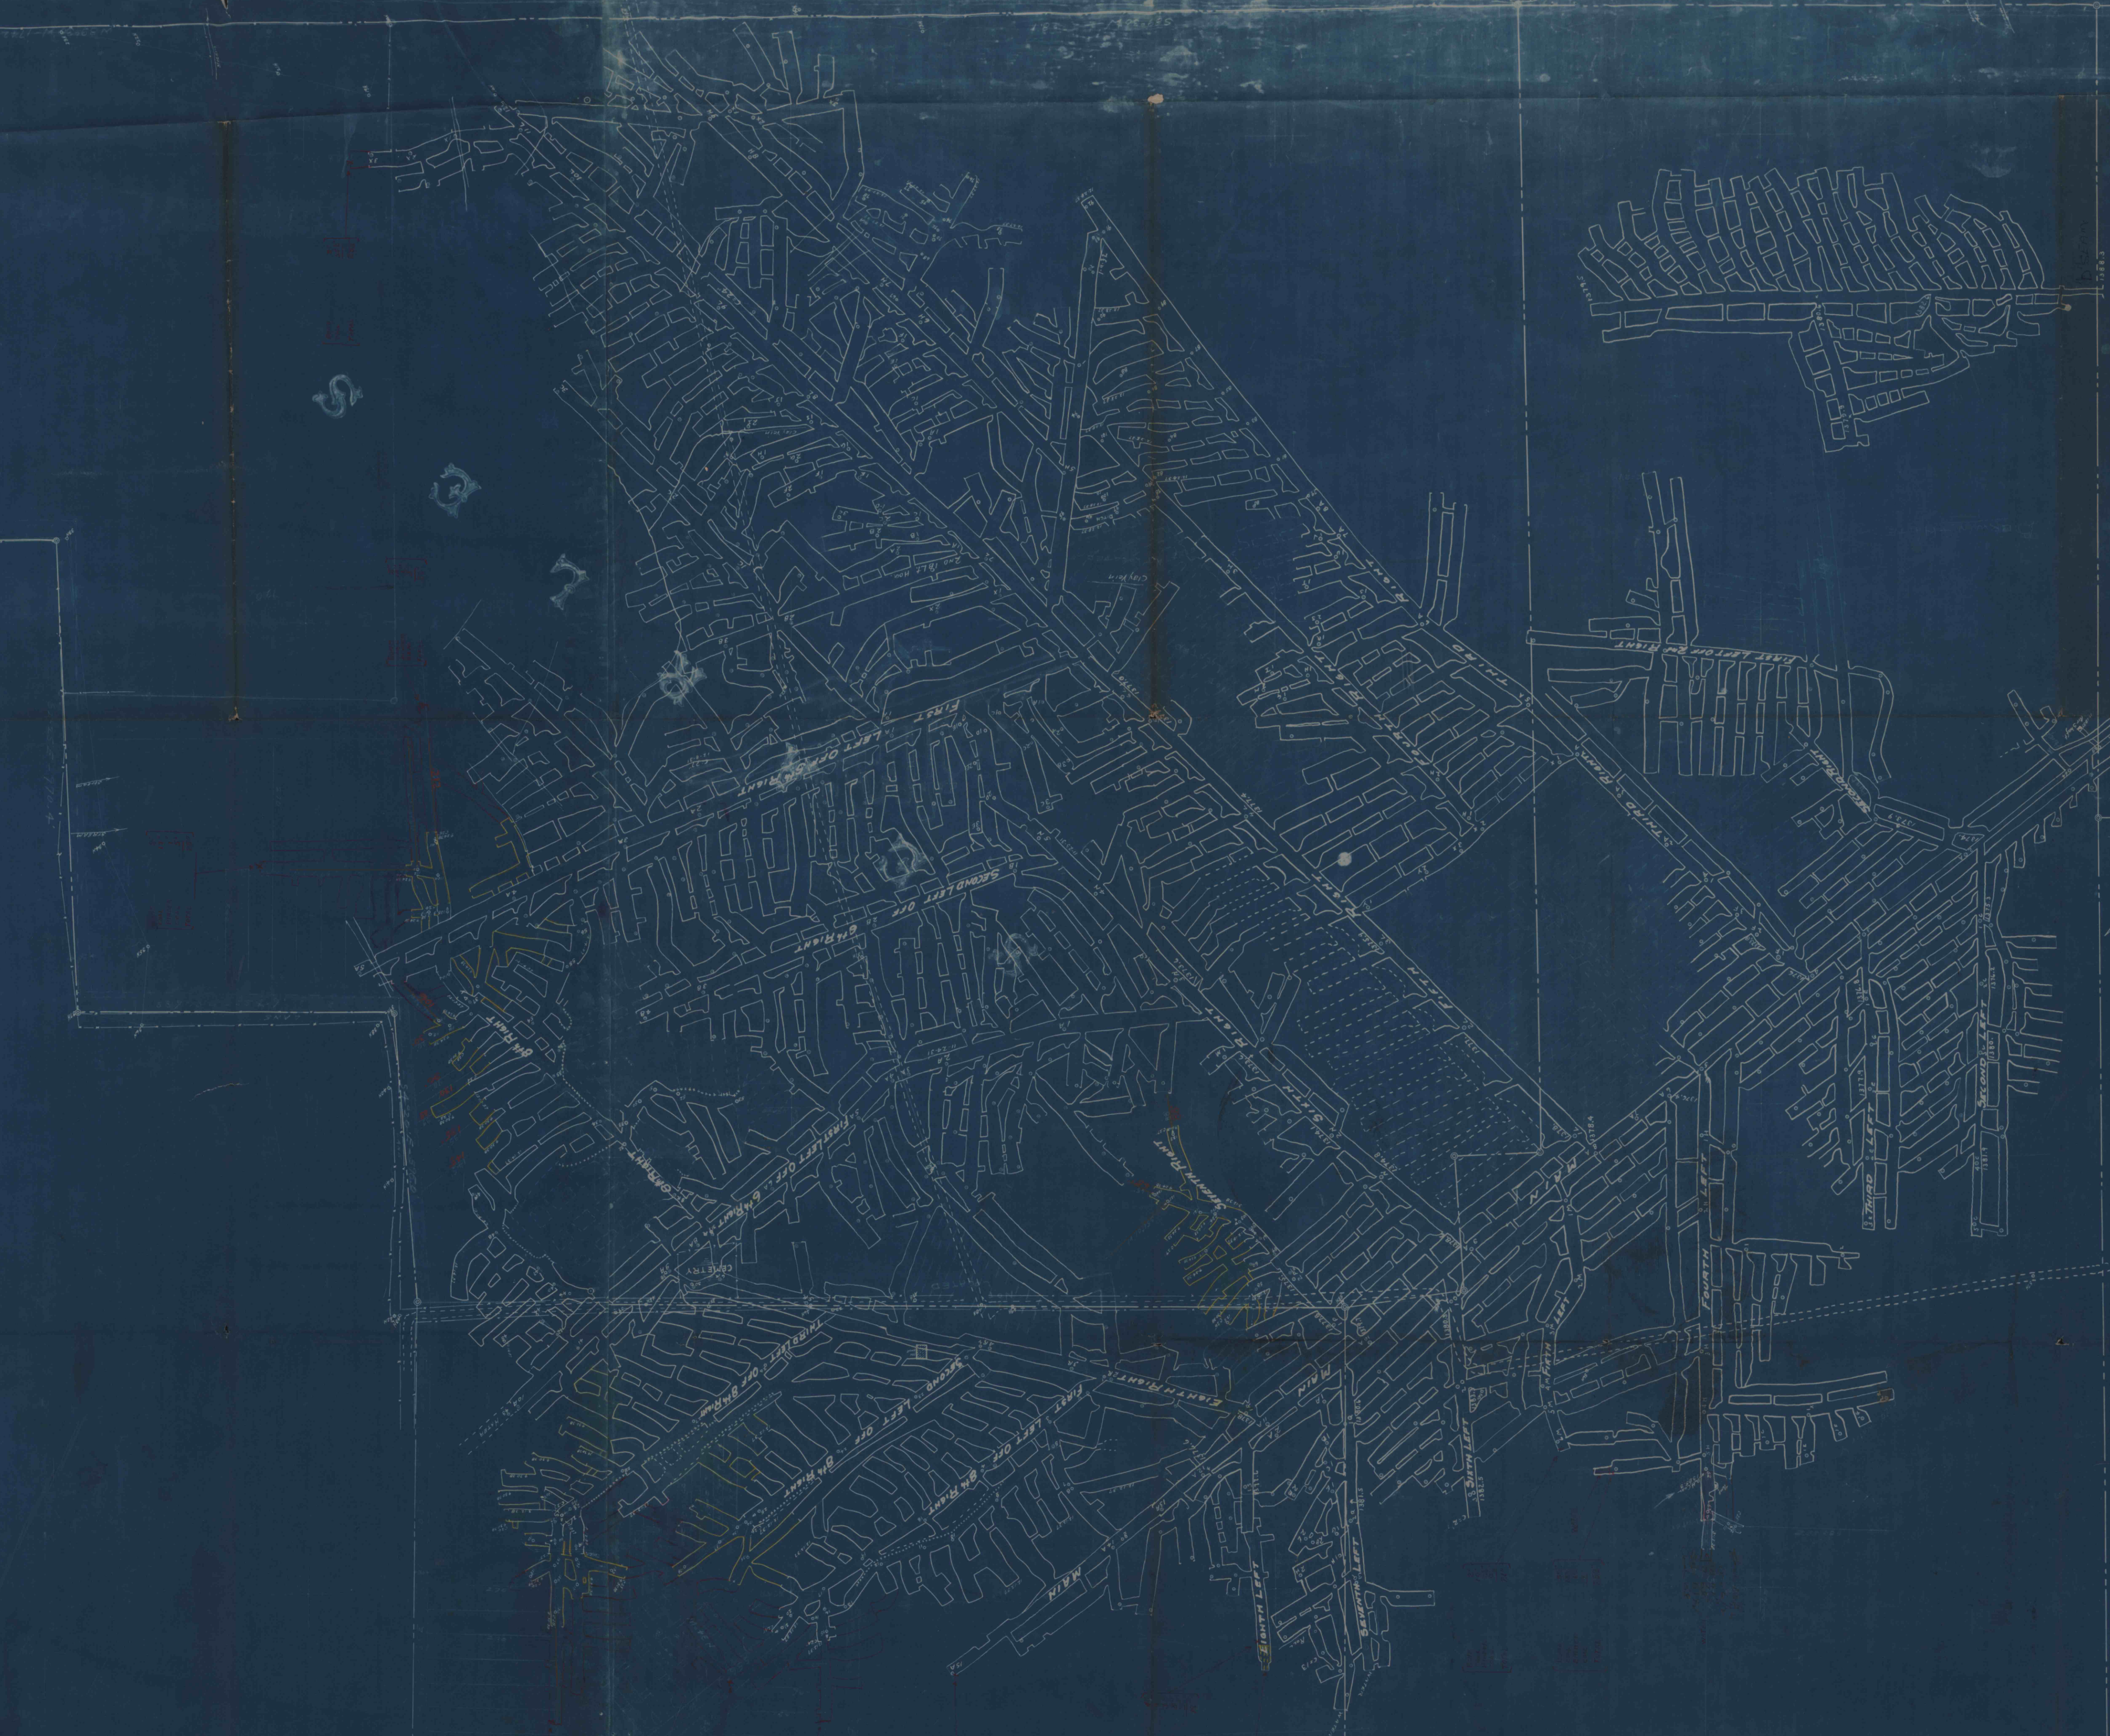

M.A.P.
BLACK OAK NO. 5
Cullagh Bros. Coal Co.
Scale 1/160 1/4" = 100 ft.

THE BLACK OAK COAL MINING CO.
M.A.P.
BLACK OAK NO. 5 COAL MINE

Baccaria Twp. Clearfield County, Penna.
Surveyed by The Clearfield Register Co. Clearfield
Survey from Office of The Clearfield Register Co.

SCALE 1 in = 100 ft.