


Mill Hollow Colliery
Luzerne County
1 1/2" = 100'
November 2, 1897
Waddell Heirs

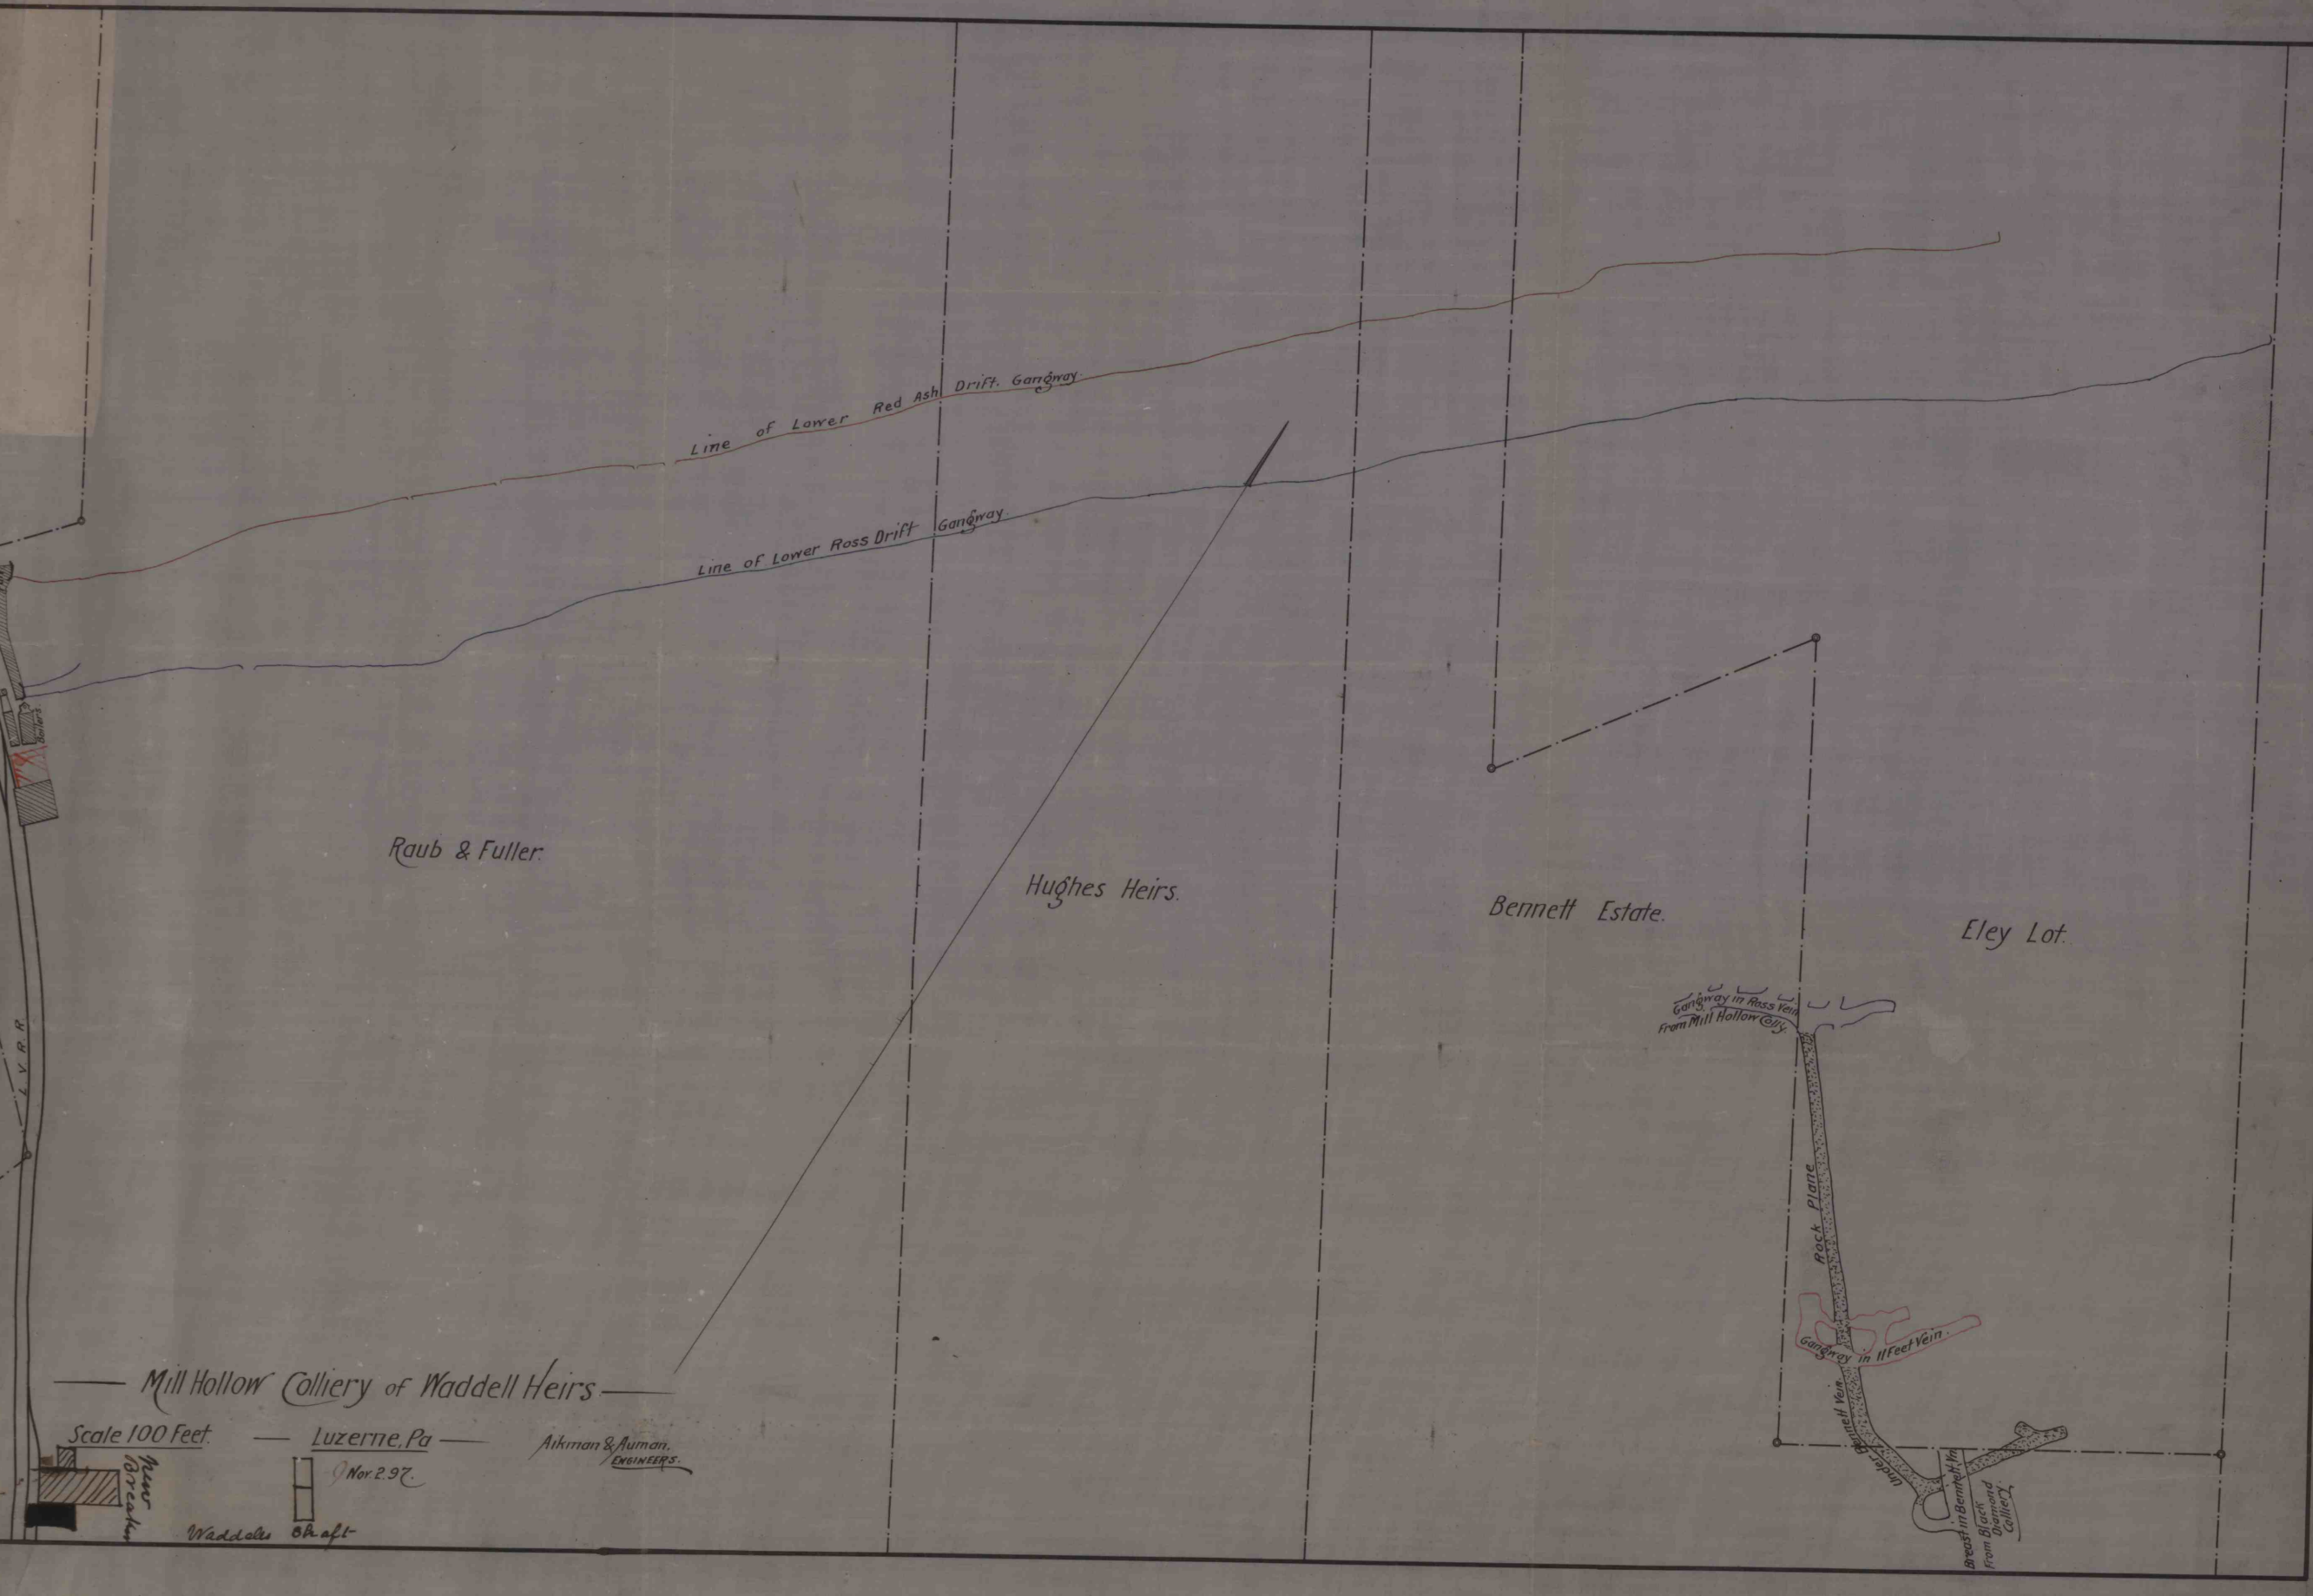

— Mill Hollow Colliery of Waddell Heirs —
Scale 100 Feet.
Luzerne, Pa.
Nov. 2. 97.
Atkinson & Auman,
ENGINEERS.