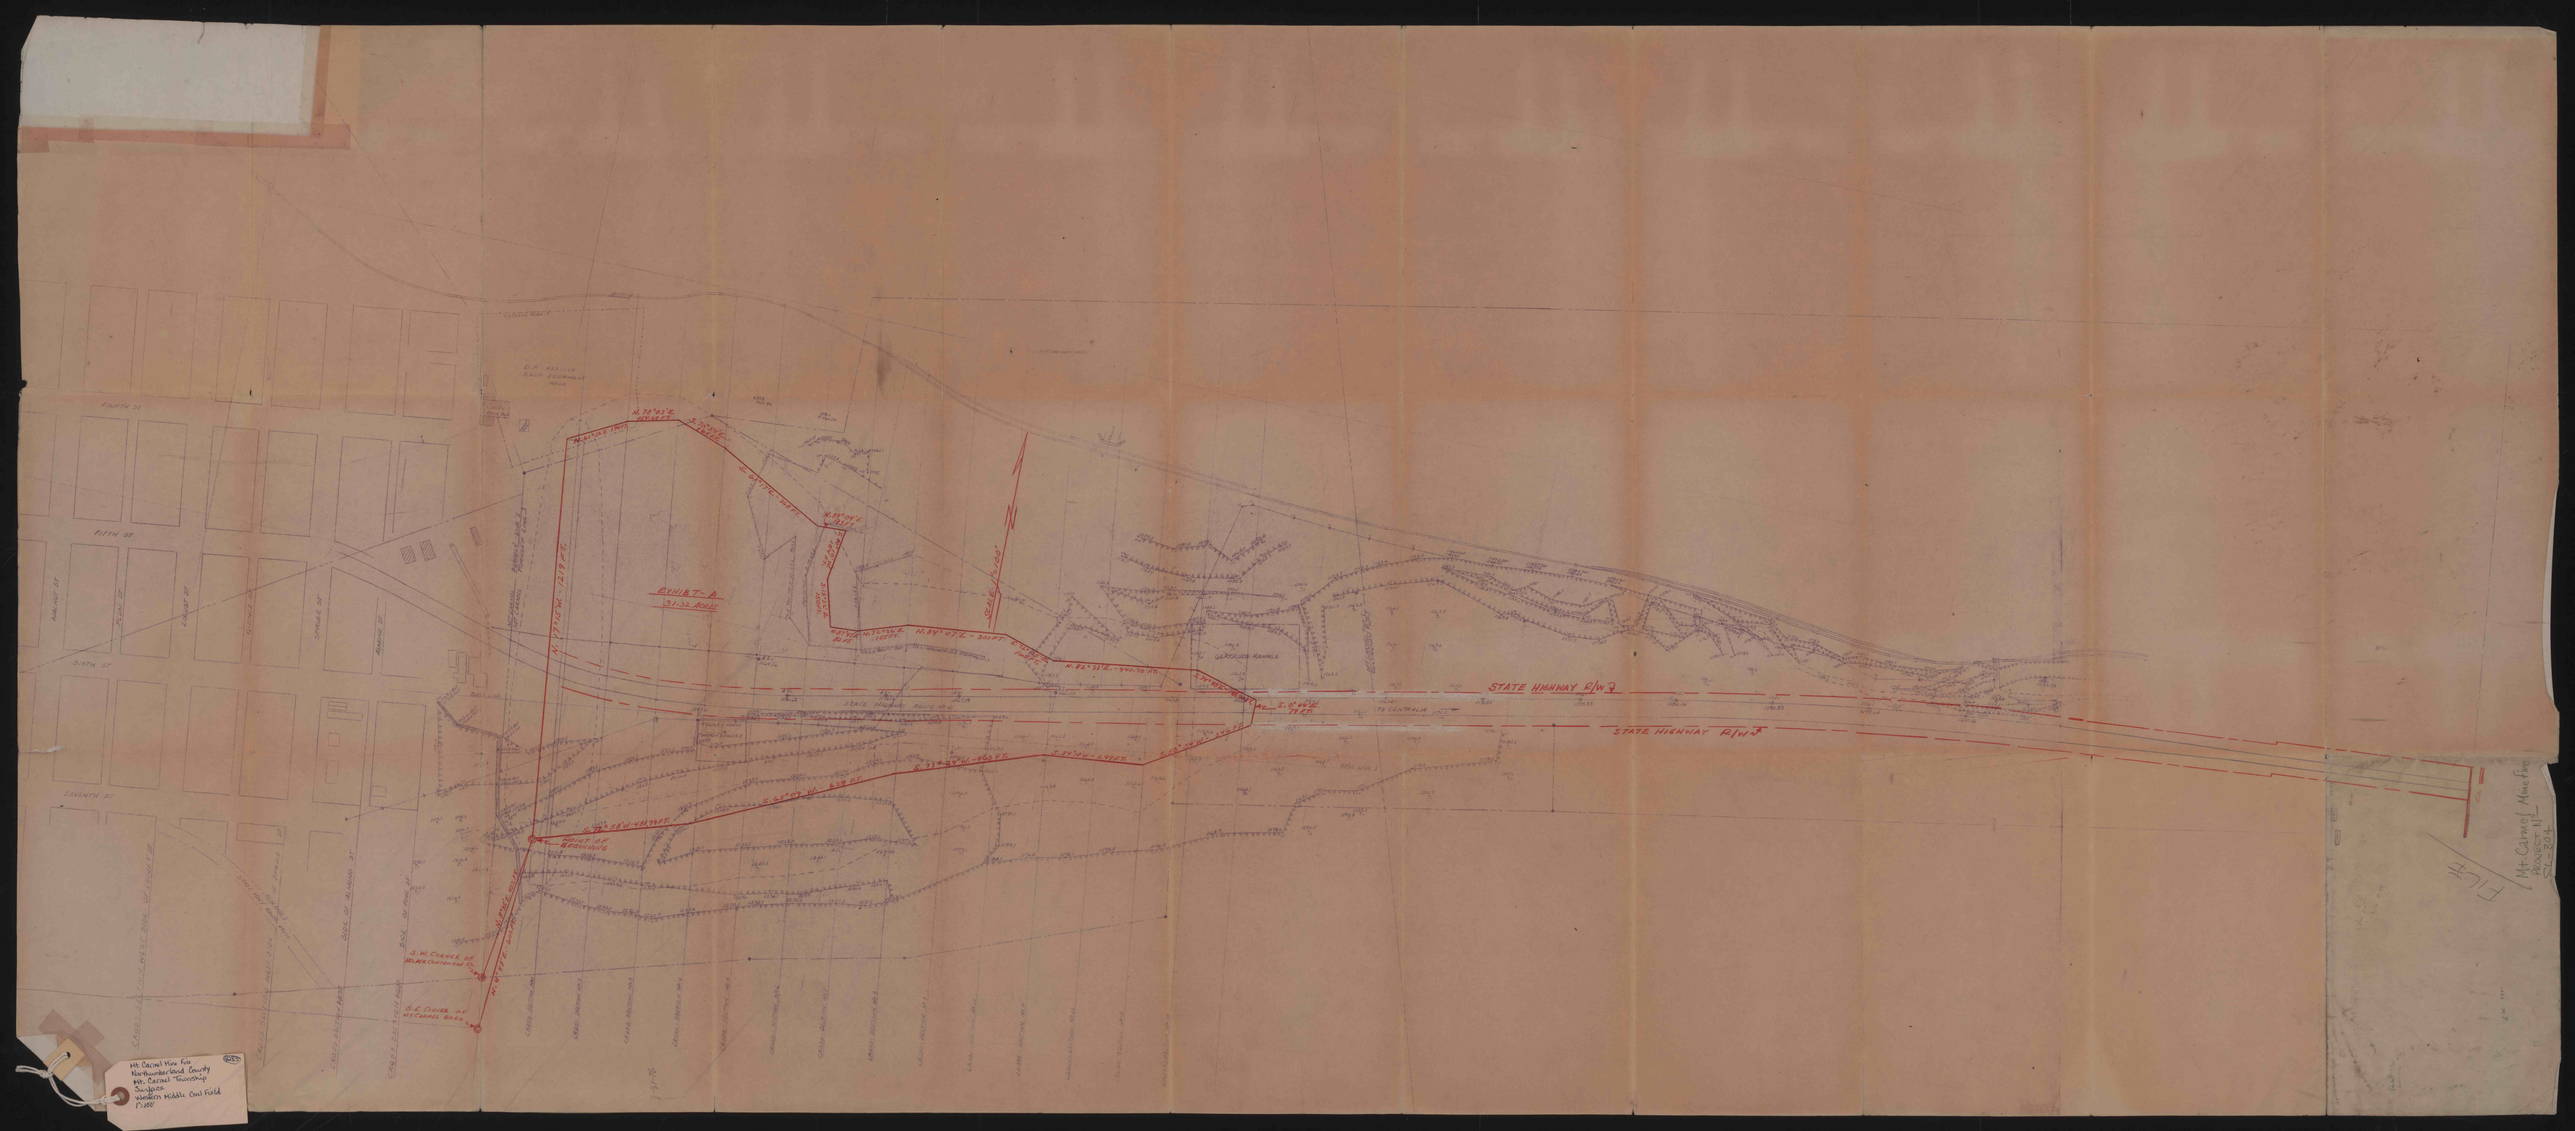
EXHIBIT - A
31.33 ACRES
STATE HIGHWAY R/W 7
STATE HIGHWAY R/W 3
FIFTH ST
SIXTH ST
SEVENTH ST
Mt. Carmel View Fole
Northumberland County
Mt. Carmel Township
Surface
Western Middle Coal Field
1" = 100'
Mt. Carmel View Fole
Project 11
R-2-24