


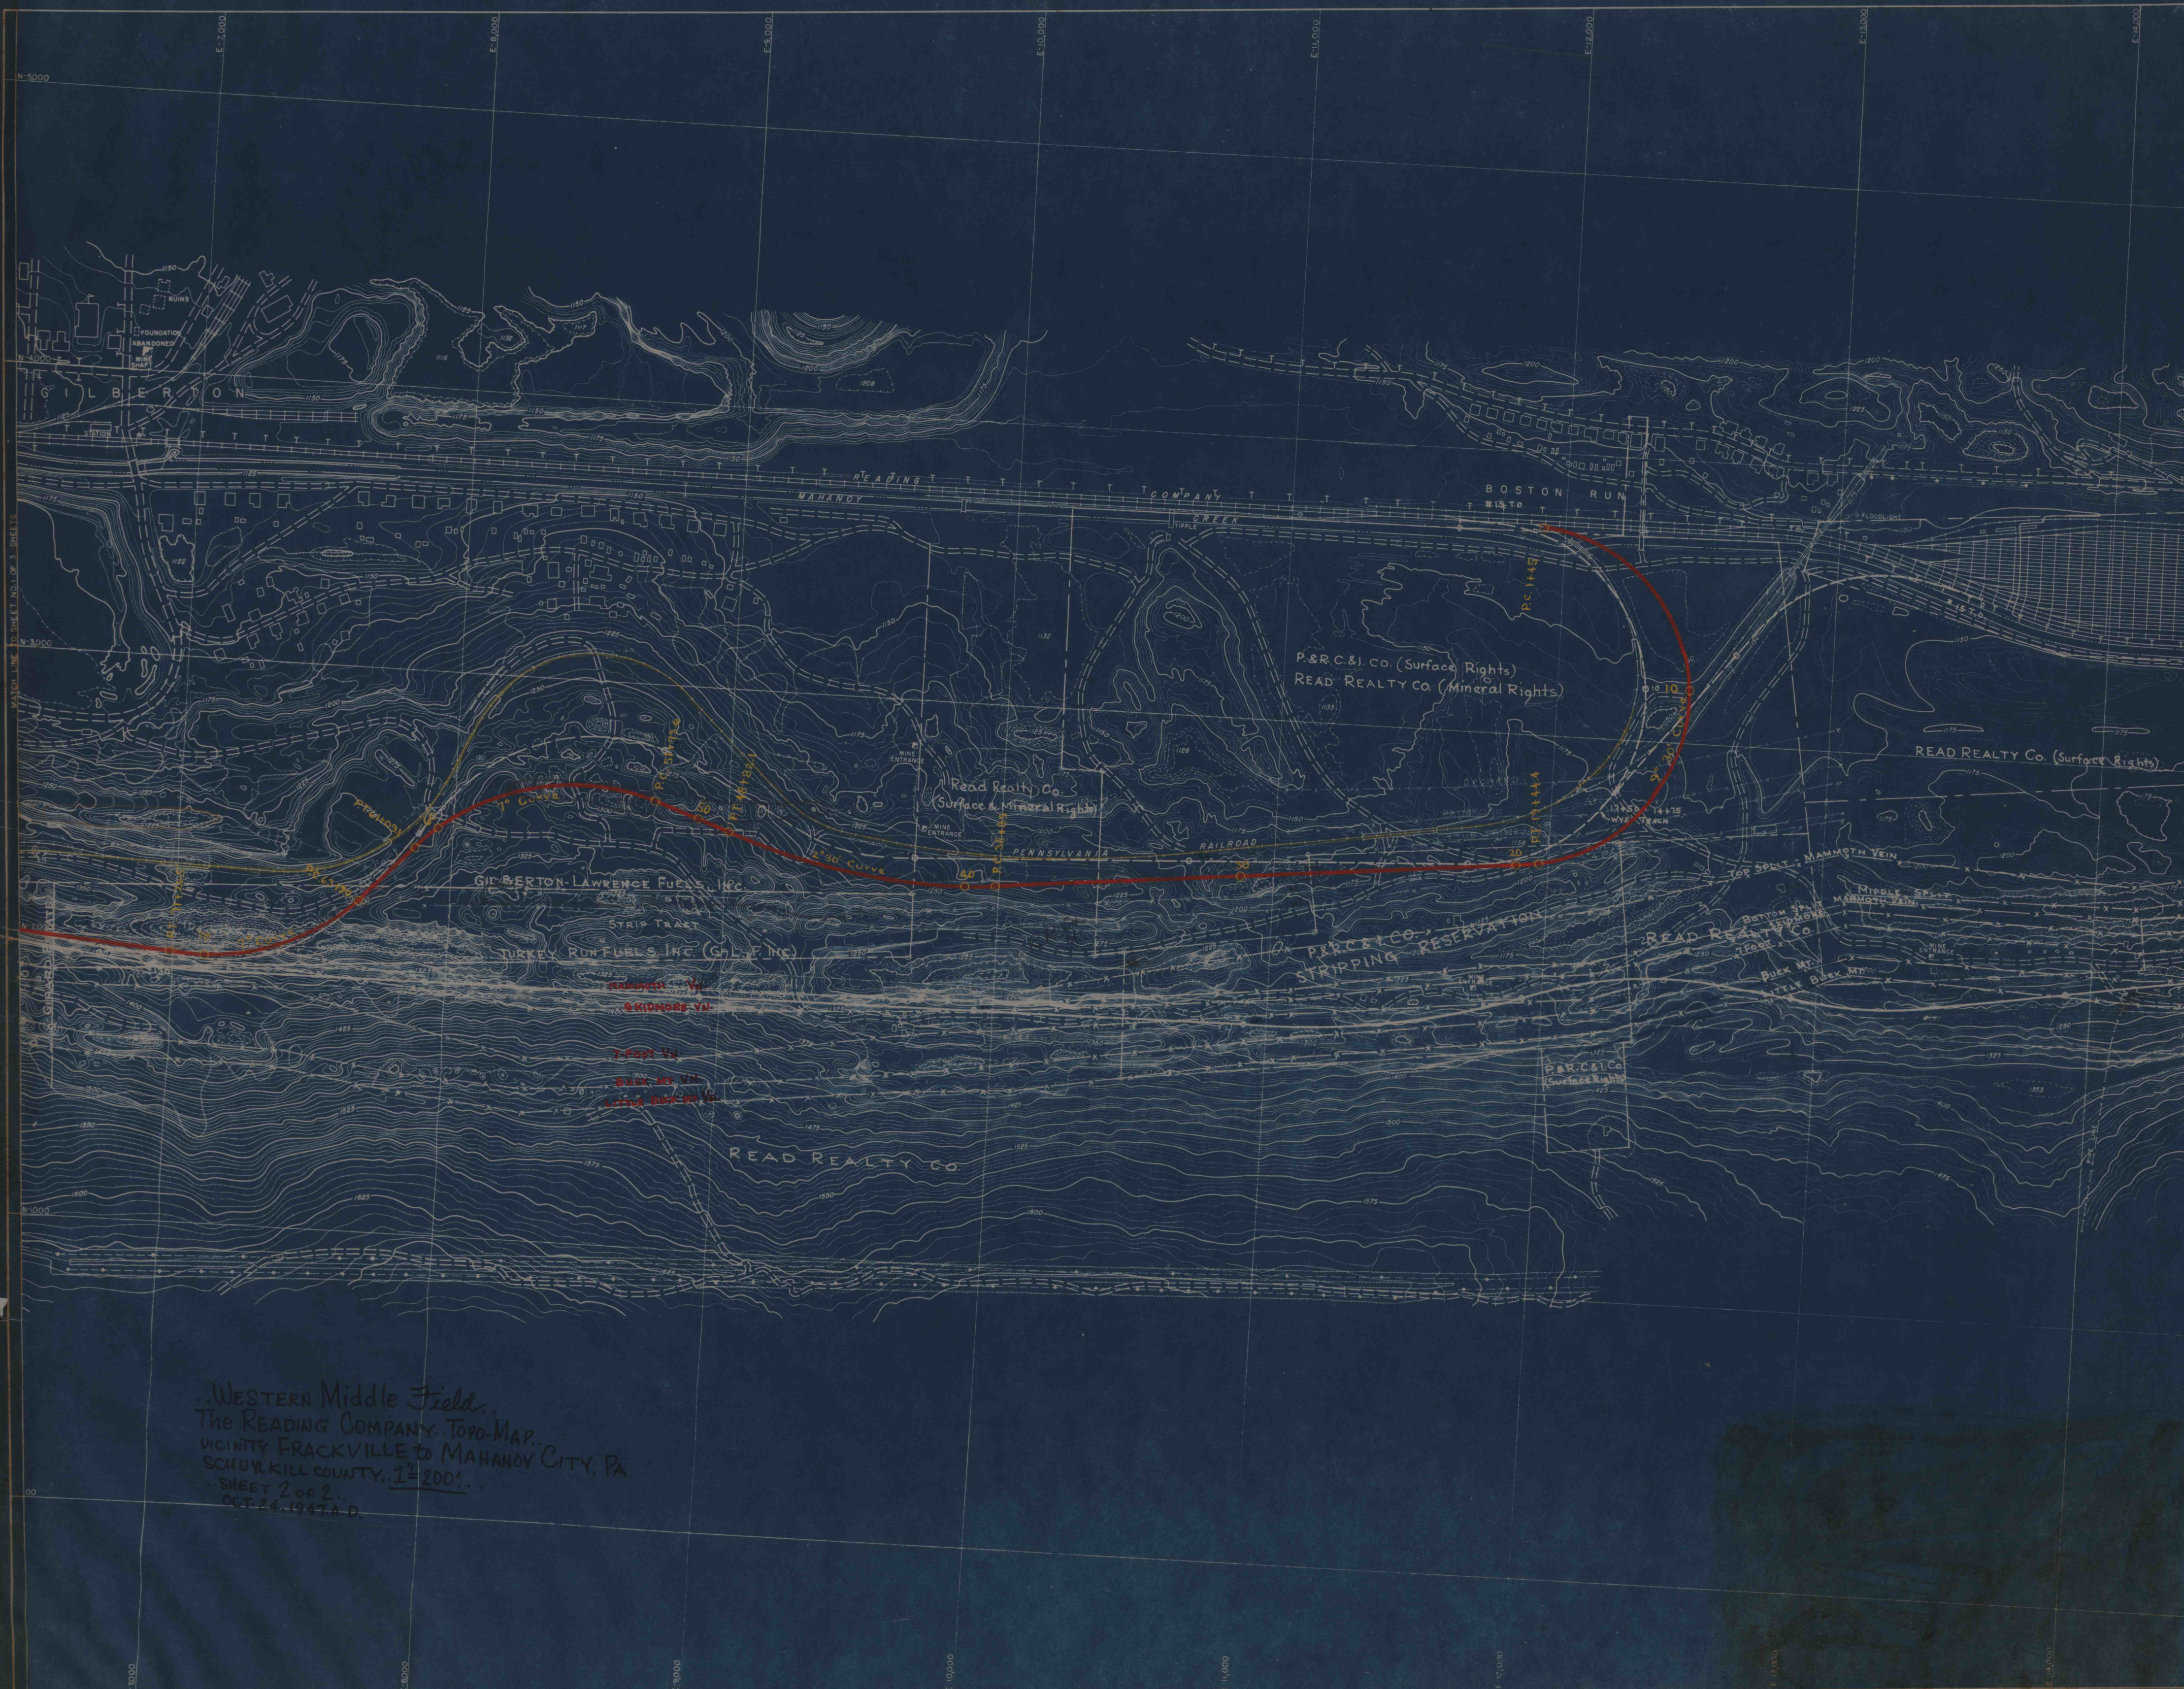

WESTERN Middle Field.
The Reading Company. TOPO-MAP.
VICINITY FRACKVILLE TO MAHANAY CITY, PA.
SCHUYLKILL COUNTY, 1:200.
SHEET 2 OF 2.
OCT. 24, 1947 A.D.