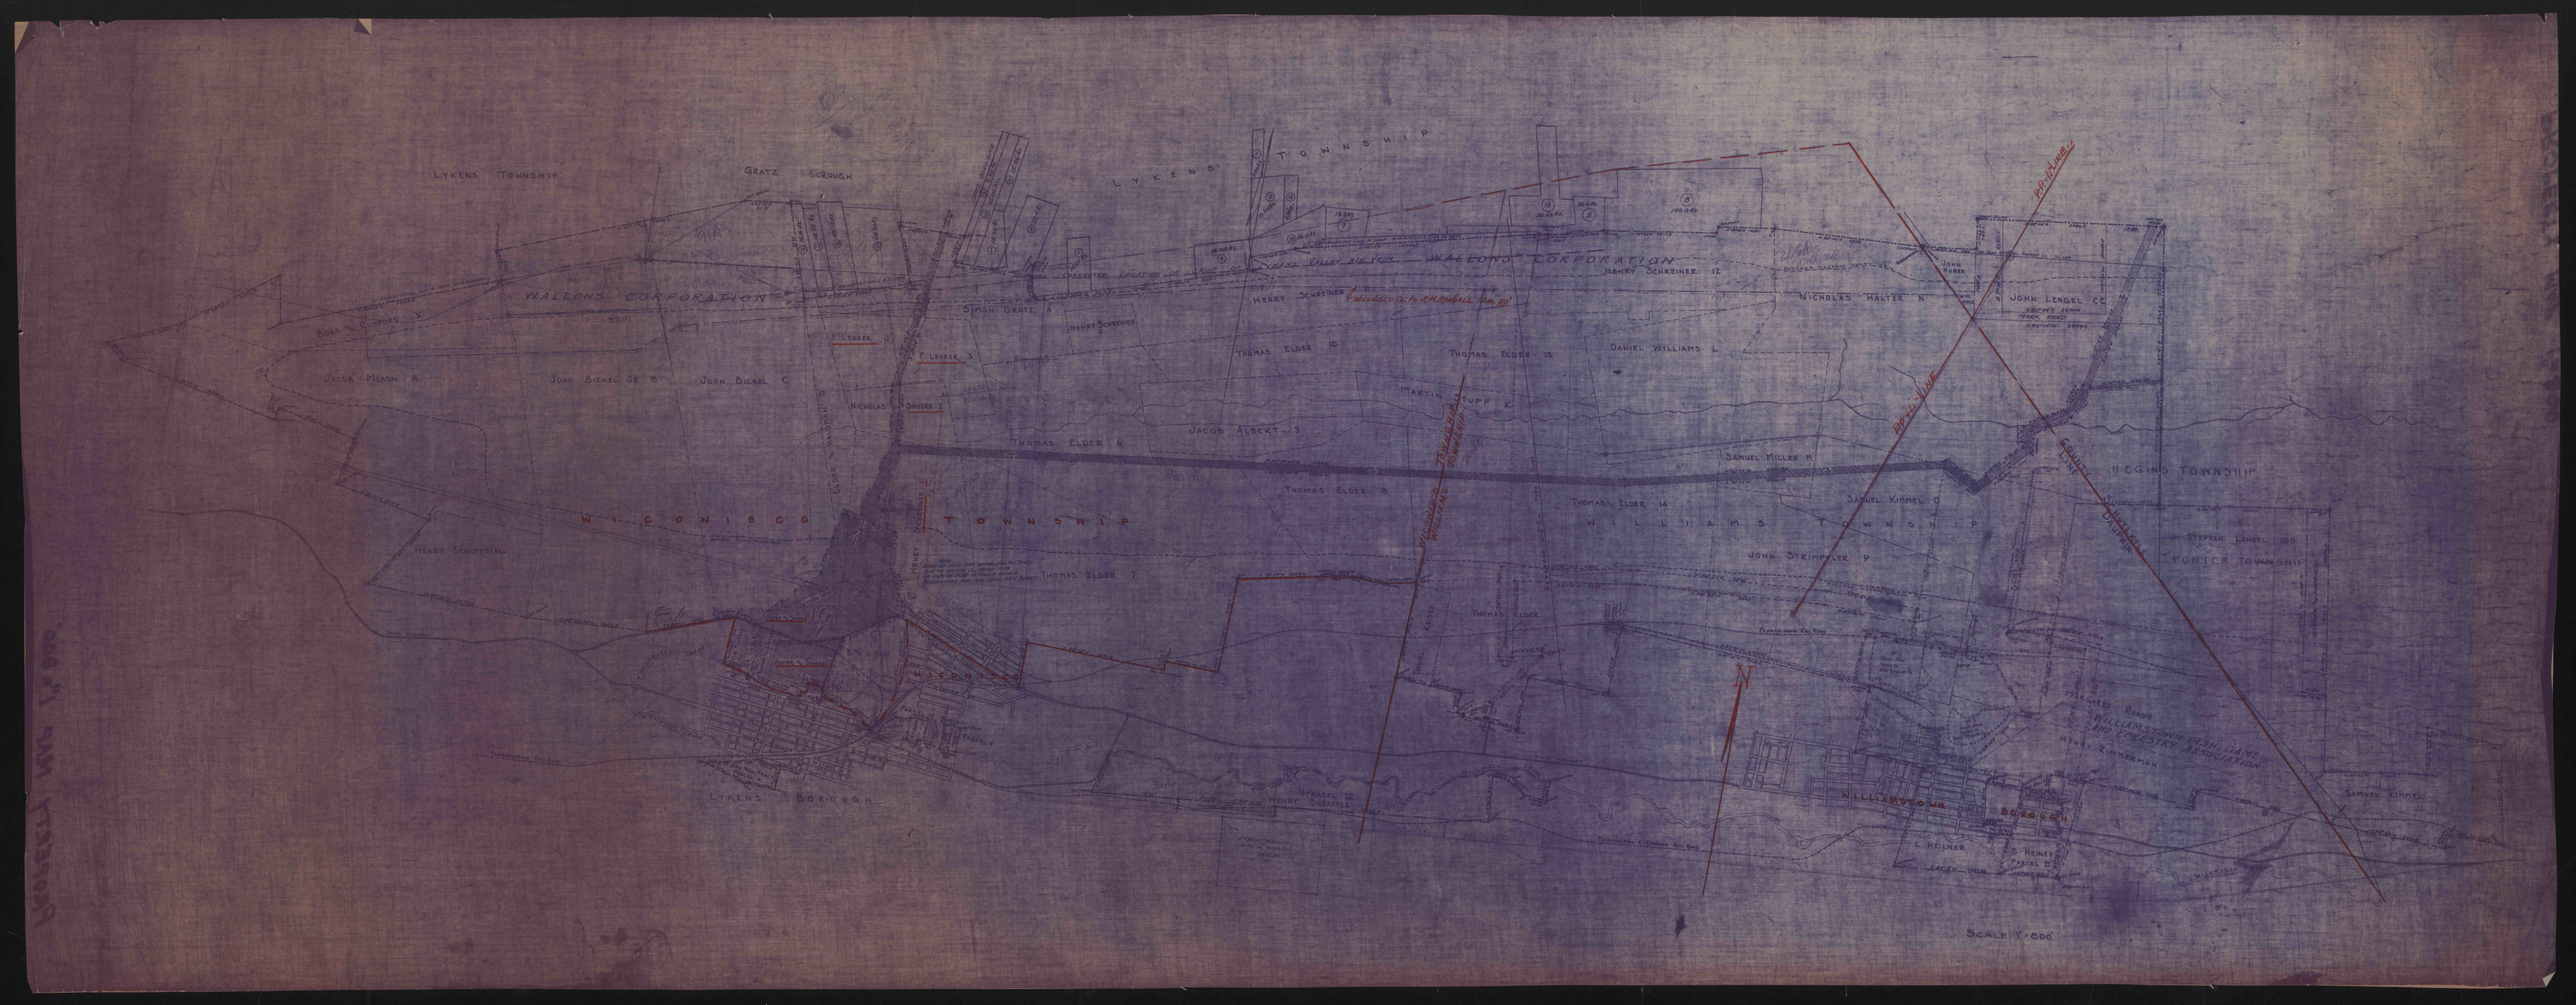
LYKENS TOWNSHIP
GRATZ BOROUGH
LYKENS TOWNSHIP
WALLONS CORPORATION
WALLONS CORPORATION
Rock Springs
Jacob Mesch A
John Bickel Jr B
John Bickel C
Simon Gratz 4
Henry Schreiner
Henry Schreiner 12
Nicholas Halter N
John Lengel CC
Thomas Elder 10
Thomas Elder 13
Daniel Williams L
Martin Stupp K
Nicholas Snyder 2
Jacob Albert 3
Thomas Elder 6
Samuel Miller M
Thomas Elder 8
Thomas Elder 14
Samuel Kimmel O
WILLIAMS TOWNSHIP
HEGINS TOWNSHIP
Henry Schoffstall
WICONISCO TOWNSHIP
Thomas Elder 7
John Strimpler P
Stephen Lengel DD
PORTER TOWNSHIP
WICONISCO
LYKENS BOROUGH
WILLIAMSTOWN BOROUGH
L. Heilner
Samuel Kimmel
Scale 1" = 600'