


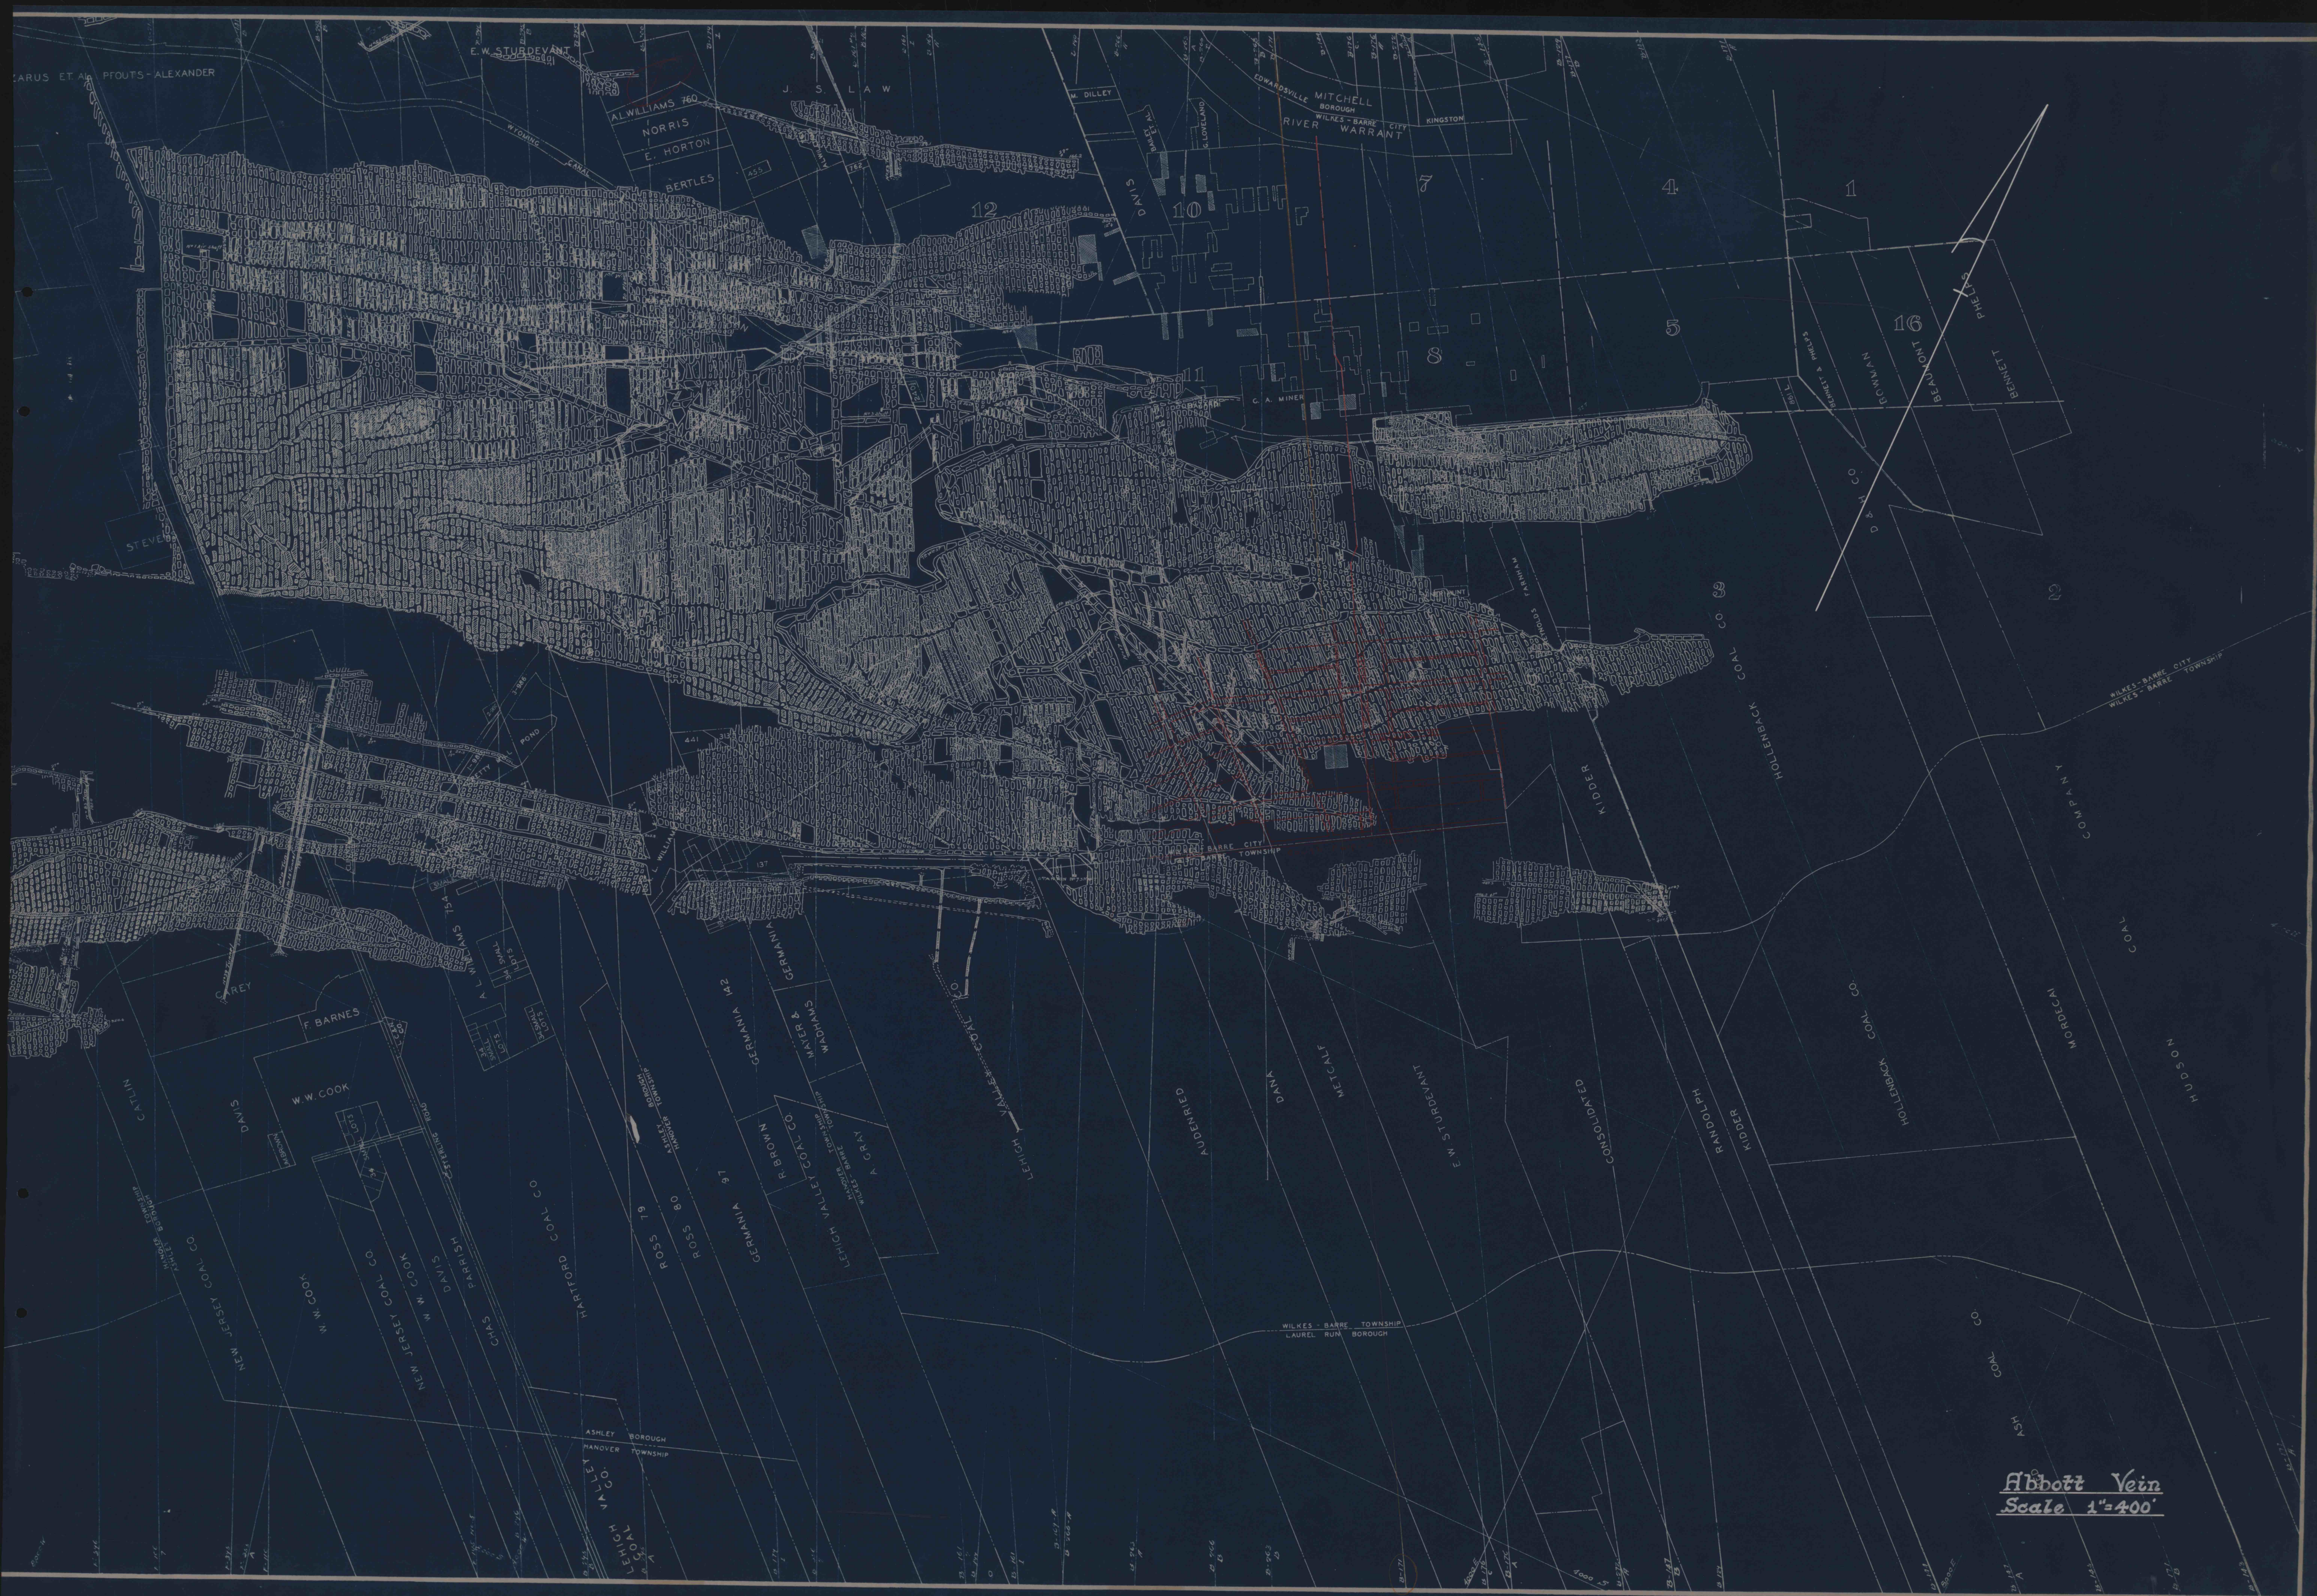

Abbott Vein
Scale 1"=400'