


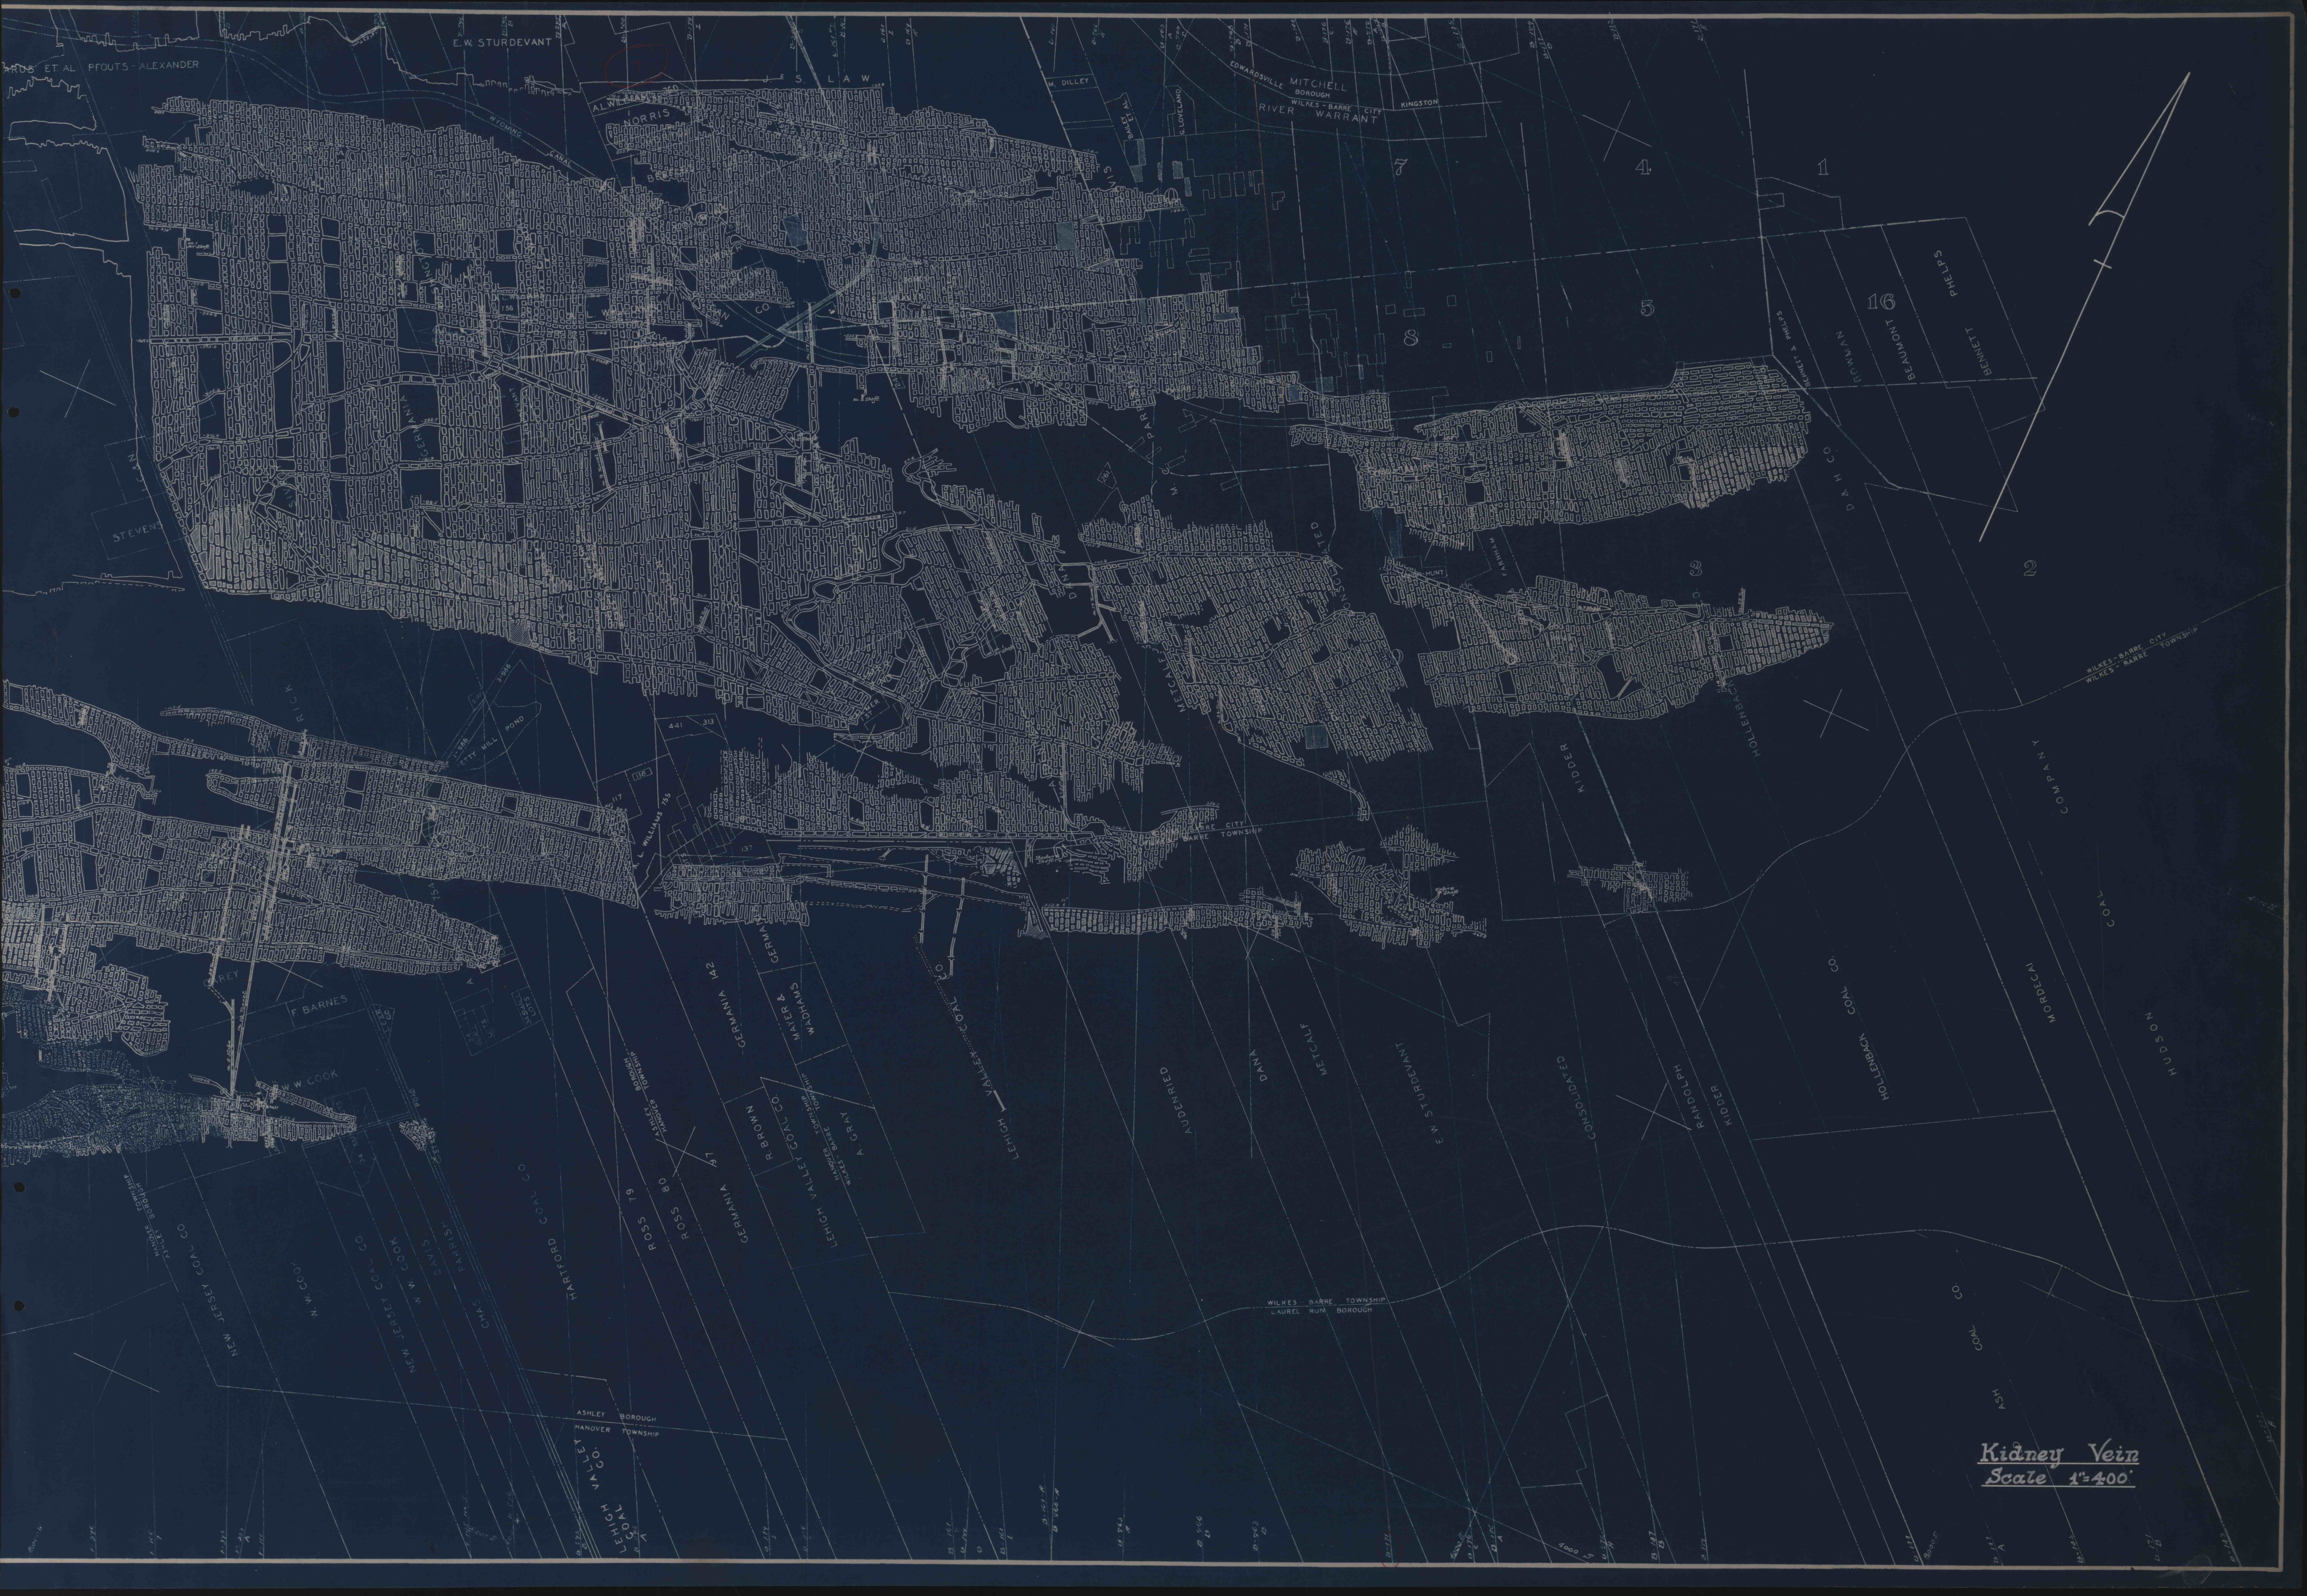

Kidney Vein
Scale 1"=400'