


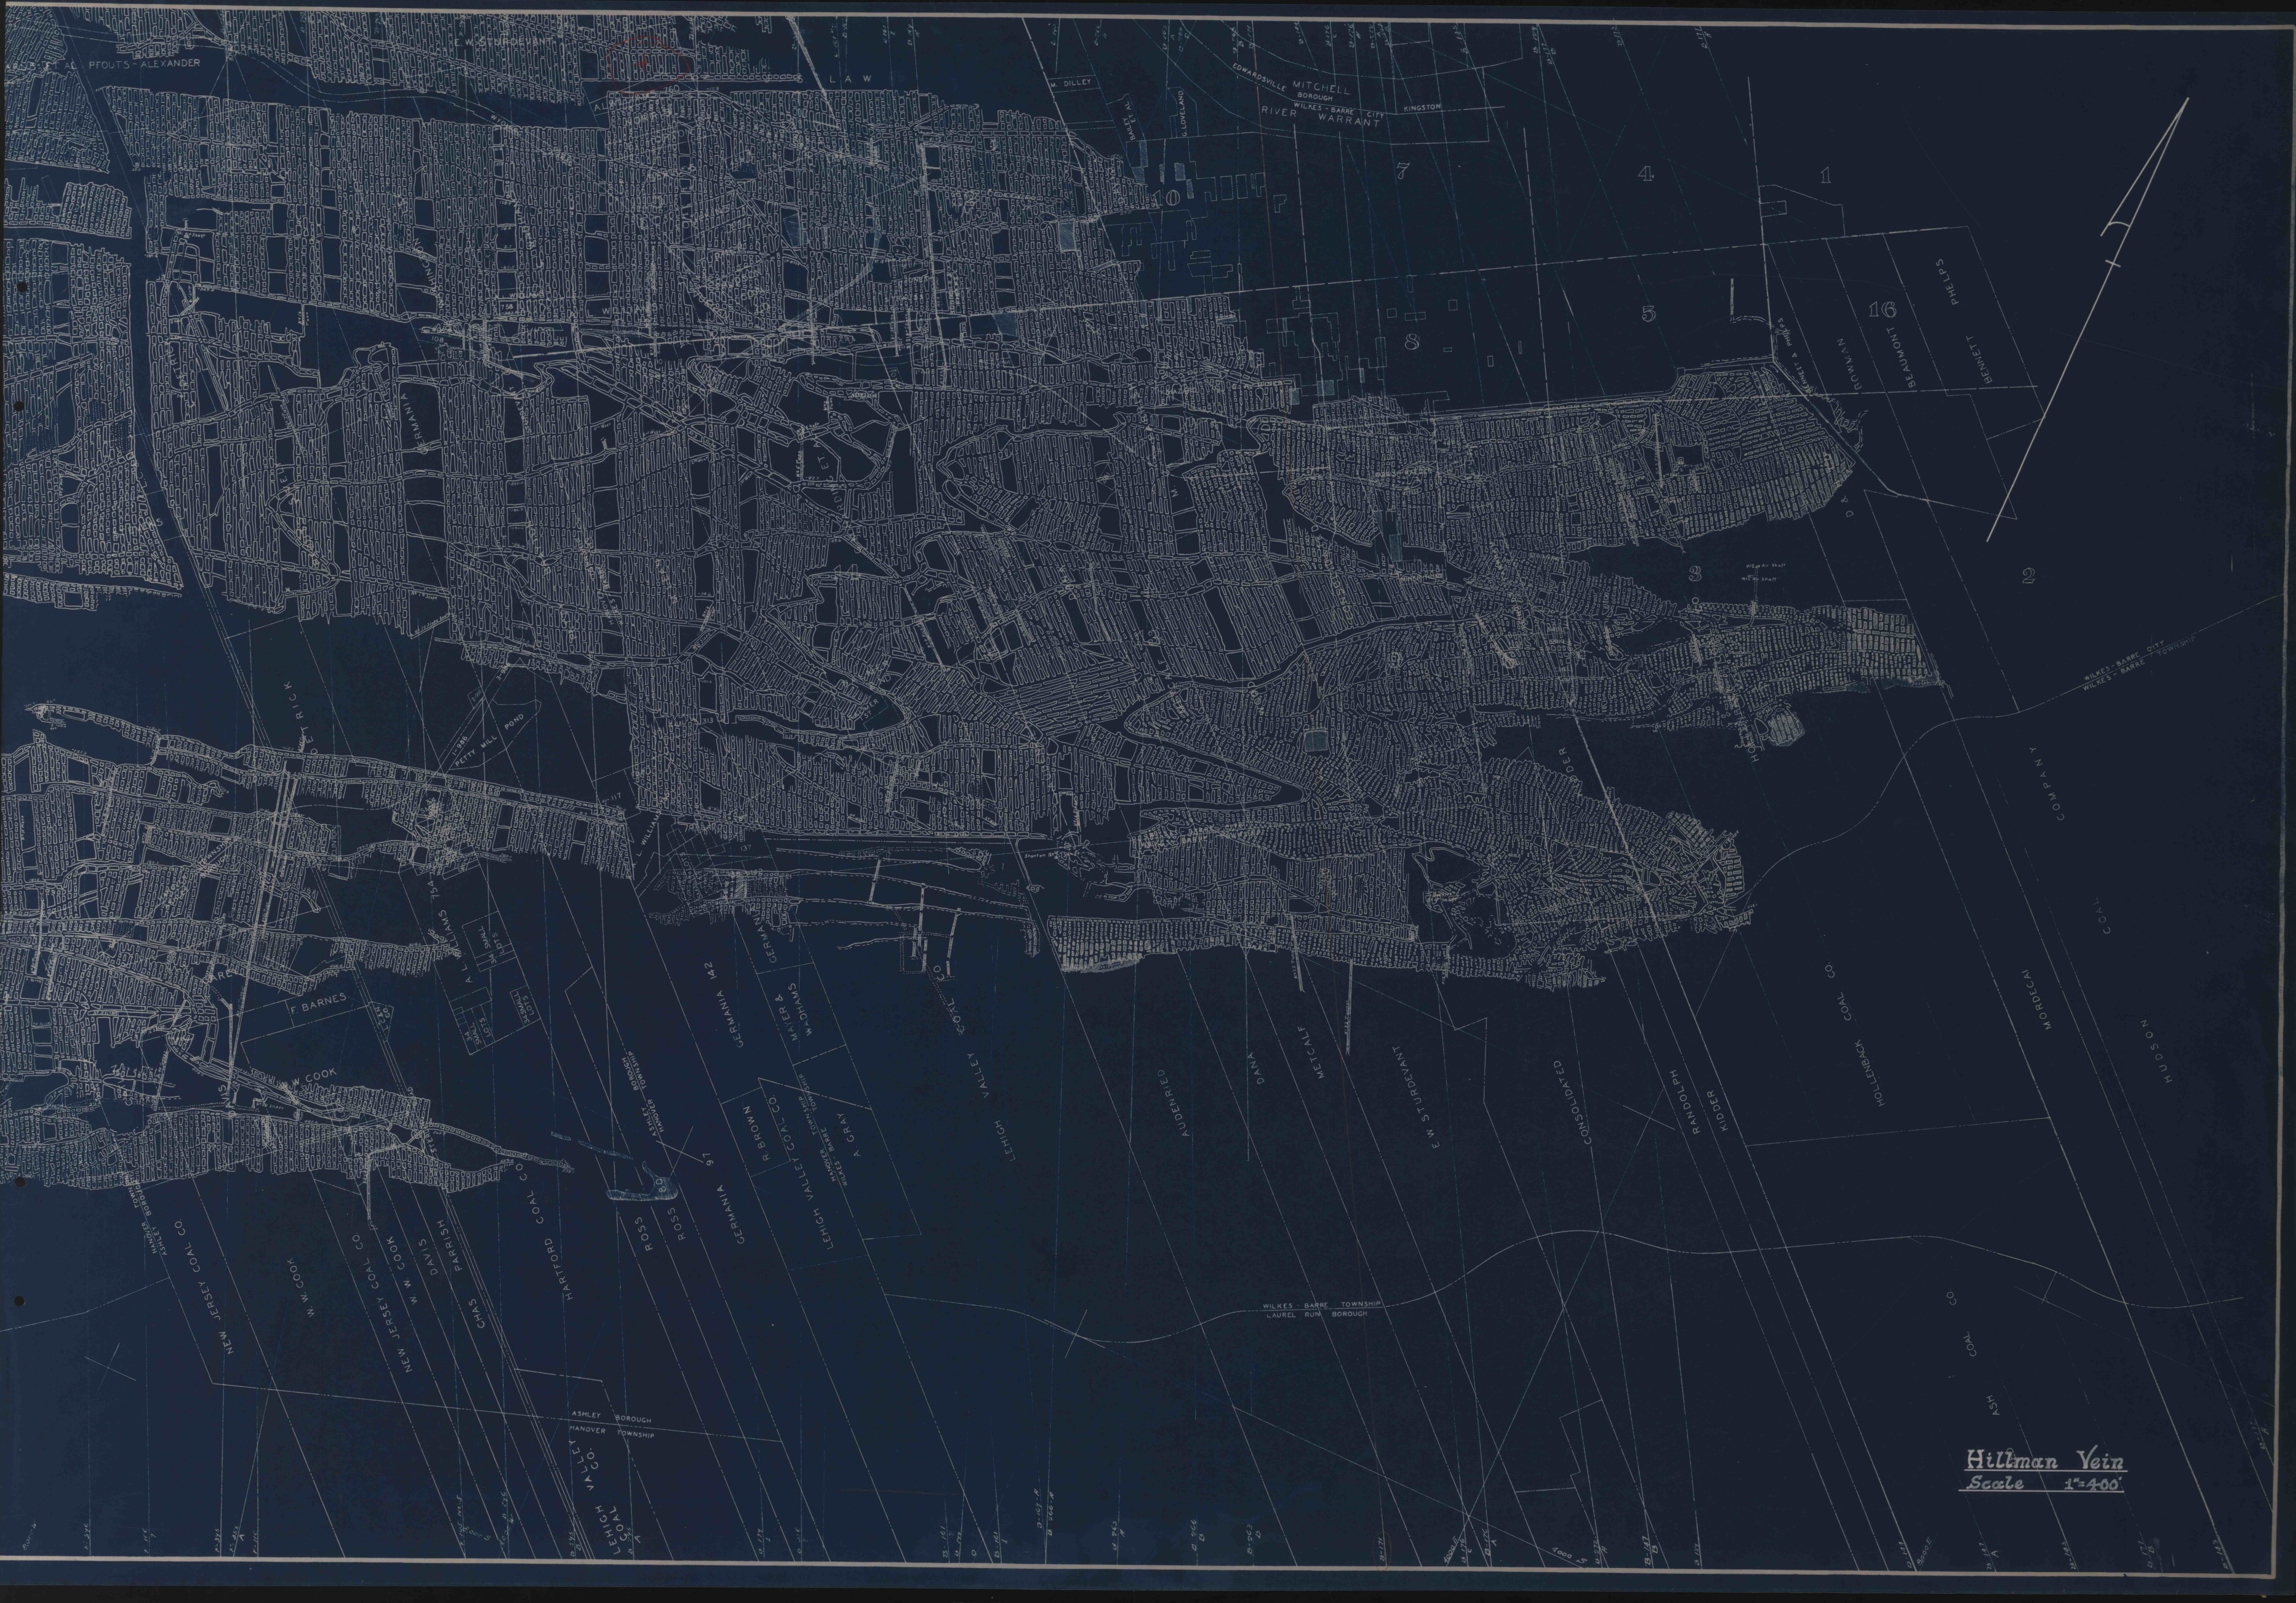

Hillman Vein
Scale 1"=400'