


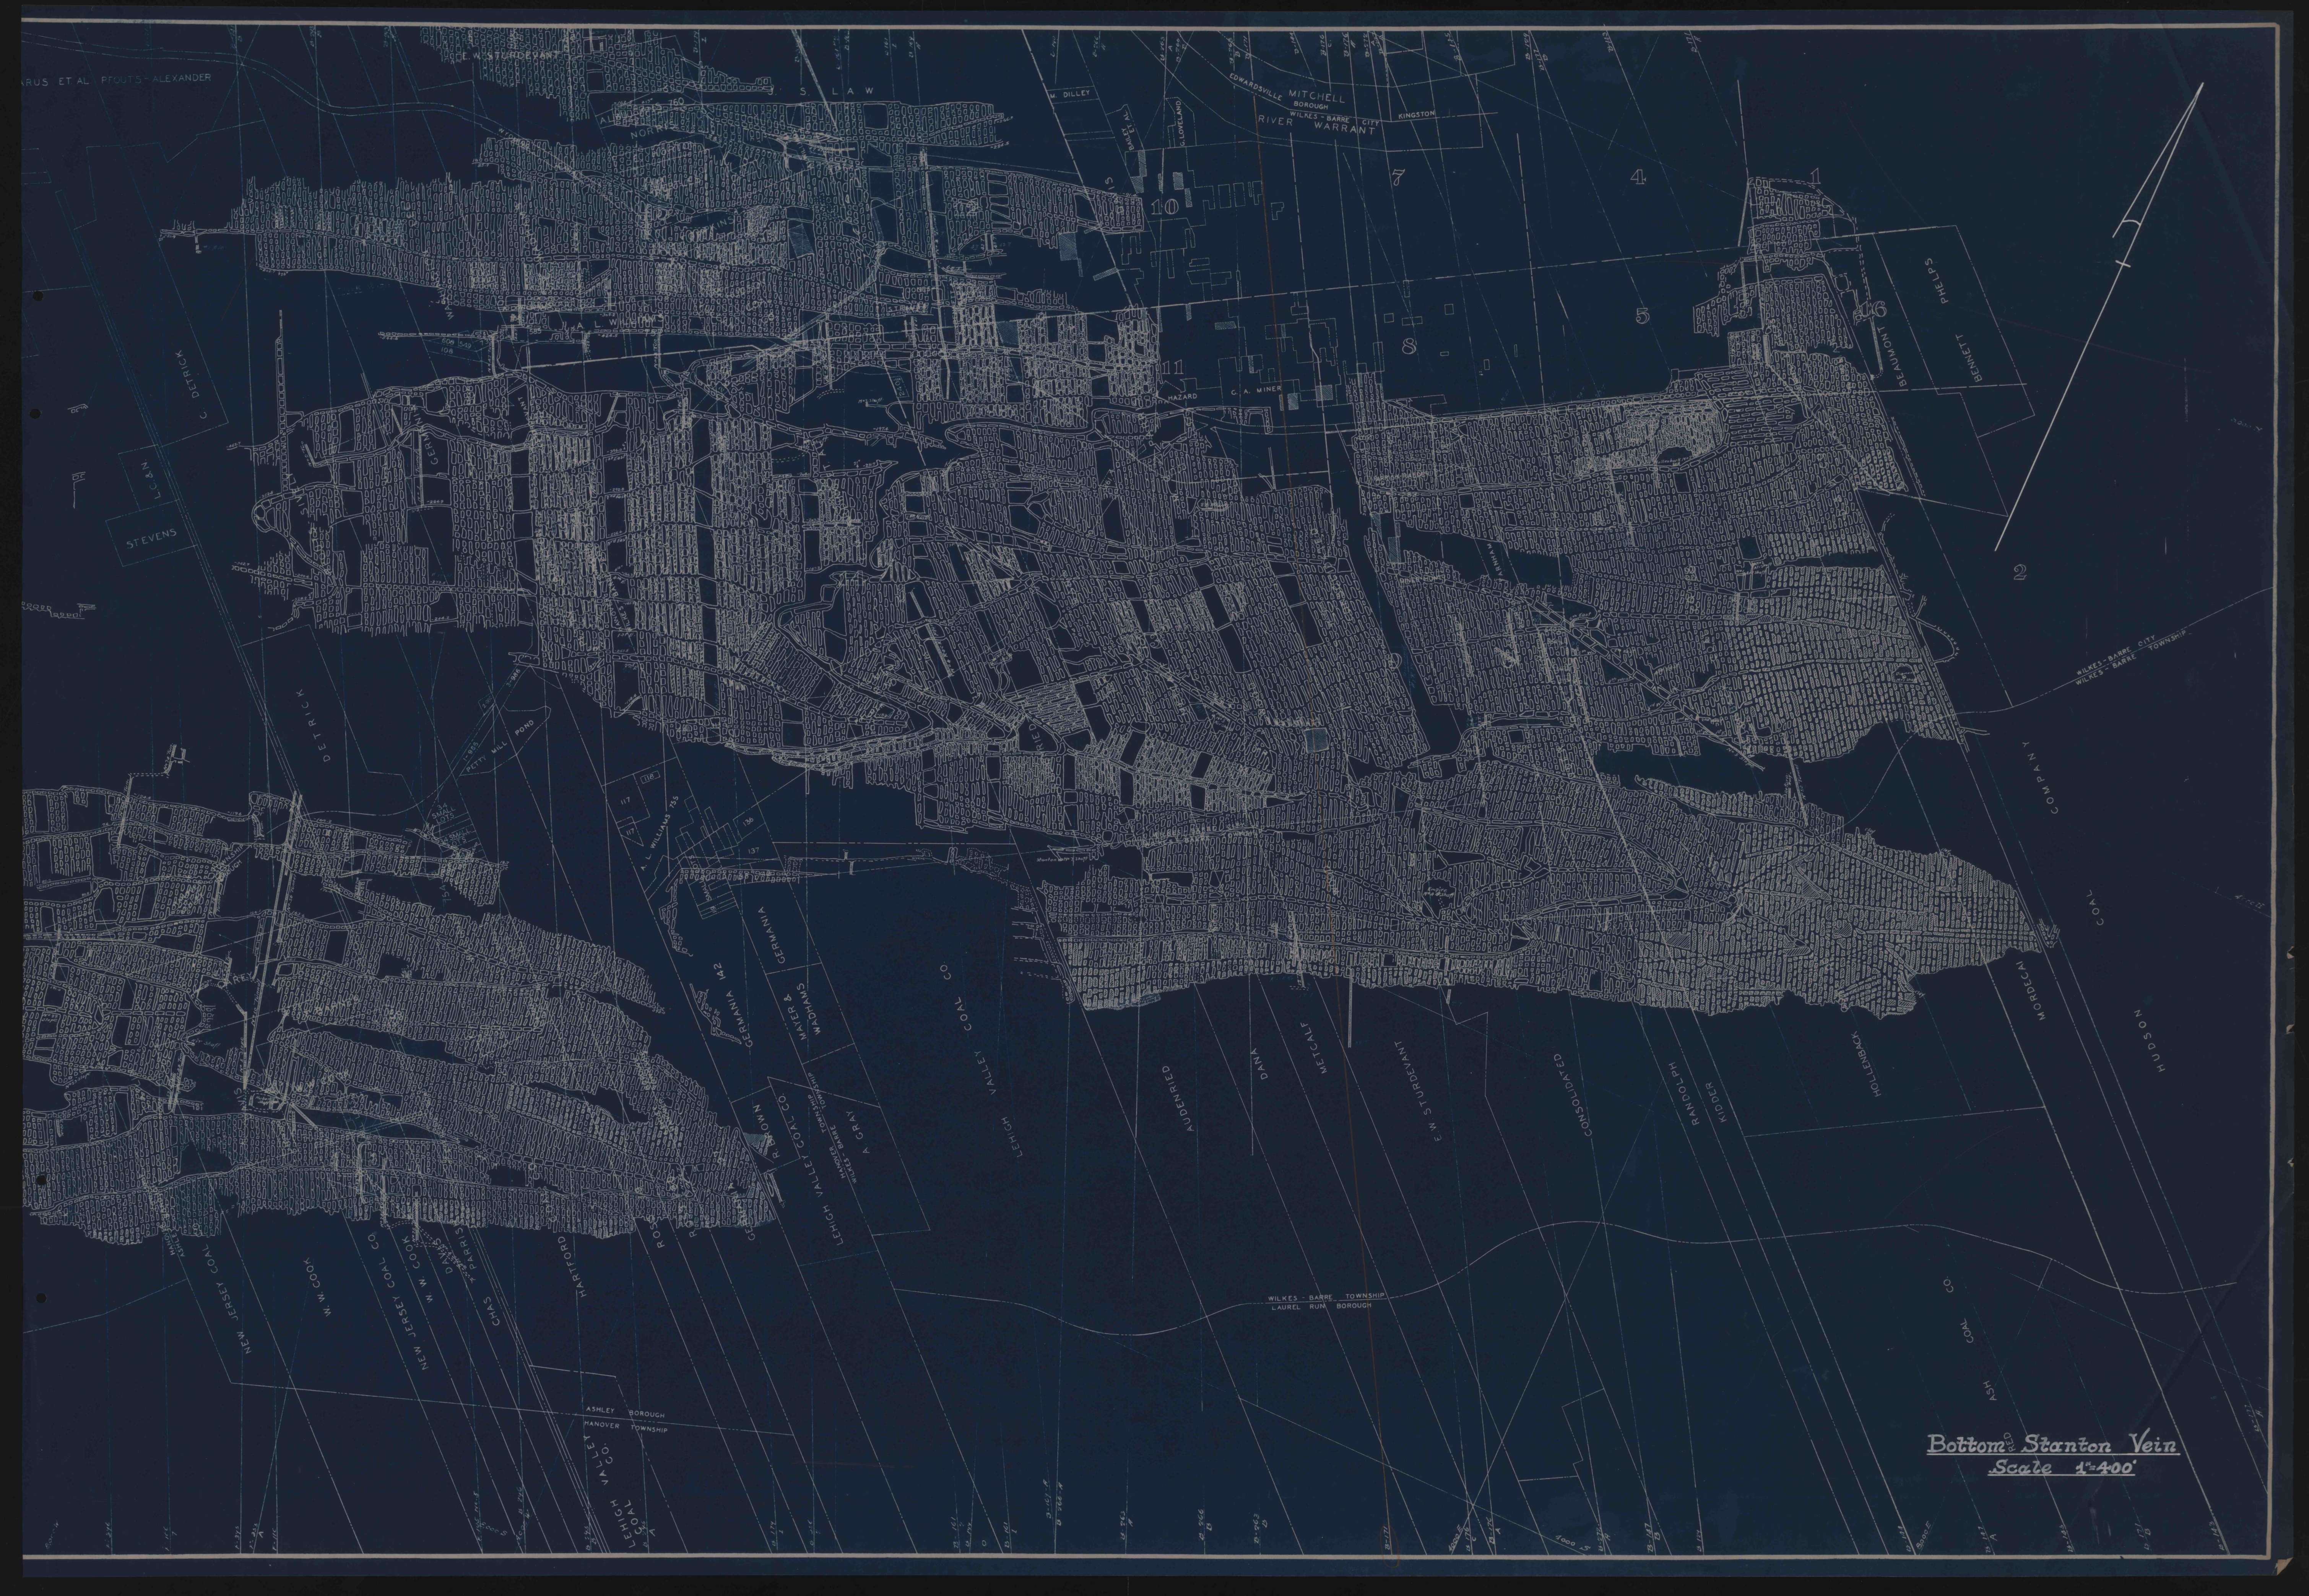

Bottom Stanton Vein
Scale 1"=400'