


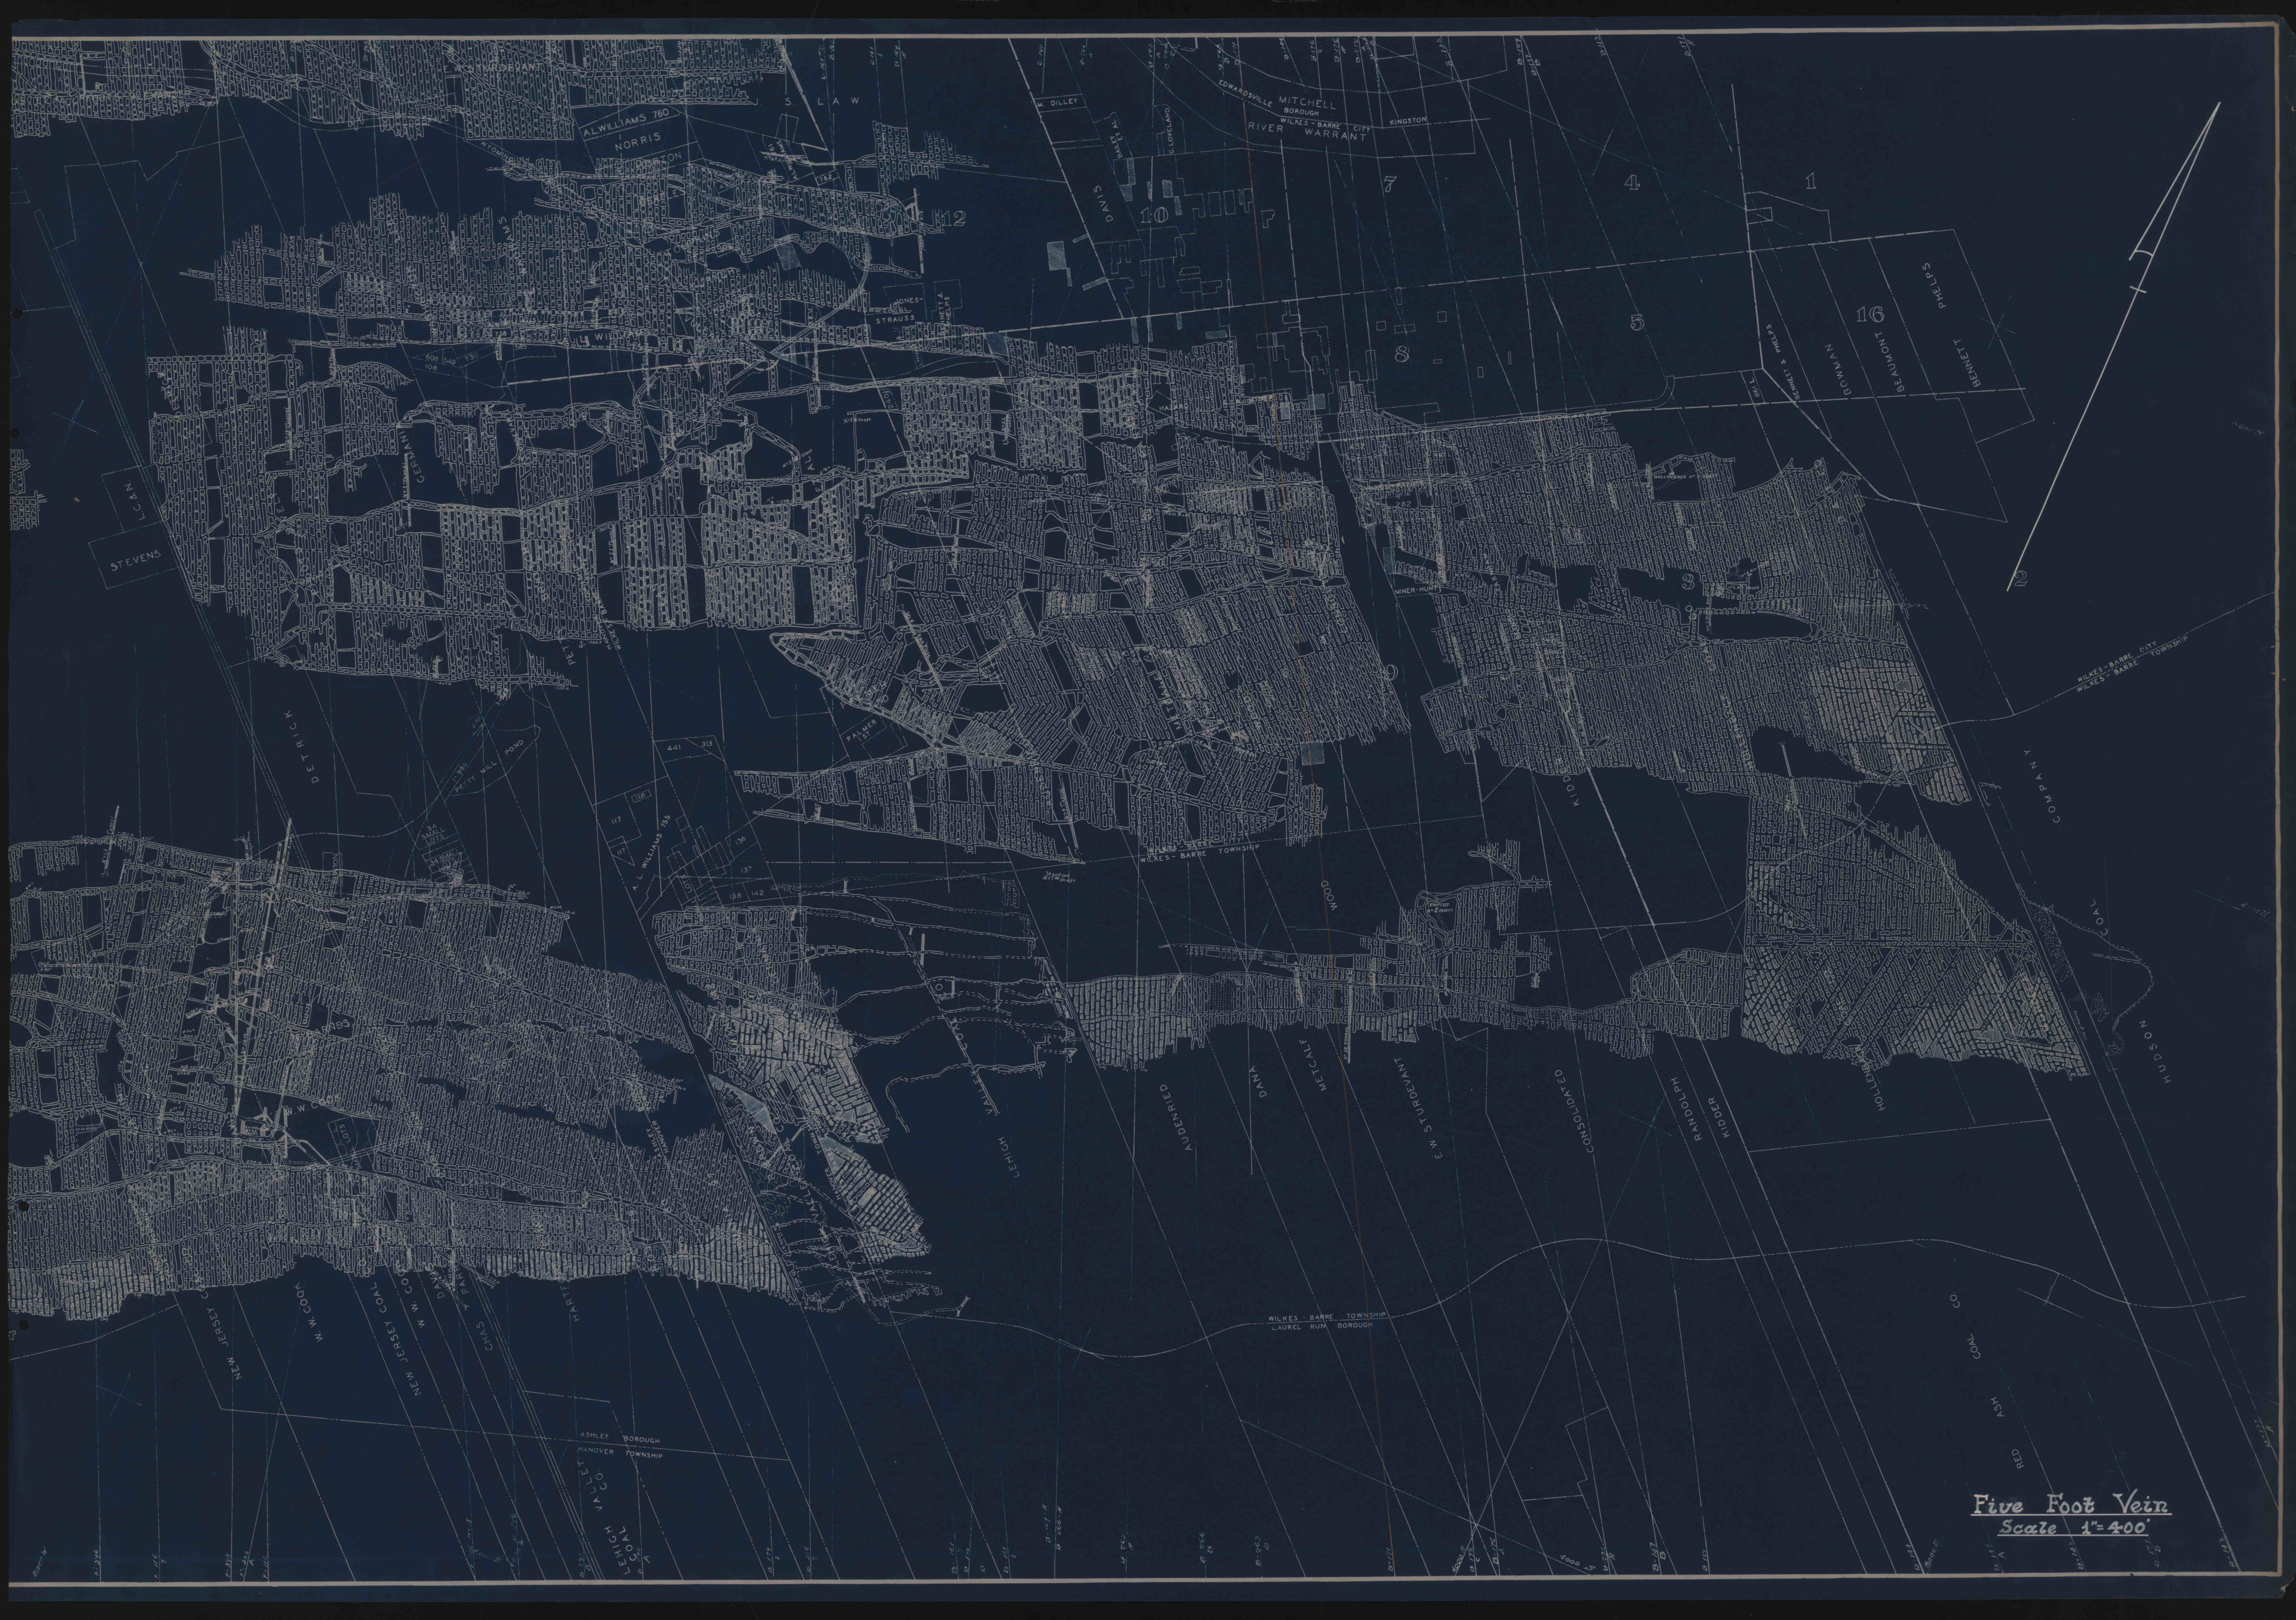

Five Foot Vein
Scale 1"=400'