


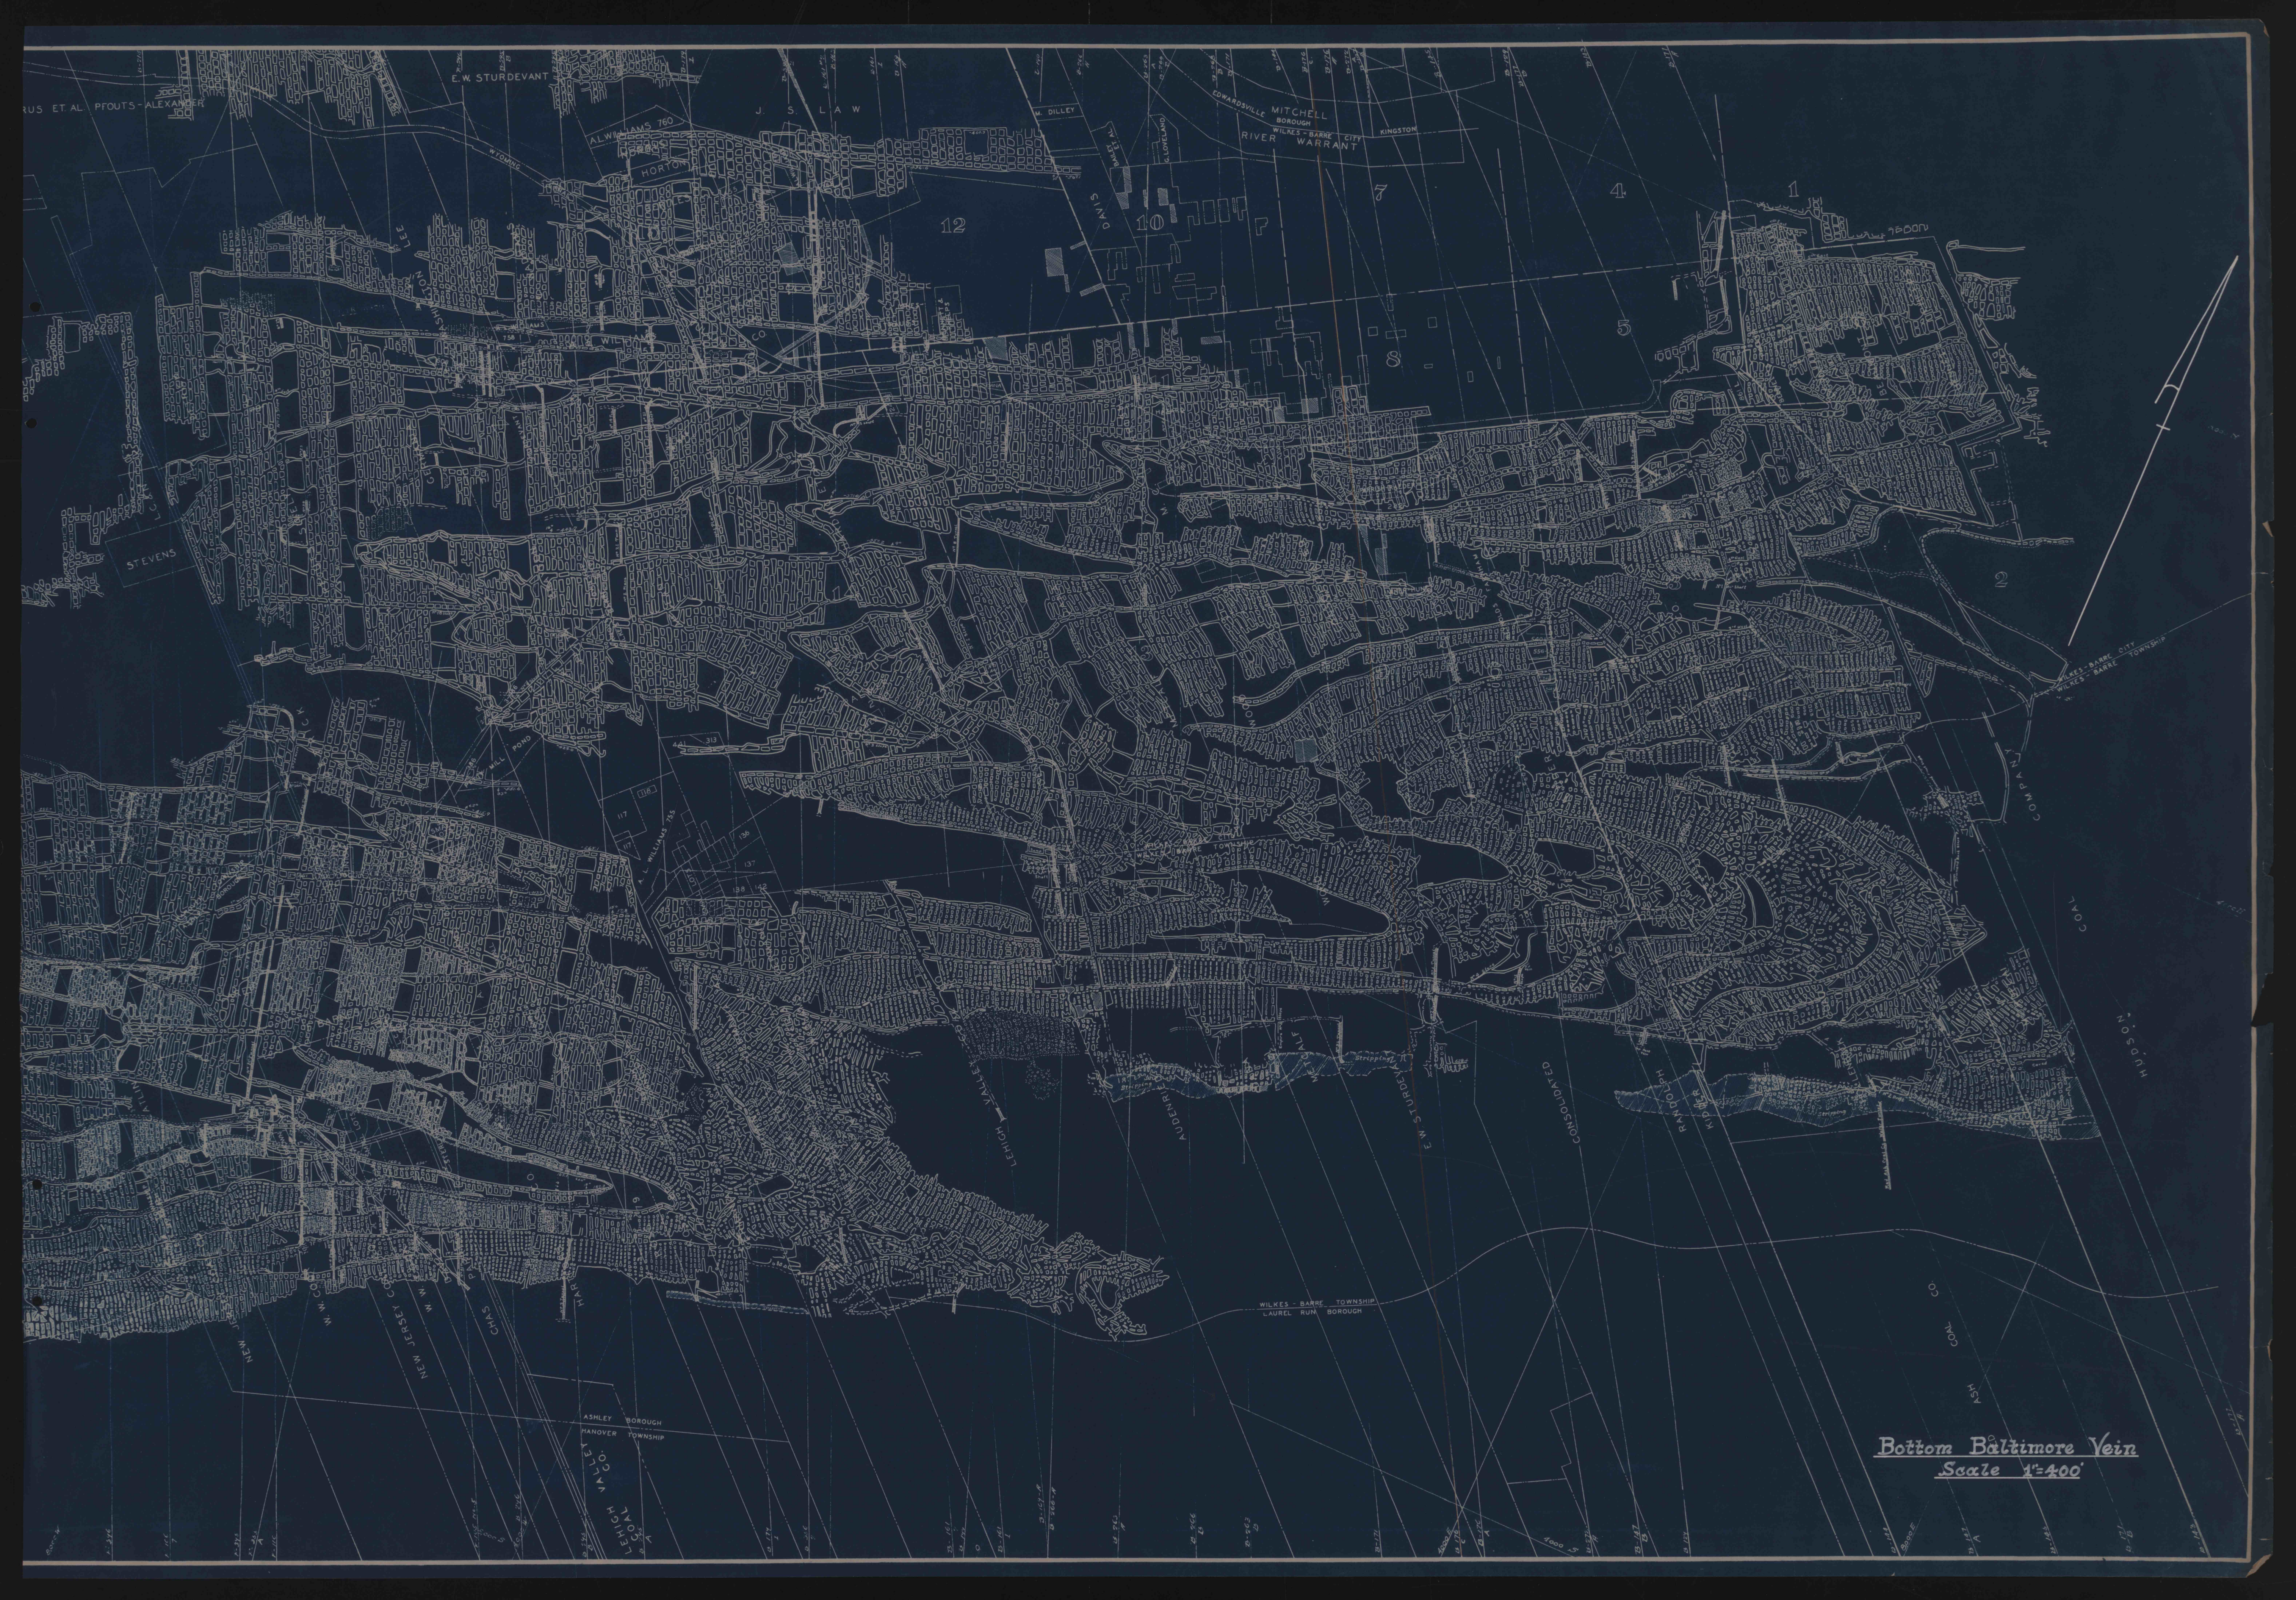

Bottom Baltimore Vein
Scale 1"=400'