


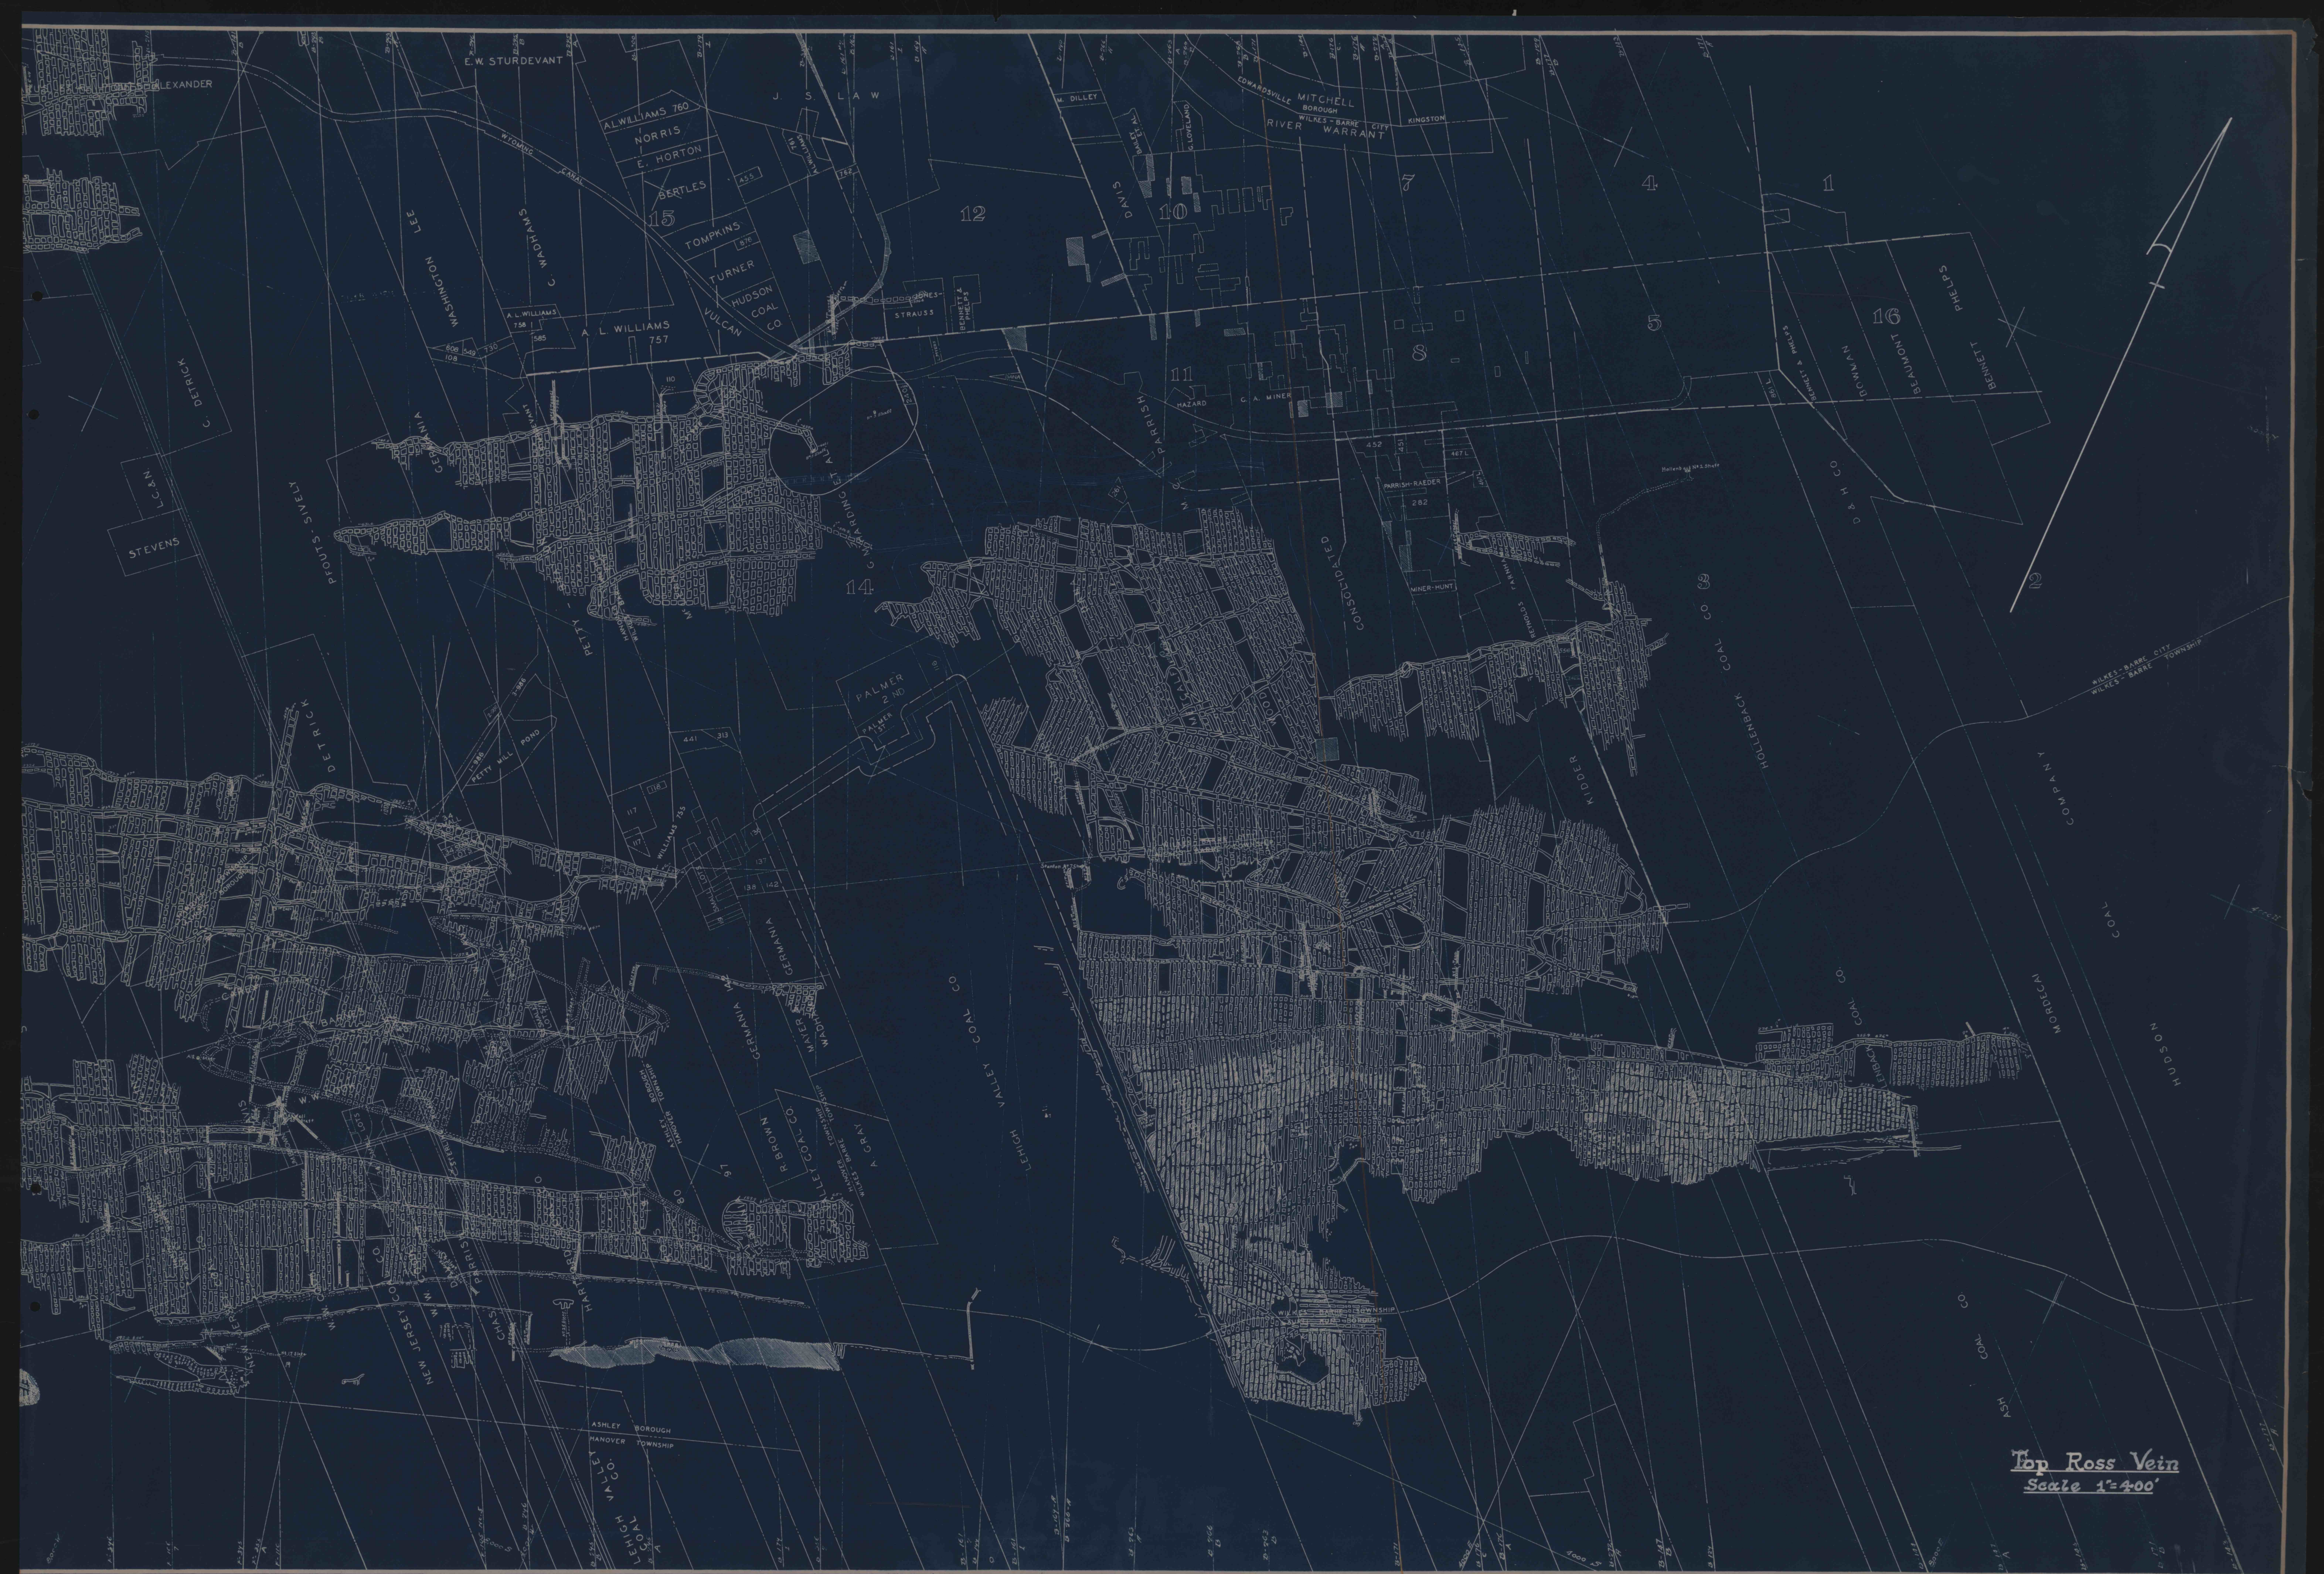

Top Ross Vein
Scale 1"=400'