


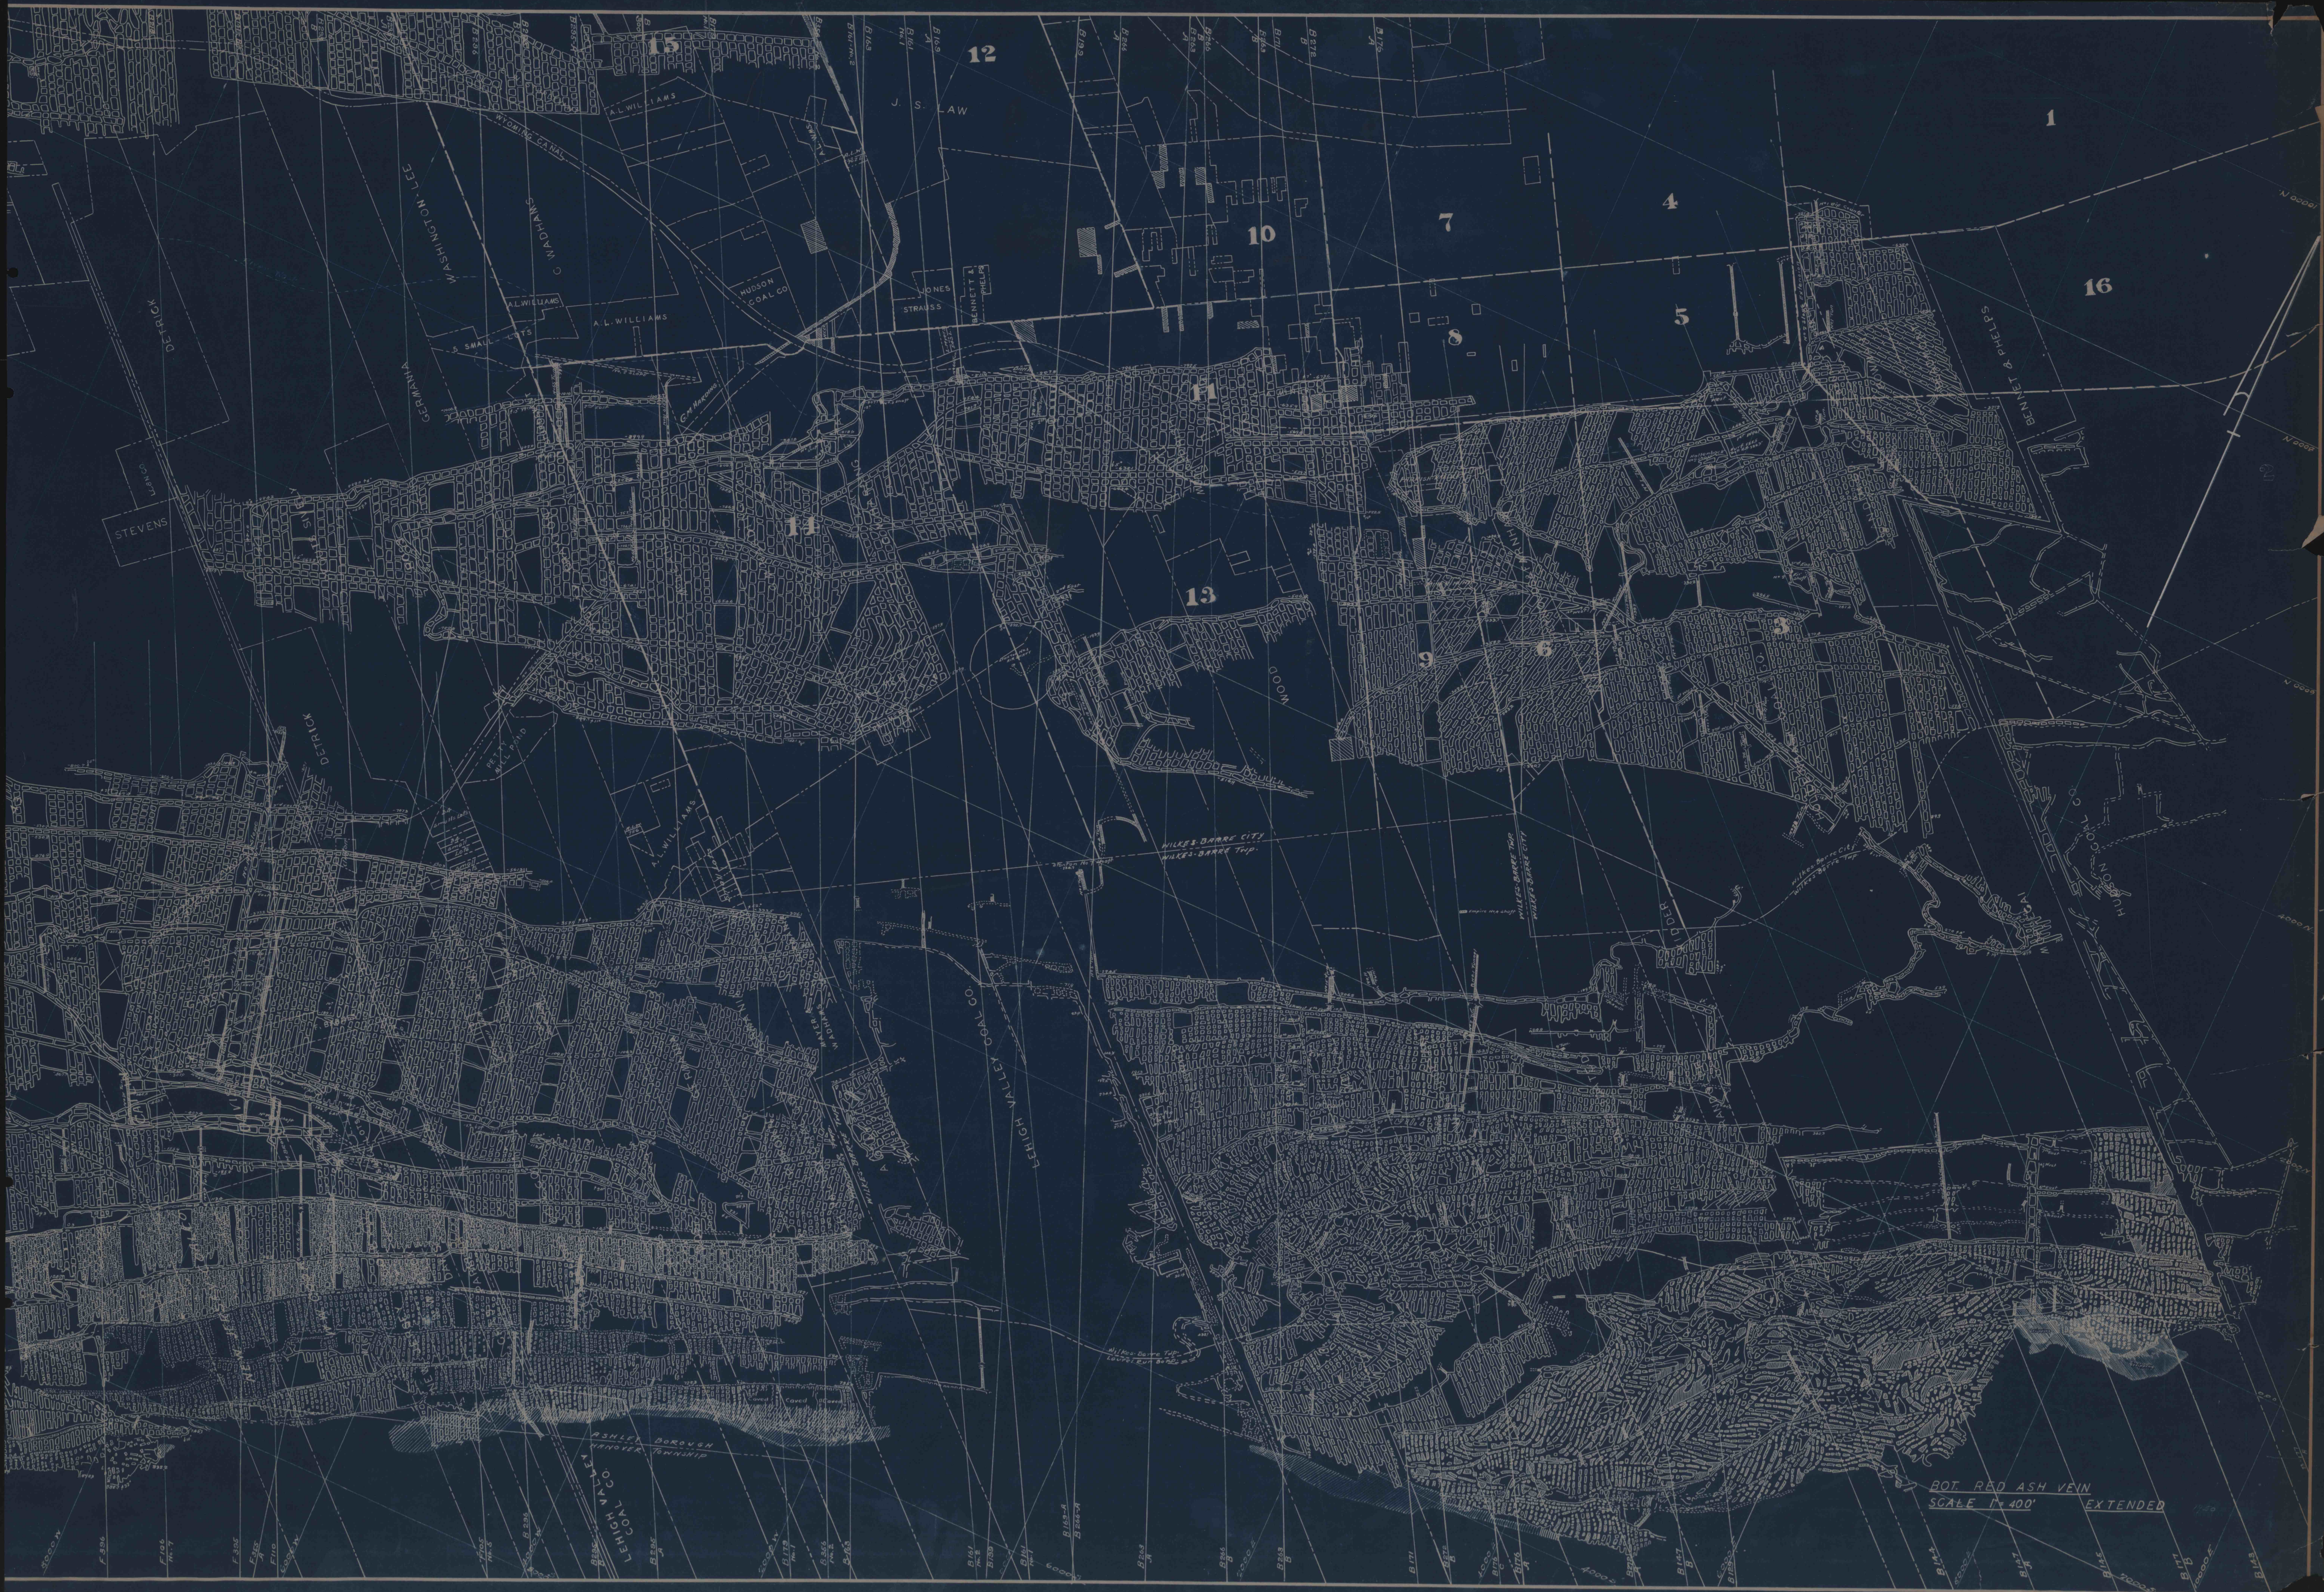

BOT. RED ASH VEIN
SCALE 1" = 400' EXTENDED