


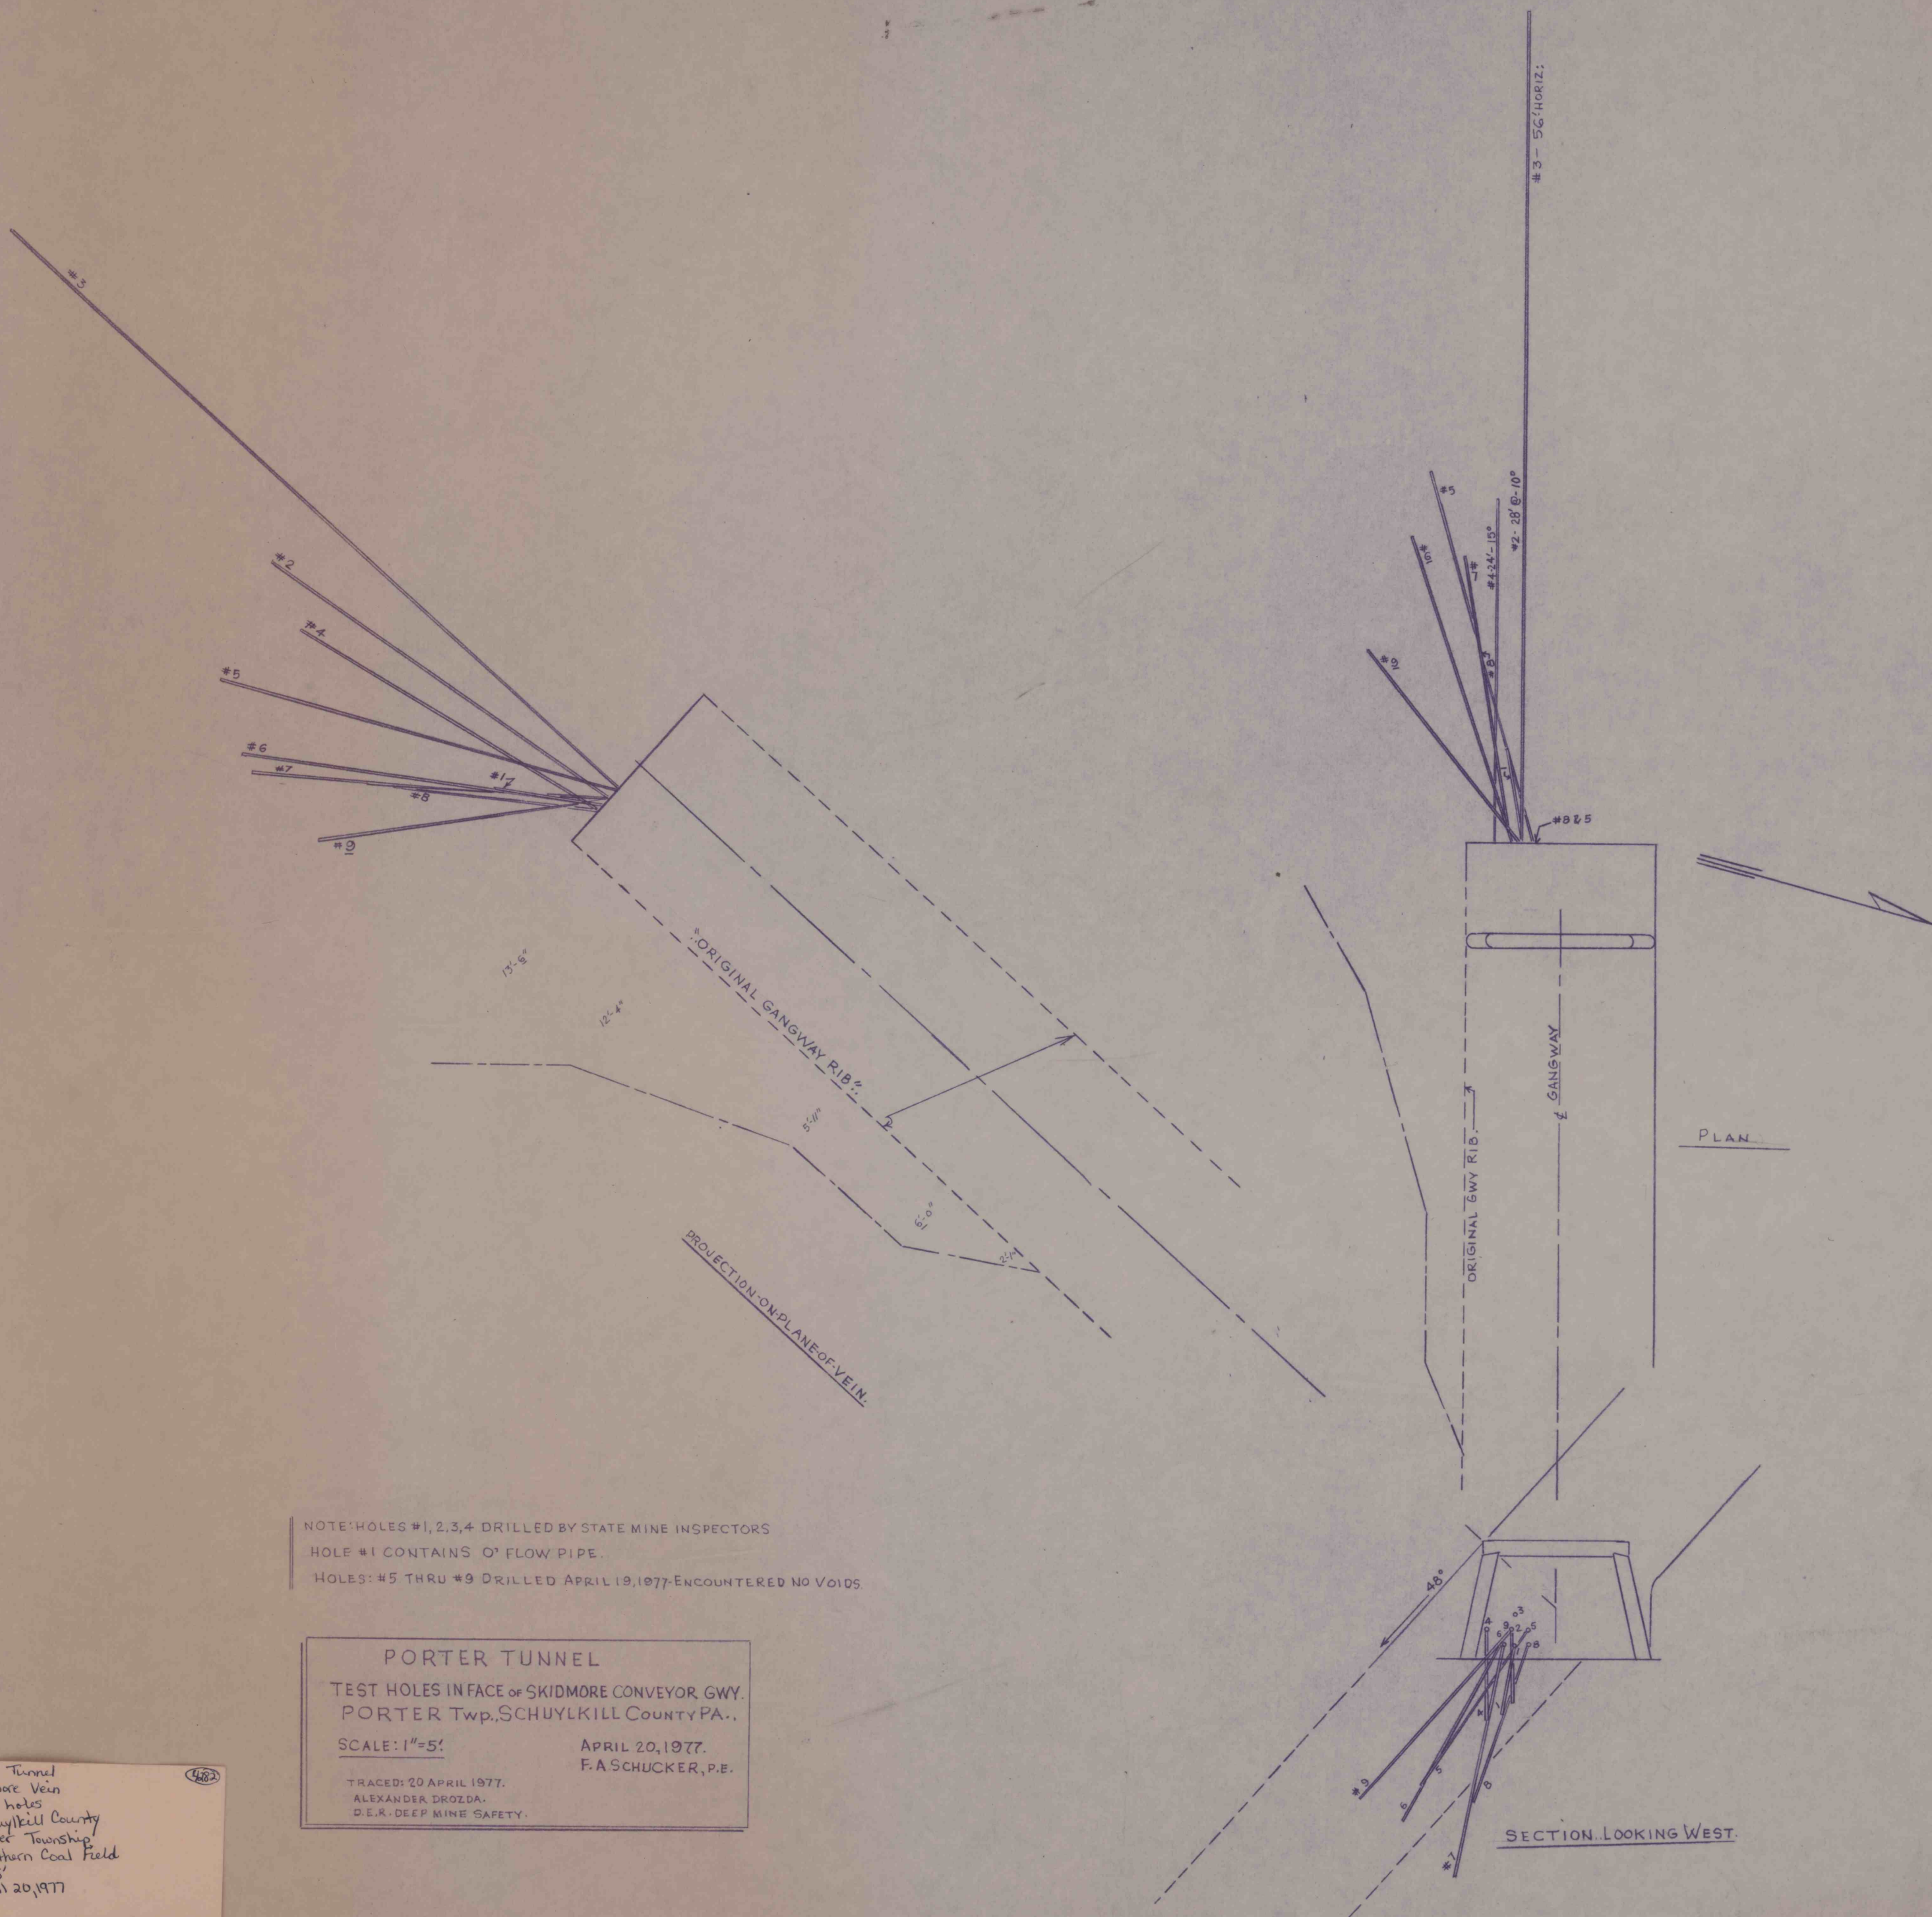

NOTE: HOLES #1, 2, 3, 4 DRILLED BY STATE MINE INSPECTORS
 HOLE #1 CONTAINS 0" FLOW PIPE.
 HOLES: #5 THRU #9 DRILLED APRIL 19, 1977-ENCOUNTERED NO VOIDS

PORTER TUNNEL
 TEST HOLES IN FACE OF SKIDMORE CONVEYOR GWY.
 PORTER TWP., SCHUYLKILL COUNTY PA.,
 SCALE: 1"=5'
 APRIL 20, 1977.
 F.A. SCHUCKER, P.E.
 TRACED: 20 APRIL 1977.
 ALEXANDER DROZDA,
 D.E.R. DEEP MINE SAFETY.

Porter Tunnel
 Skidmore Vein
 Test holes
 Schuylkill County
 Porter Township
 Southern Coal Field
 1"=5'
 April 20, 1977