


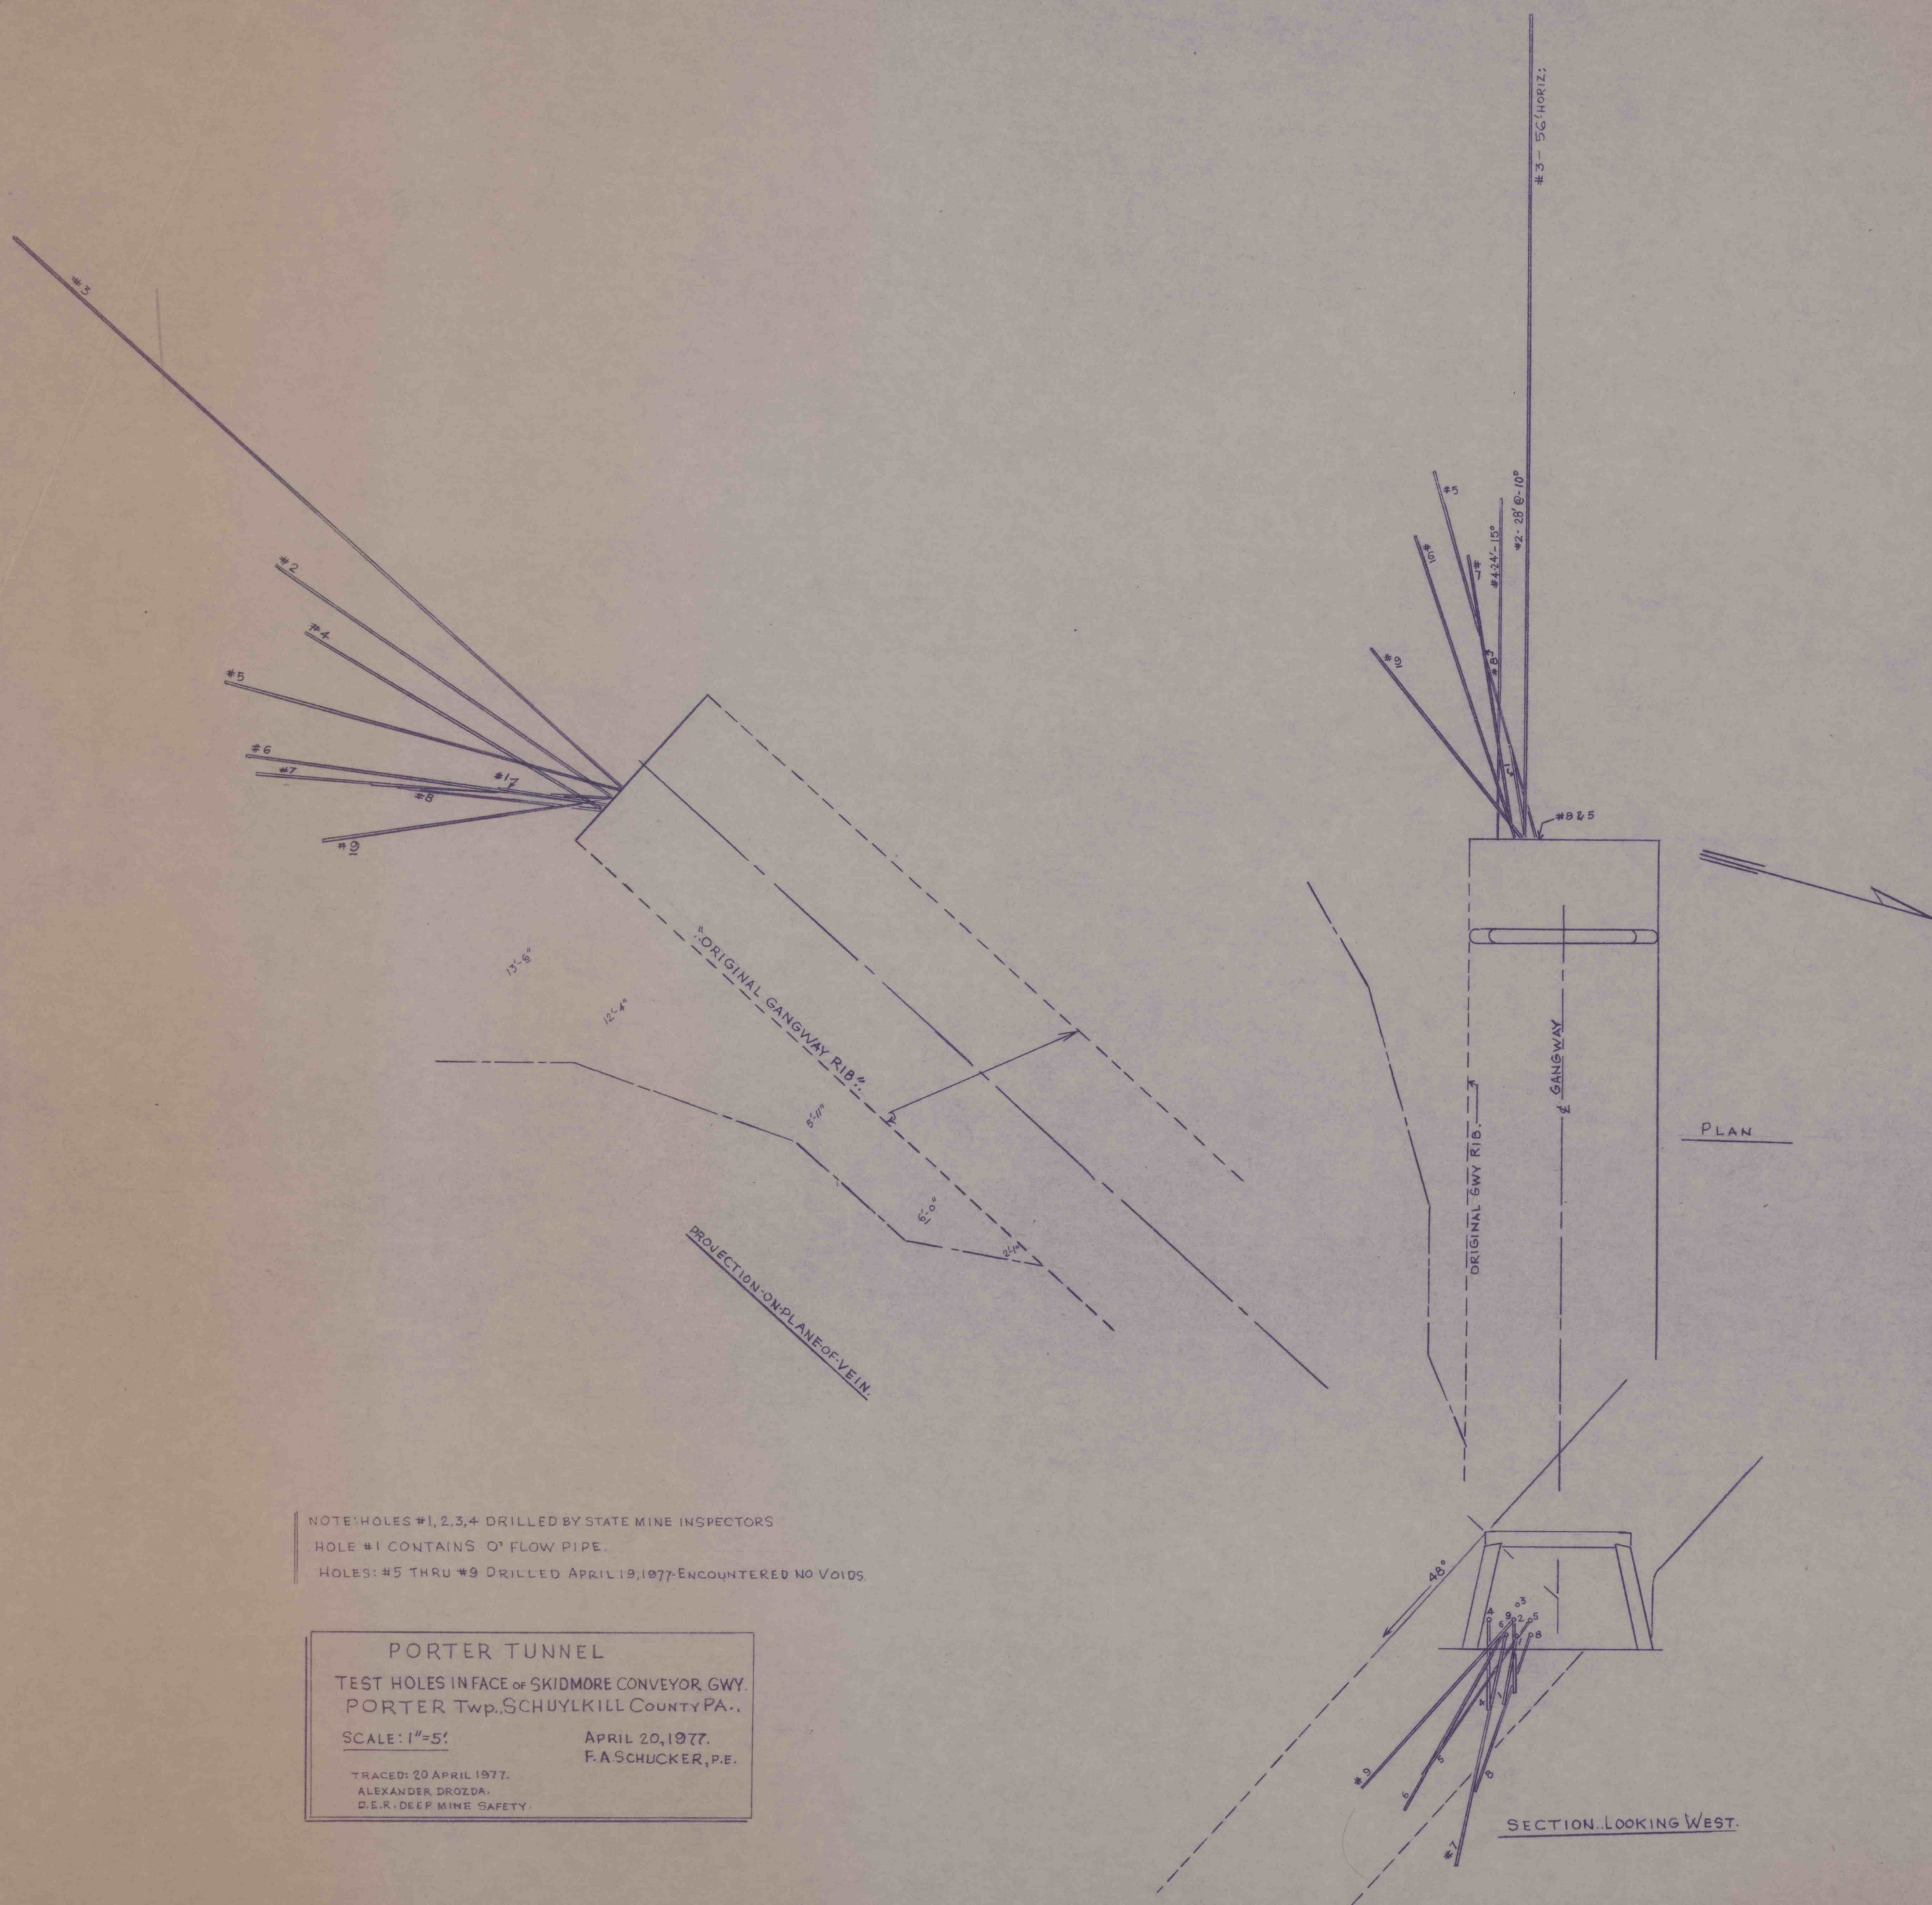

NOTE: HOLES #1, 2, 3, 4 DRILLED BY STATE MINE INSPECTORS  
 HOLE #1 CONTAINS 0" FLOW PIPE.  
 HOLES: #5 THRU #9 DRILLED APRIL 19, 1977. ENCOUNTERED NO VOIDS.

# PORTER TUNNEL

TEST HOLES IN FACE OF SKIDMORE CONVEYOR GWY.  
 PORTER Twp., SCHUYLKILL COUNTY PA.,

SCALE: 1"=5'

APRIL 20, 1977.  
 F.A. SCHUCKER, P.E.

TRACED: 20 APRIL 1977.  
 ALEXANDER DROZDA,  
 D.E.R., DEEP MINE SAFETY.