


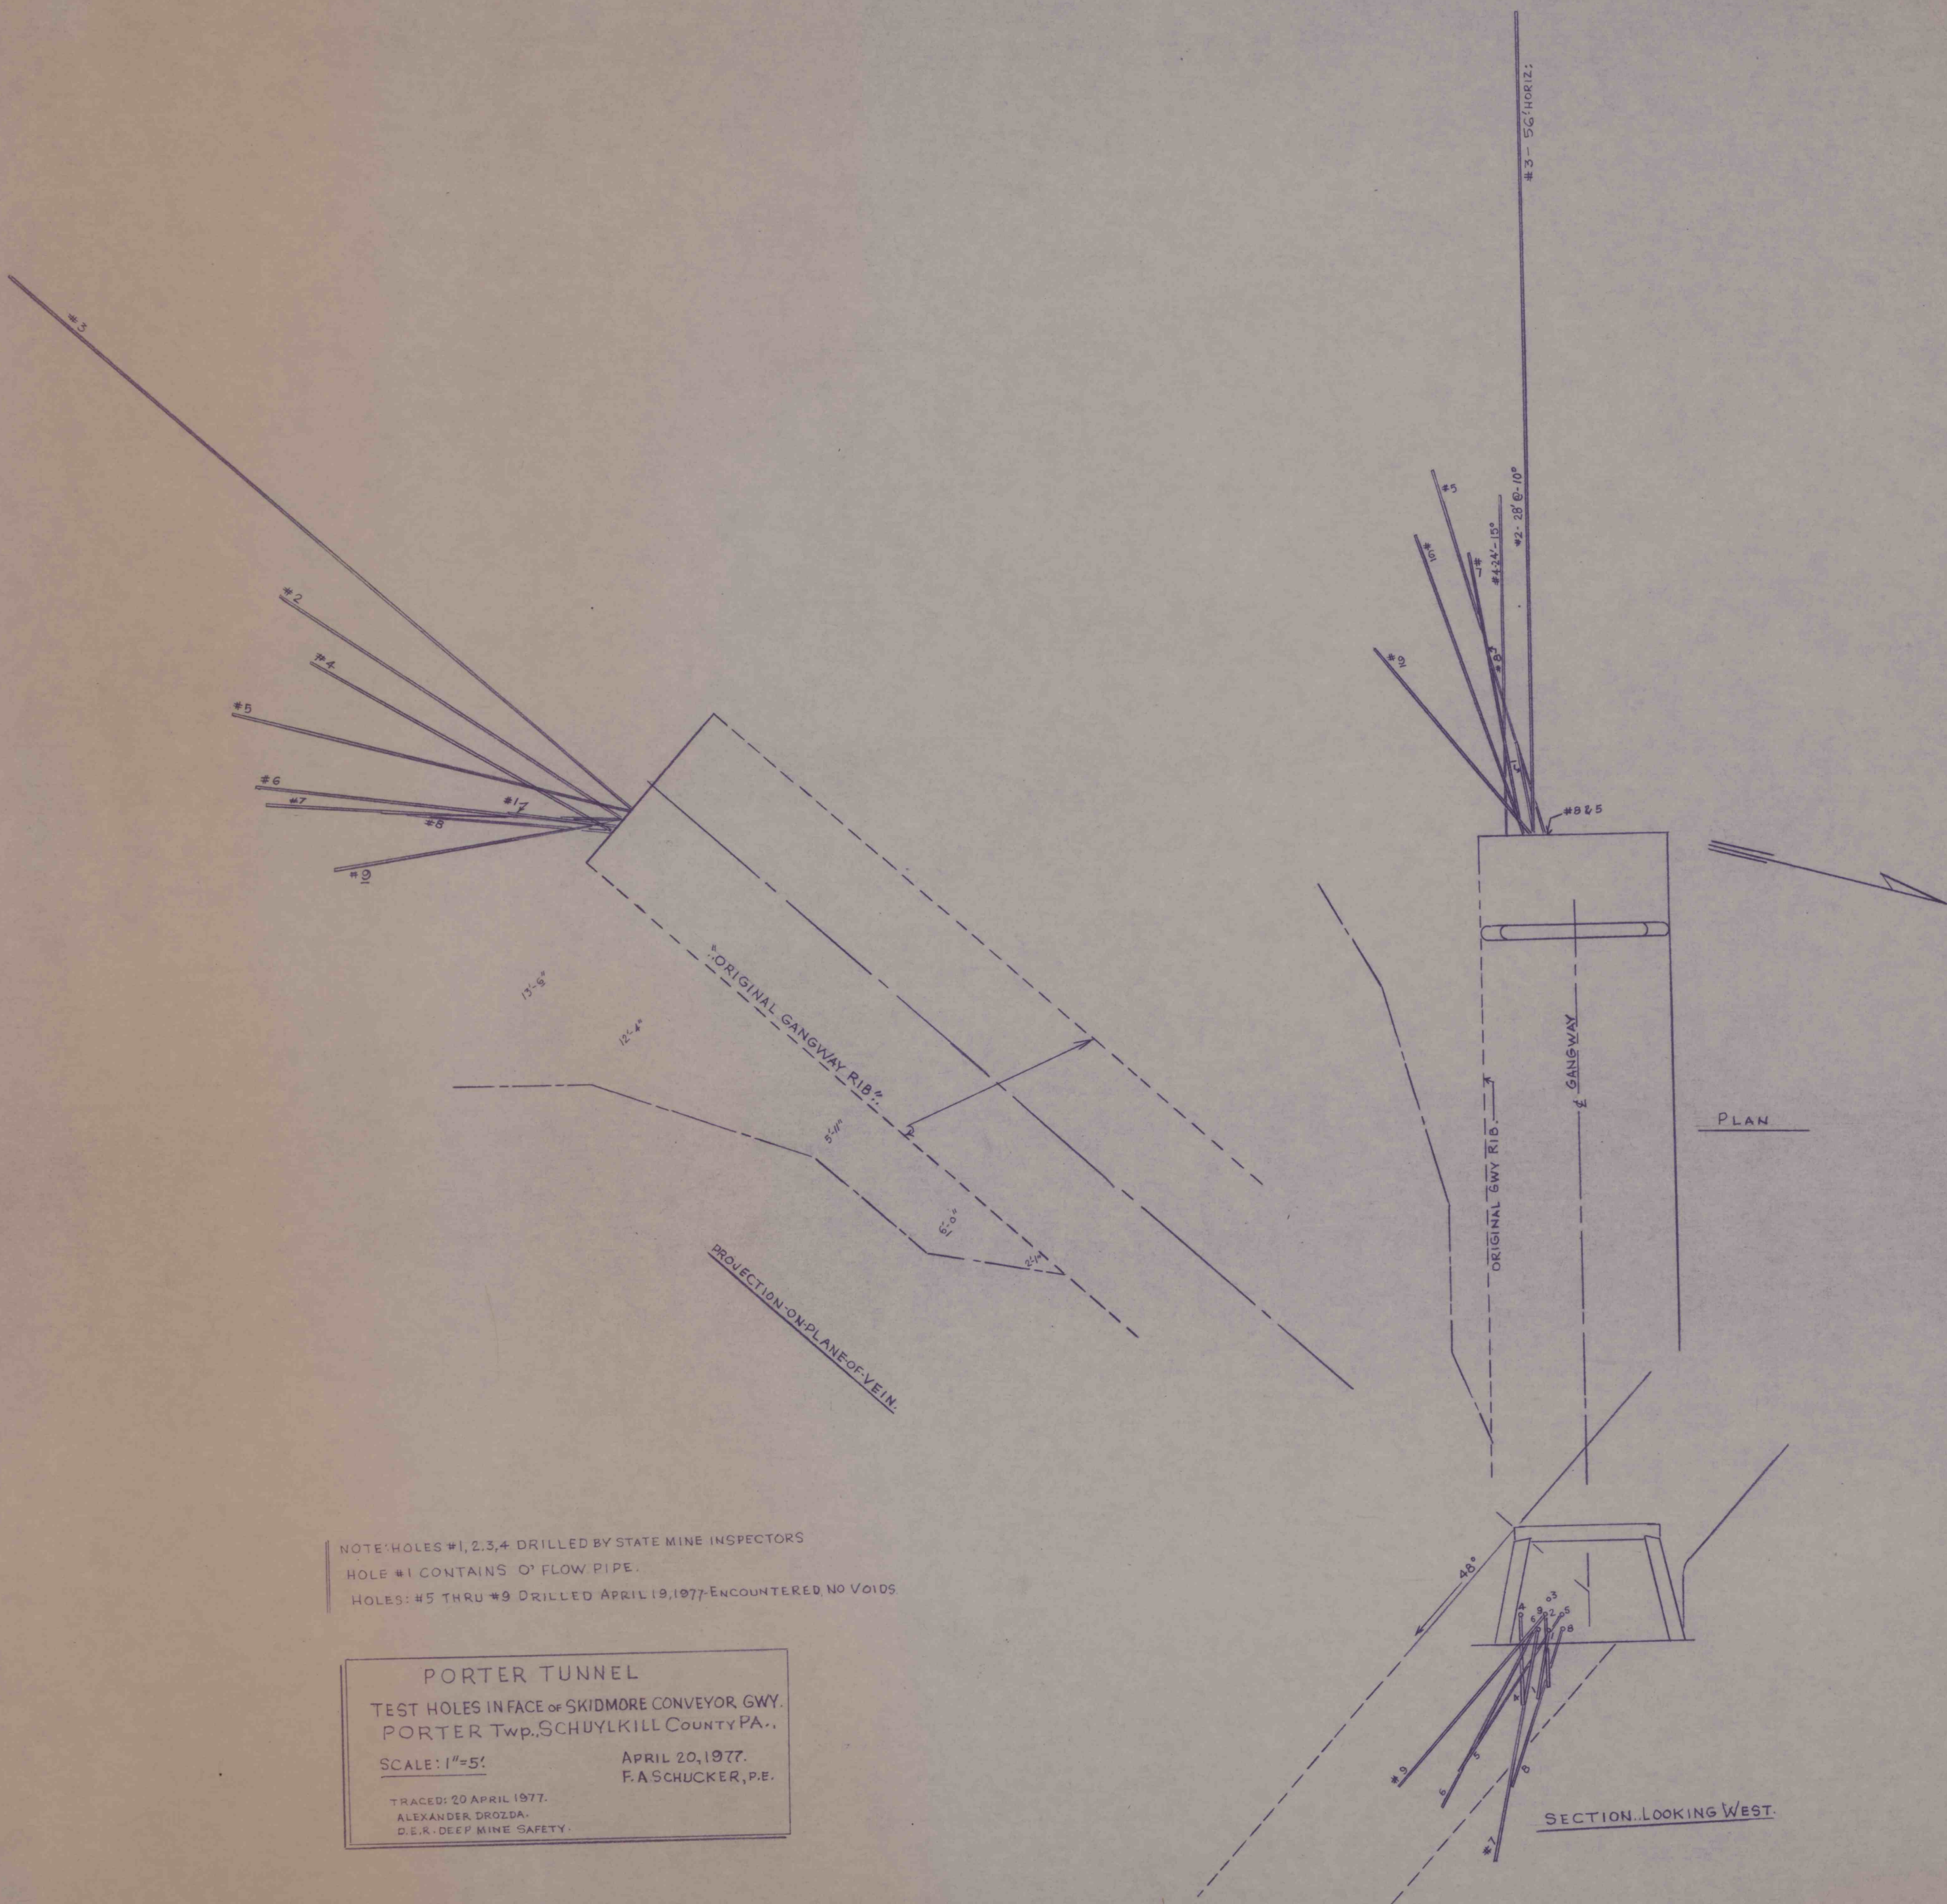

NOTE: HOLES #1, 2, 3, 4 DRILLED BY STATE MINE INSPECTORS  
 HOLE #1 CONTAINS 0" FLOW PIPE.  
 HOLES: #5 THRU #9 DRILLED APRIL 19, 1977- ENCOUNTERED NO VOIDS

PORTER TUNNEL  
 TEST HOLES IN FACE OF SKIDMORE CONVEYOR GWY.  
 PORTER Twp., SCHUYLKILL COUNTY PA.,

SCALE: 1"=5'

APRIL 20, 1977.  
 F.A. SCHUCKER, P.E.

TRACED: 20 APRIL 1977.  
 ALEXANDER DROZDA.  
 D.E.R. DEEP MINE SAFETY.

SECTION..LOOKING WEST.