


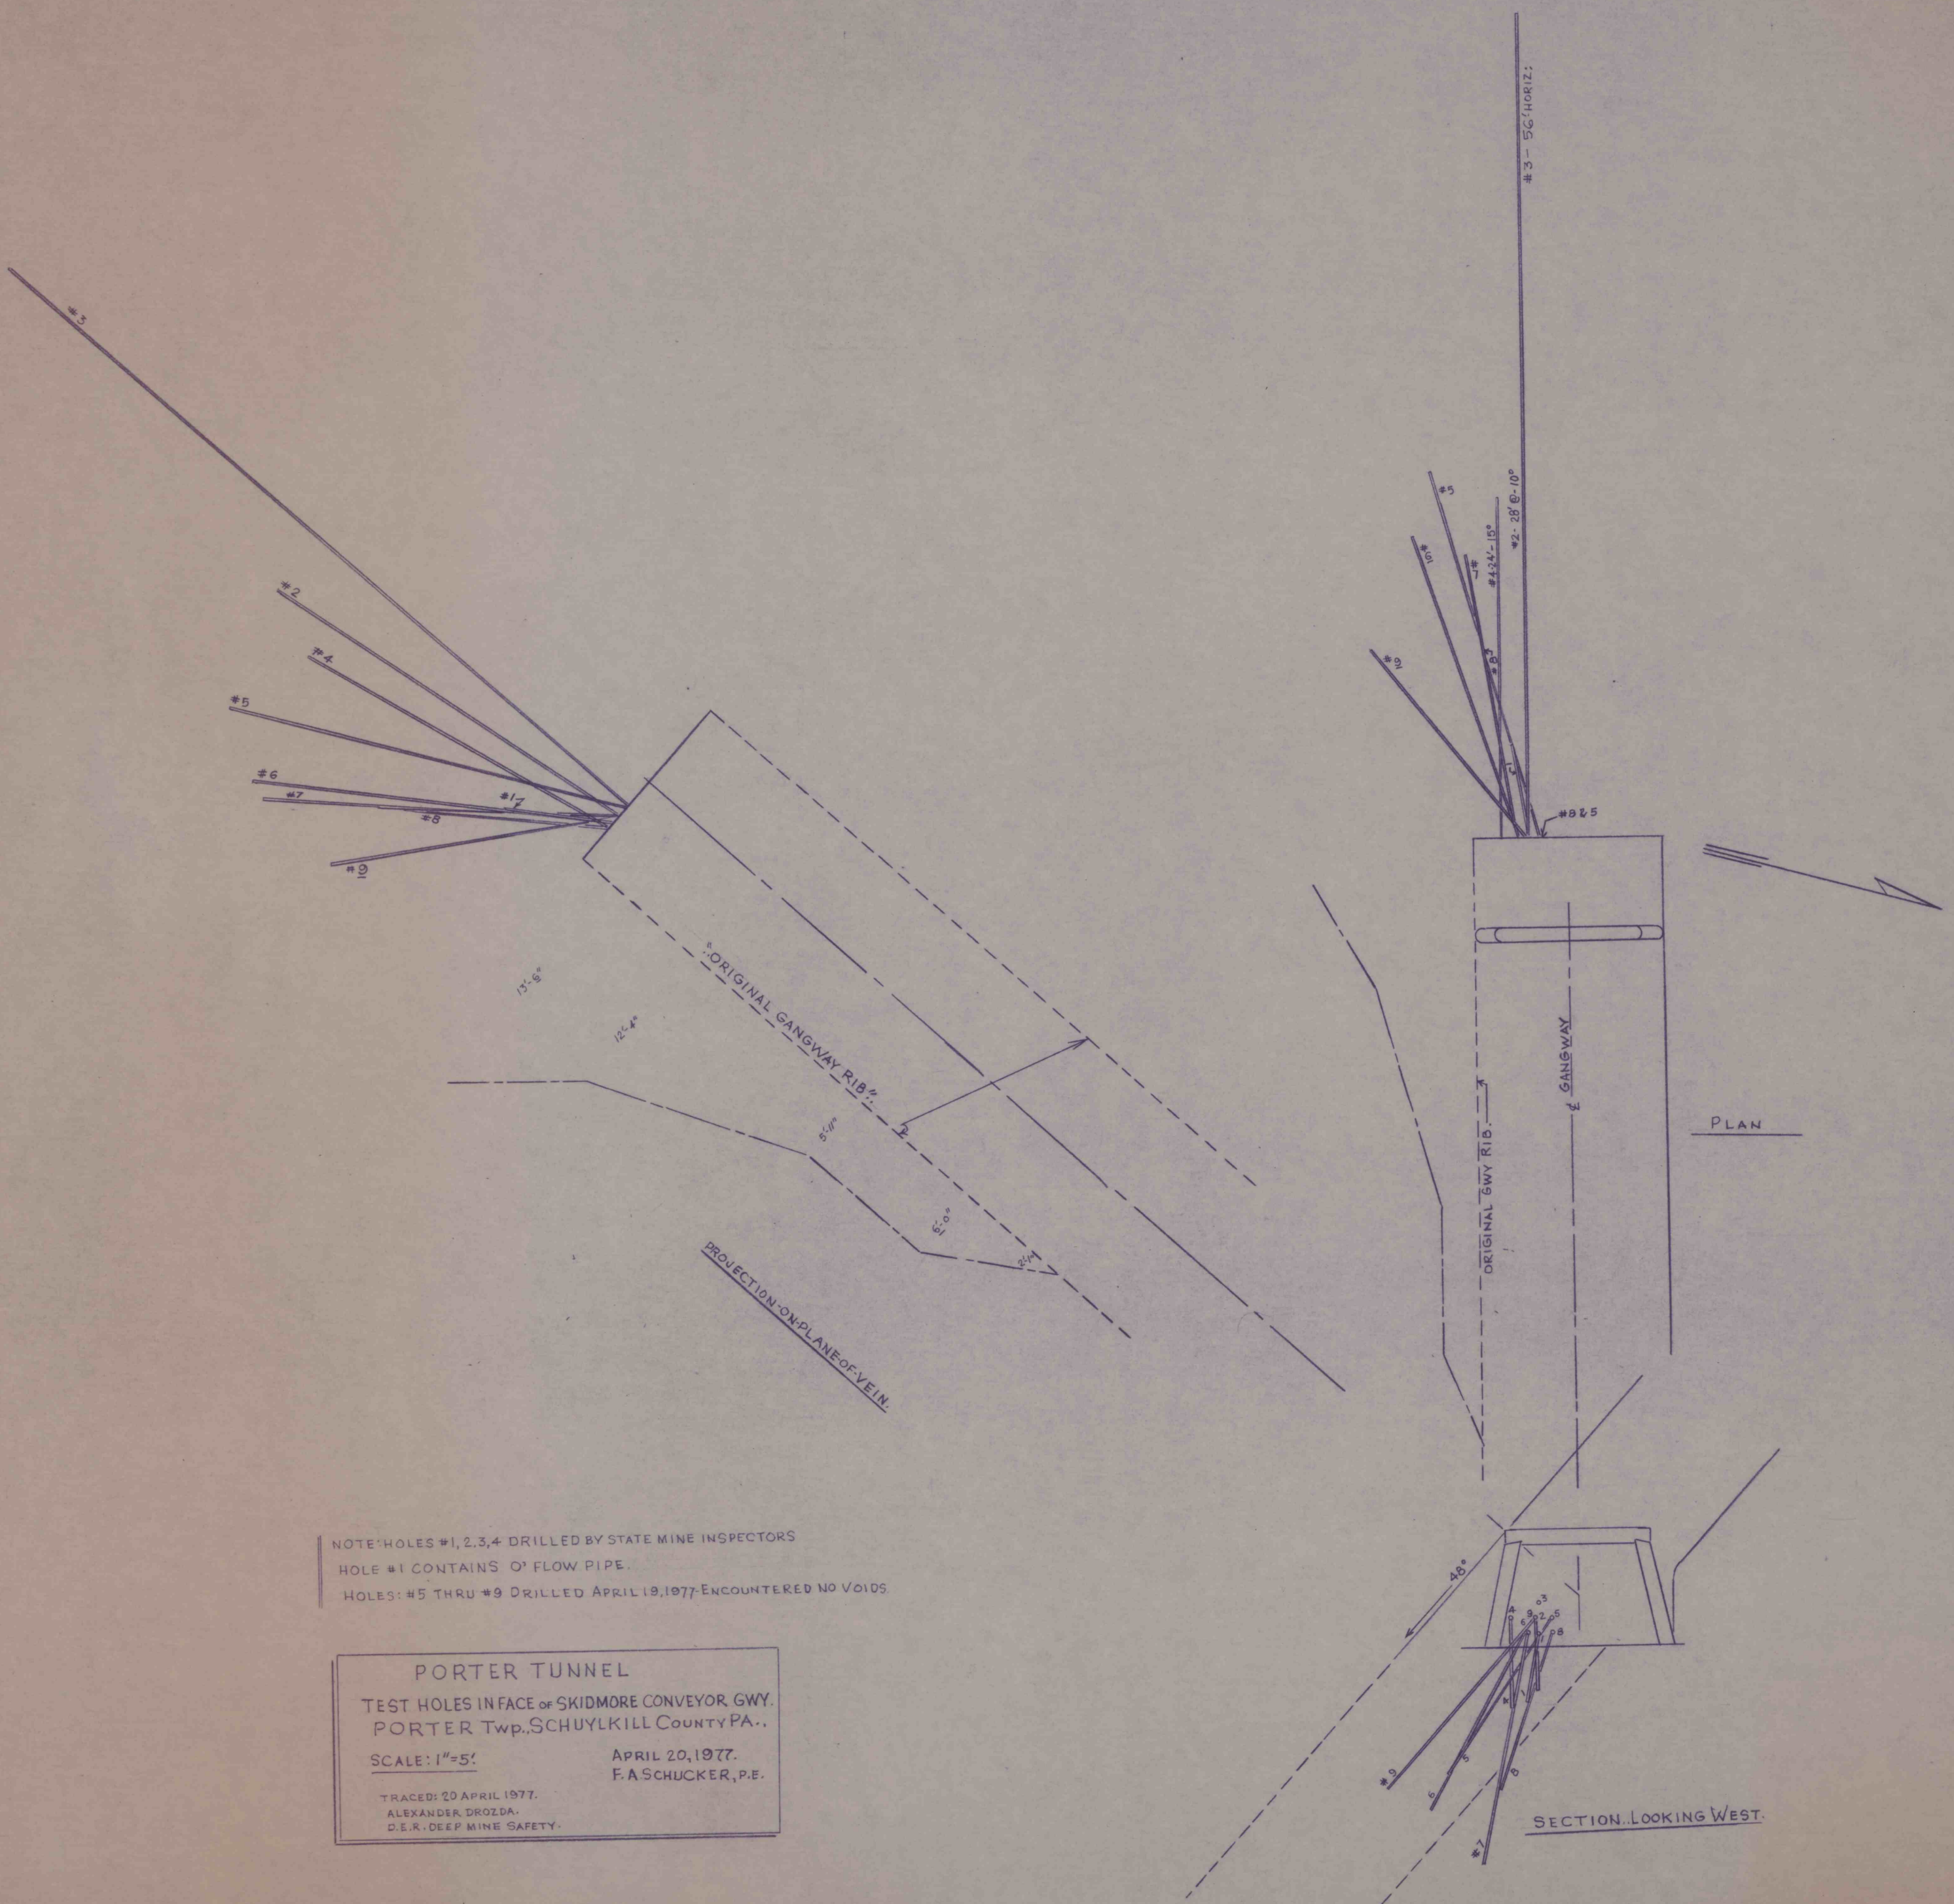

NOTE: HOLES #1, 2, 3, 4 DRILLED BY STATE MINE INSPECTORS
 HOLE #1 CONTAINS O' FLOW PIPE.
 HOLES: #5 THRU #9 DRILLED APRIL 19, 1977- ENCOUNTERED NO VOIDS.

PORTER TUNNEL

TEST HOLES IN FACE OF SKIDMORE CONVEYOR GWY.
 PORTER Twp., SCHUYLKILL COUNTY PA..

SCALE: 1"=5'

APRIL 20, 1977.

F.A. SCHUCKER, P.E.

TRACED: 20 APRIL 1977.
 ALEXANDER DROZDA.
 D.E.R. DEEP MINE SAFETY.