


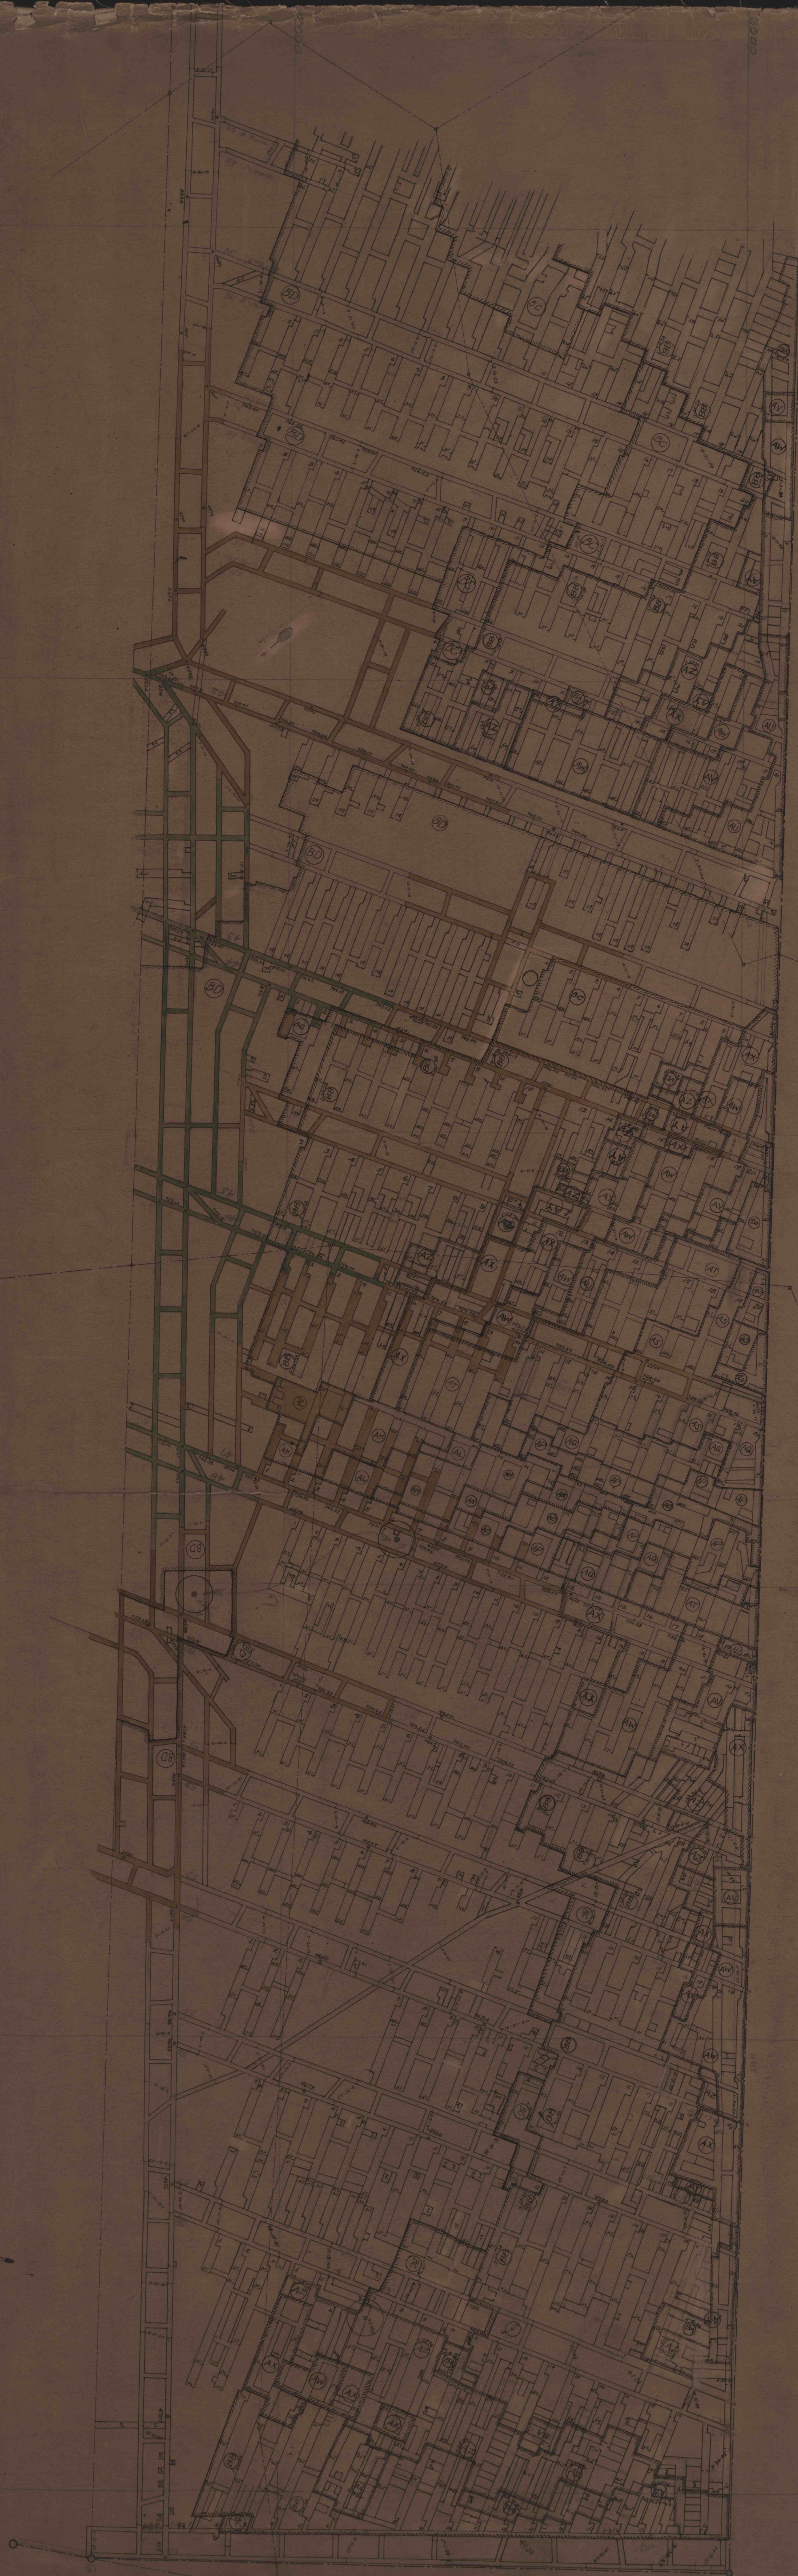

11000 8200

12000 7200

13000 6200

14000 5200

15000 4200

16000 3200

