




Fairchance

Scale - 100' = 1 inch

H. O. FRICK COKE CO.
DRAWING NO. 9
CASE 1 DRAWER 3

Hultman - March 24-96

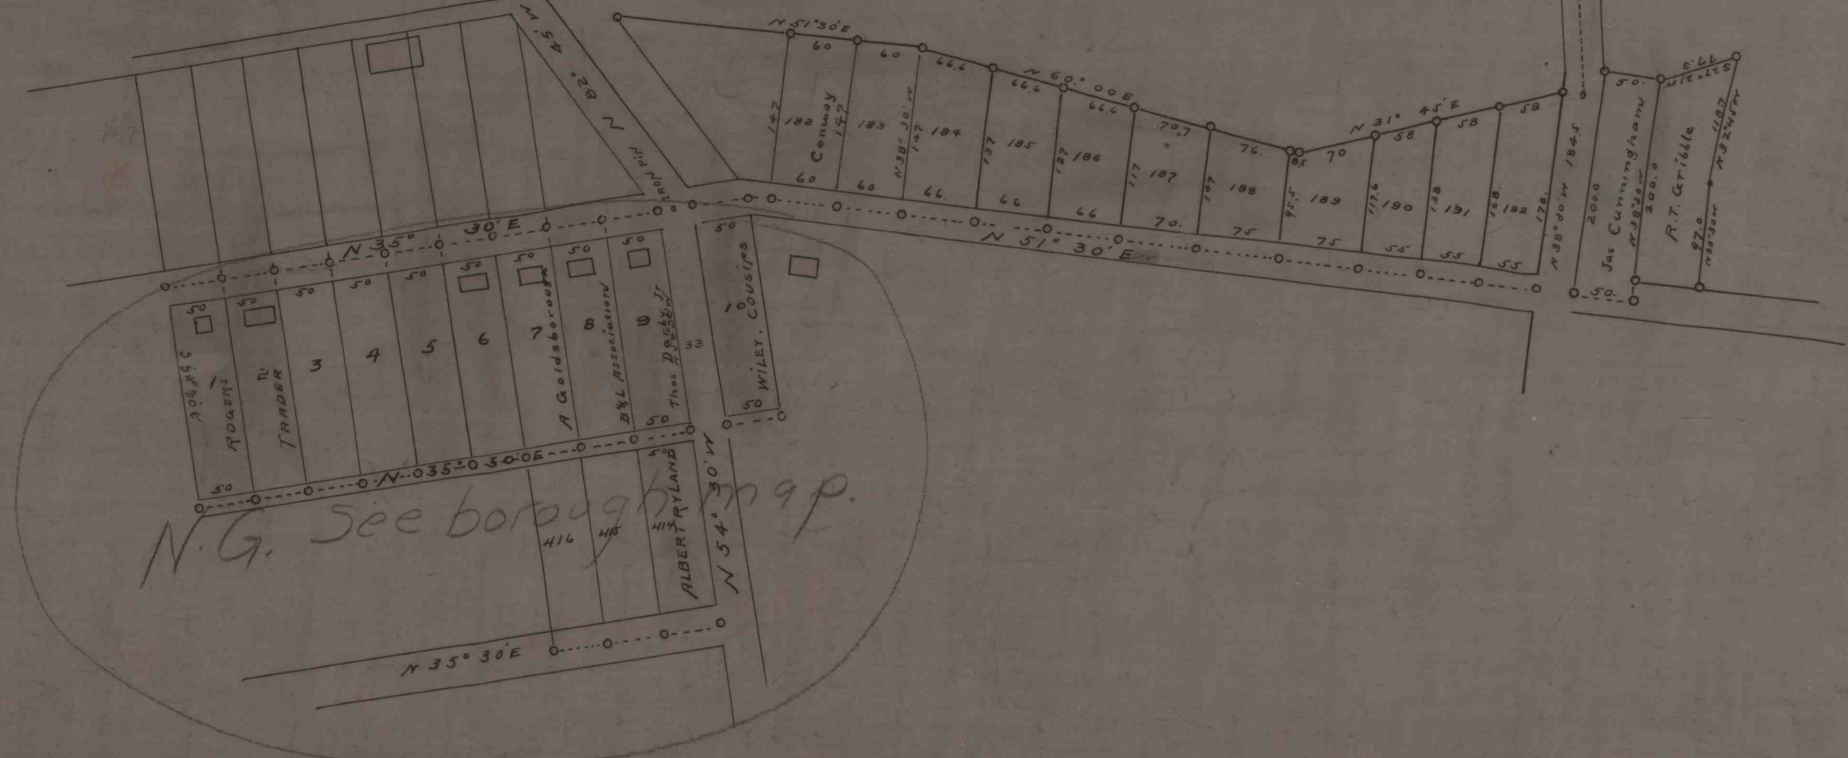

Fairchance
Survey
by J.D. Boyd