


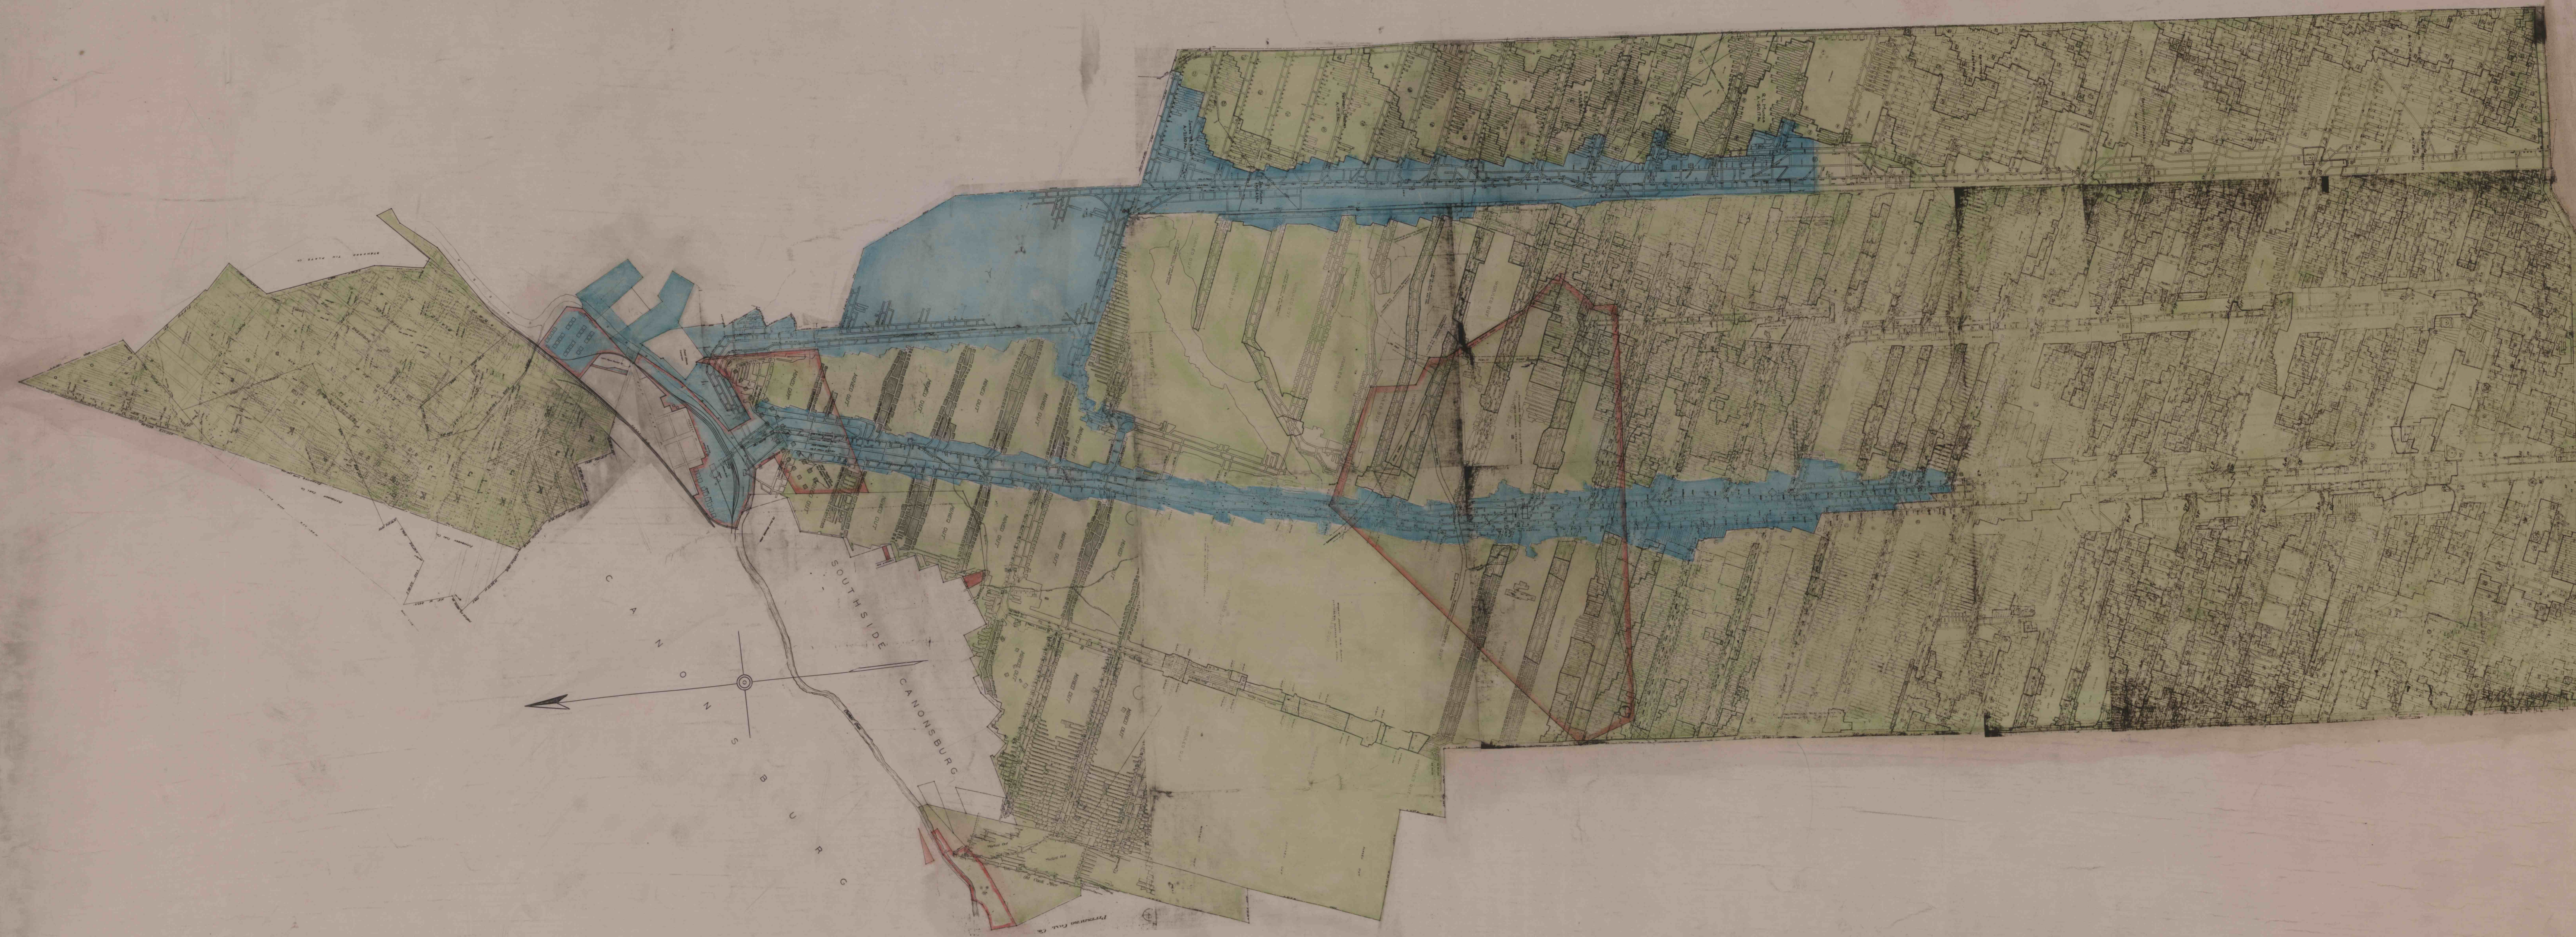

KEY	
 	COAL ONLY - UNMINED
 	COAL & SURFACE - UNMINED
 	COAL & SURFACE - MINED OUT
 	COAL ONLY - MINED OUT
 	SURFACE ONLY

PROPERTY MAP
 CANONSBURG COAL CO.
 LOCATED IN CANONSBURG BORO. & N. STRABANE TWP.
 WASHINGTON CO. PENNA.
 SCALE- 1"=400'

FEB. 20 1941 GR-6