


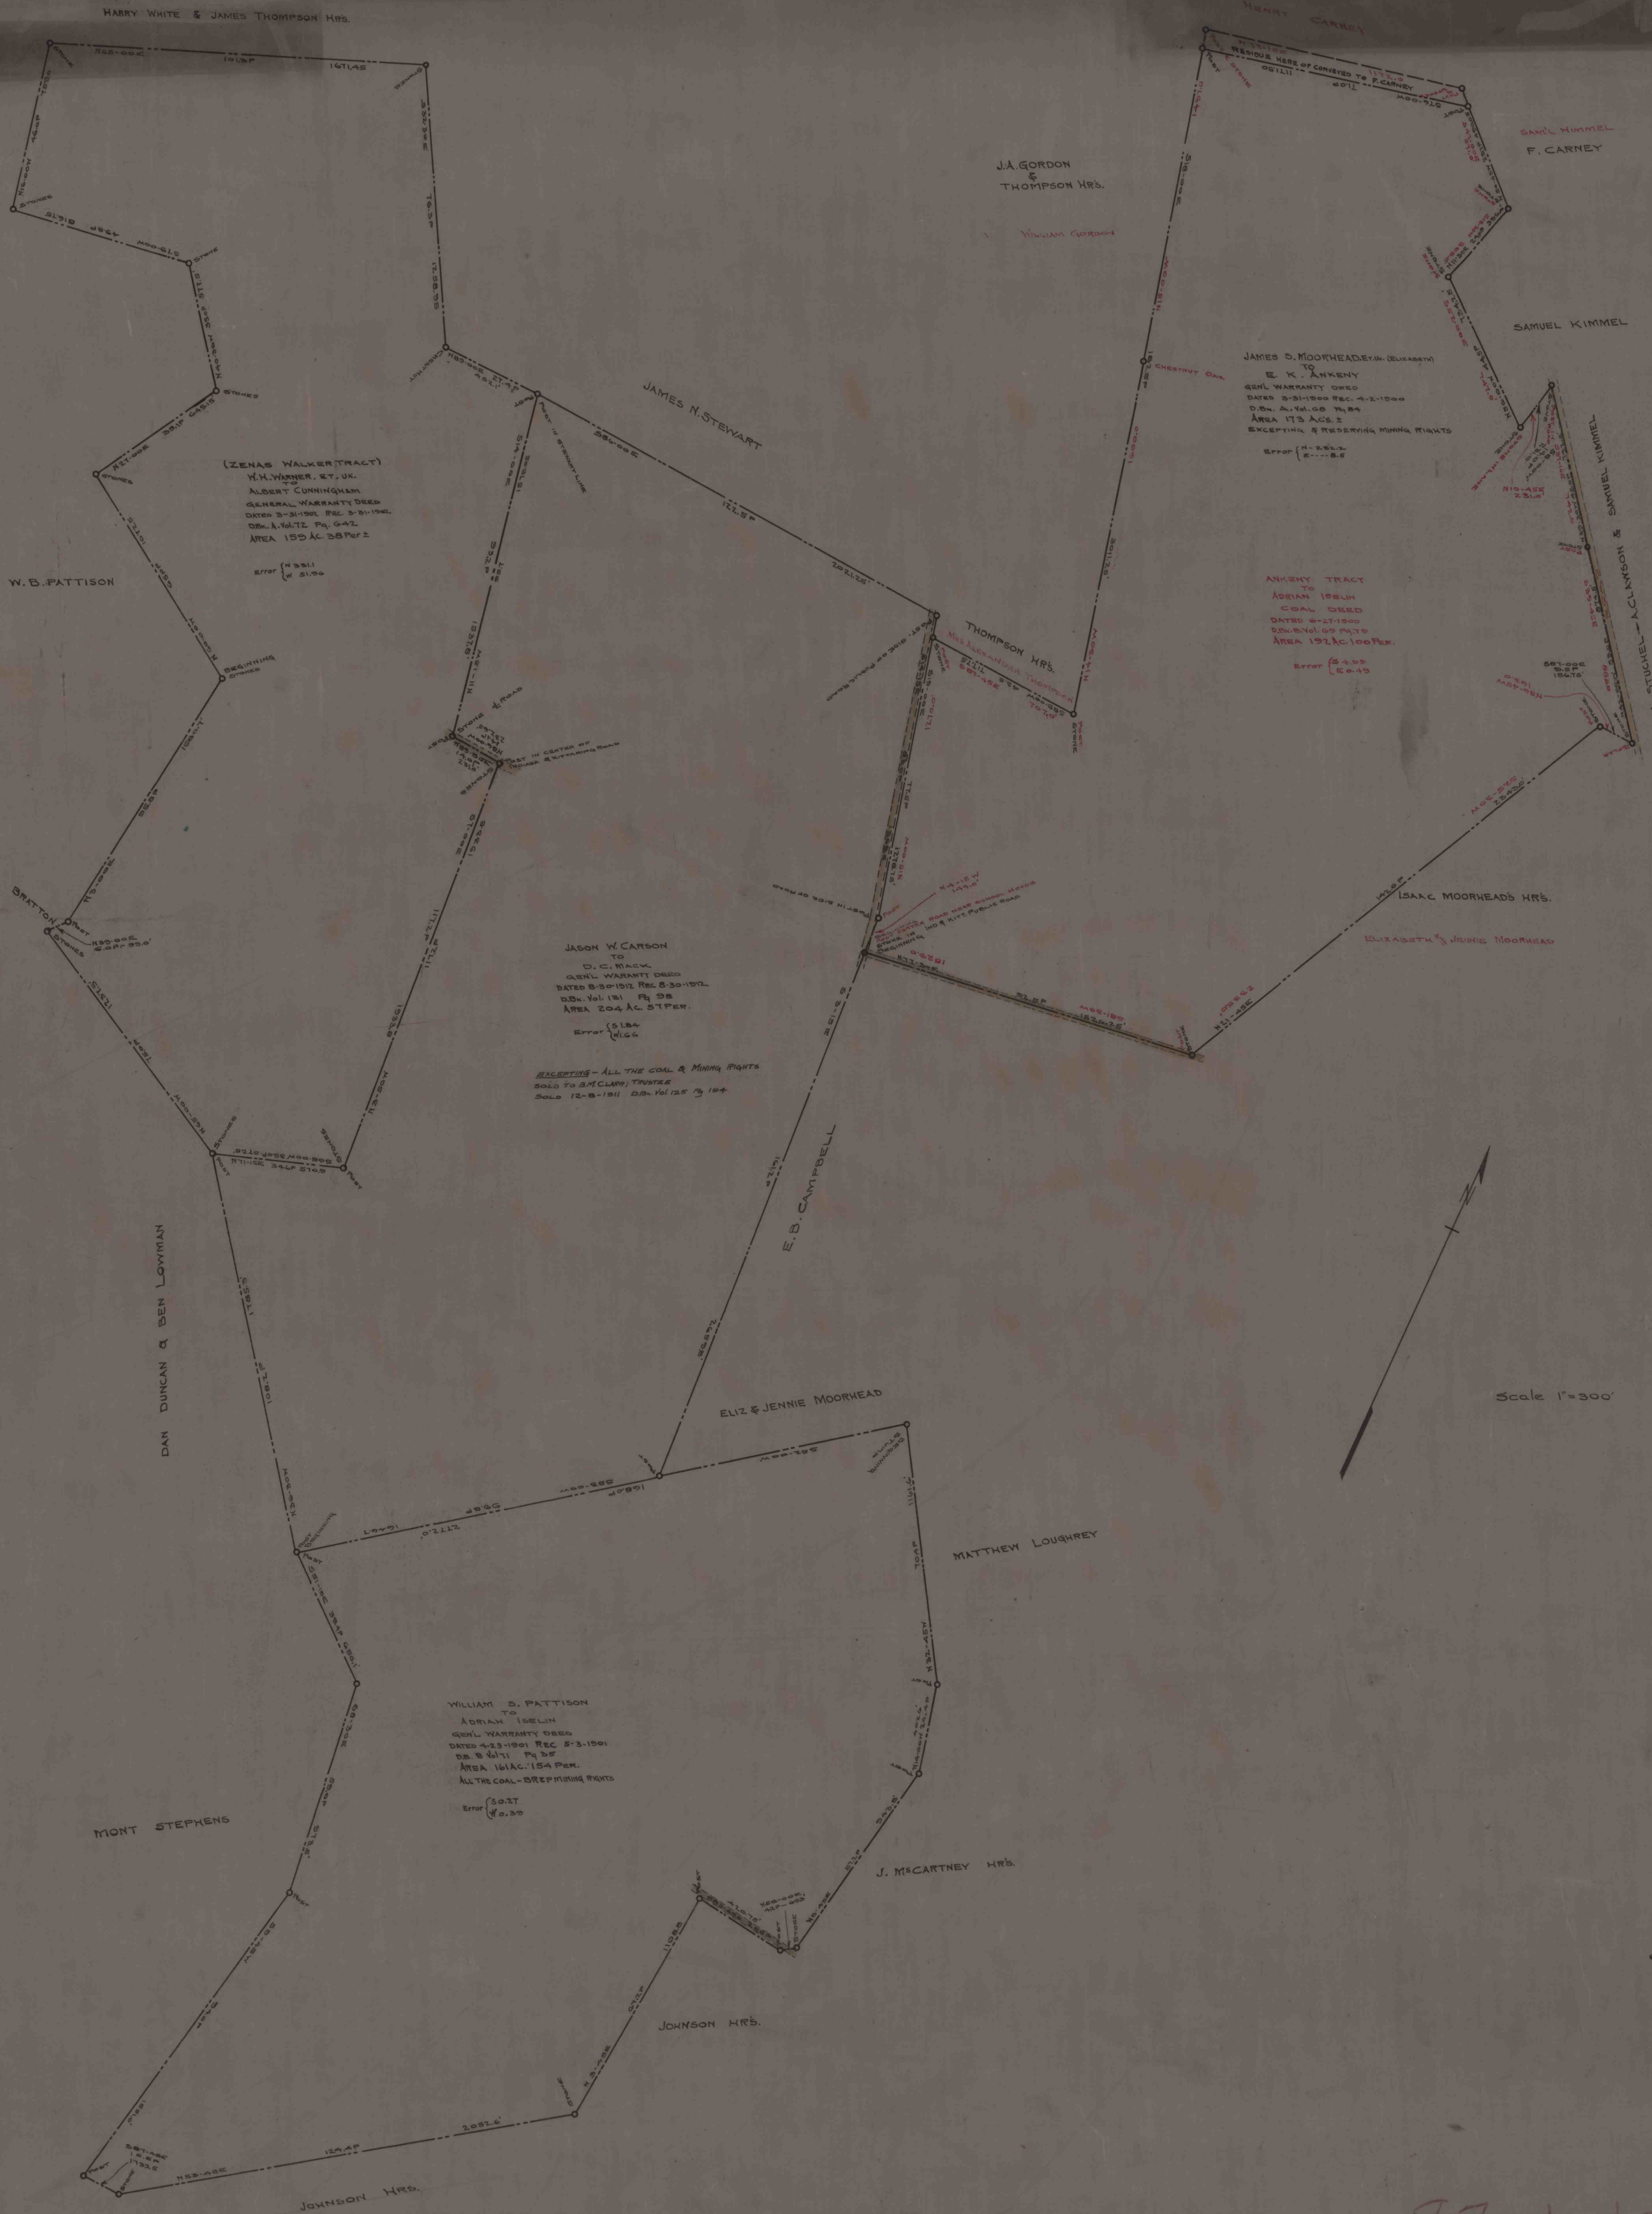

87-1-12